

Augustine J. Della
Zoning Commissioner
of Baltimore County

It is the policy of the Board of Zoning Commissioners of Baltimore County, that the aforesaid special permit be granted for the use of the property for the purpose of a gasoline service station, subject, however, to the filing of a plan with the Zoning Department approved by the Baltimore County Planning Commission and the Department of Public Works, said plan shall show the location of the proposed station and the island for the pumps so as to create a 17 foot widening strip on the south side of Liberty Road to provide a 100 foot right-of-way for said Liberty Road; the pump island to be 12 feet from said widening strip.

[Signature]
John Commissioner
of Baltimore County

1447692

JOHN B. ELLIOTT JR., JR.,
Liberty Bond 325' W. Elgin Rd.
Gasoline service station

2275

PERMISSION FOR SPECIAL PERMIT

#2279-S
Map
2+3A

District: 3rd Date of Posting: 6-5-52
 Posted from: James R. Smith to Capt. Harline Service Station
 Preliminary: James Smith
 Location of Sign: S.S. Smith Rd. 3.54 mi. E. of Ellers Road 4.6 mi. S. of Ellers Rd. 17.25 mi. S. of S. 74th N. 119th E. 65.94 E. 88.63 S. 88.20 N.
 Location of Sign: S.S. along Rd. 400 ft. west of Ellers Road.
 Remarks:
 Reason for Posting: George R. Hummel Date of return: 6-5-52

FILED JUN 9 - 1952

127

June 6th., 1952

TOWSON, MD. 19

THIS IS TO CERTIFY, That the annexed advertisement was published in THE JEFFERSONIAN, a weekly newspaper printed and published in Towson, Baltimore County, Md., ~~XXXXXX~~
~~XXXXXXXXXXXXXXXXXXXX~~ 2 times before
day of 7th day June 1952, the first publication
appearing on the 30th day of May
1952.

Cost of Advertisement, \$

June 18, 1952


\$20.00

RECEIVED of Roland S. Piel the sum of Twenty (\$20.00)
Dollars, being cost of petition of John B. Gaither, Jr., et al,
for a special permit, advertising and posting property, Liberty
Road, 2nd District

Zoning Commission

PAID
JUN 17 52
COUNTY COMMISSIONERS
OF BALTIMORE COUNTY
BY *Fuller*

CURVE DATA					
No.	RADIUS	Δ	ARC	TANG	CHORD
1	70.00	27°23'53"	24.47	18.75	47.69
2	510.00	2°45'02"	23.66	18.00	231.75
3	550.00	2°32'29"	17.75	18.00	177.00
4	530.00	2°54'21"	26.31	18.00	26.31
5	500.00	3°00'00"	10.00	62.76	124.44

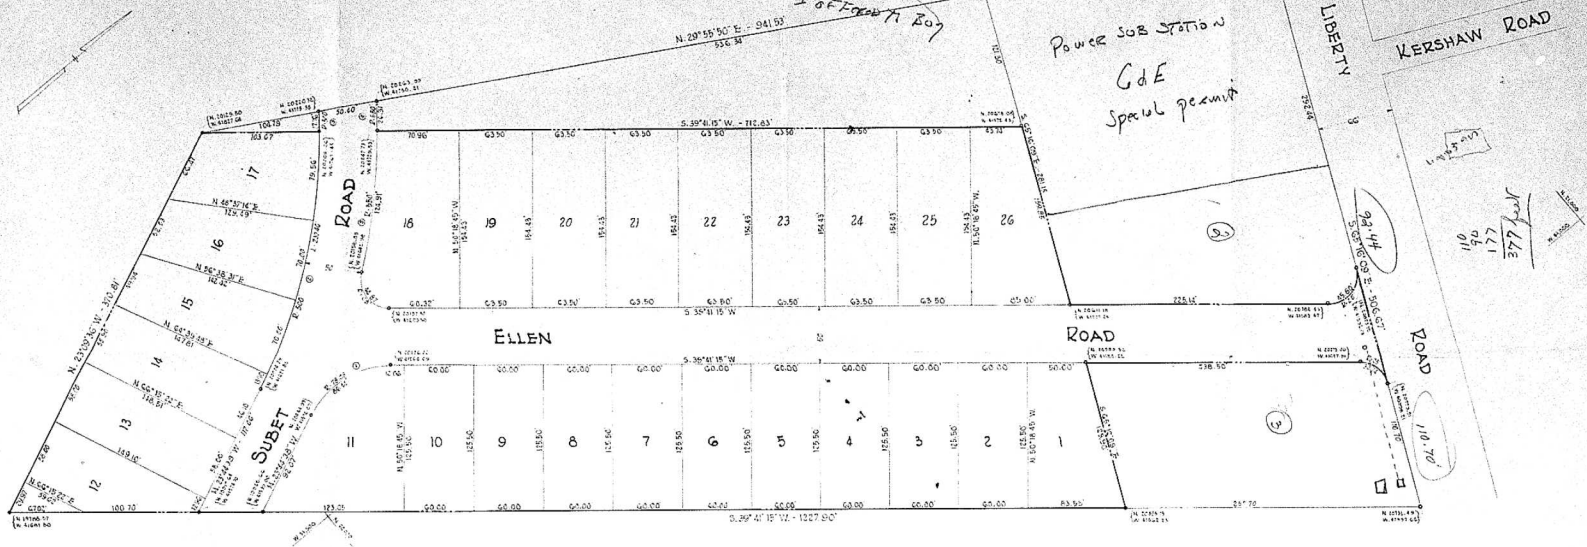

PLAT OF
MILLVALE
SECTION "2"
A DEVELOPMENT OF
JOHN B. GAITHER

2ND ELECTION DIST - BALTIMORE COUNTY, MD.
Scale 1" = 50'

August 16, 1951

GLB # 11 FOLIO 77

NOTE

The requirements of sections 72A, 72B and of Article 17 of the
Annotated Code of Md. 1930 Edition (Title Clerk of Court, Subtitle
Circuit of Circuit Courts) as far as they relate to the making of this plat
and setting the markers have been complied with.

JOHN B. GAITHER, JR.

John B. Gaither, Jr.
Owner of the land shown herein

CW 1018

Registered Professional Engineer and Land Surveyor

NOTE:

The streets and/or roads as shown hereon and the
metes thereof in detail are for the purpose of
description only and the same are not intended to
be dedicated to public use; the fee simple title
thereof is expressly reserved in the grantors of
the lot to which this plat is attached, their heirs
and assigns.

NOTE:

Coordinates Shown On This Plat Are Based On The
Metropolitan District of Baltimore County
Coordinate System.



HIGHWAYS DEPARTMENT OF BALTIMORE COUNTY
APPROVED FOR STREET ALIGNMENT AND WIDTH
BY *John B. Gaither, Jr.* DATE *Sept. 14, 1951*


APPROVED FOR BALTIMORE COUNTY PLANNING COMMISSION
BY *John B. Gaither, Jr.* DATE *Sept. 14, 1951*

THOMPSON, GRACE AND MAVS, INC.
ENGINEERS - CONTRACTORS
FIDELITY TRUST COMPANY BLDG.
TOWSON 4, MARYLAND



PLAT OF LOT ROCKDALE
2ND DIST BALTO CO, MD.
SCALE 1" = 60' MAY 1952

R. C. MOORE, JR.
WOODLAWN, MD.

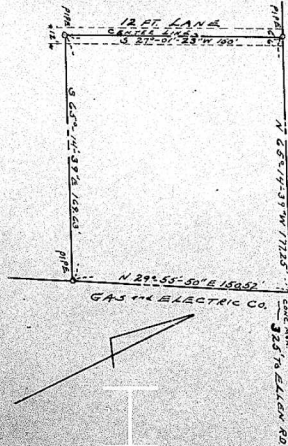

LIBERTY ROAD
66 FT WIDE