

63-68-V PETITION FOR ZONING VARIANCE FROM AREA AND HEIGHT REGULATIONS

TO THE ZONING COMMISSIONER OF BALTIMORE COUNTY:

I, or we, Sherwood Hill Builders, Inc., legal owner, of the property situate in Baltimore County and which is described in the description and plat attached hereto and made a part hereof, hereby petition for a Variance from Section... 205-3.541de. Part 1.

of the Zoning Regulations of Baltimore County to the Zoning Law of Baltimore County; for the following reasons (indicate hardship or practical difficulty):

That through a mistake in the layout, the dwelling was constructed with a side yard on the East side of the lot, of 160 feet at the Northern corner of the house and of 11.90 feet at the Southeast corner of the house, instead of a 15 foot side yard as provided in said section. It would be impossible to move the dwelling without great financial hardship, and physically tearing down the existing construction.

See Attached Description

Property is to be posted and advertised as prescribed by Zoning Regulations.

I, or we, agree to pay expenses of above variance advertising, posting, etc., upon filing of this petition, and further agree to and are to be bound by the zoning regulations and restrictions of Baltimore County adopted pursuant to the Zoning Law for Baltimore County.

Contract purchaser Sherwood Hill Builders, Inc.
Philip G. Tilden Legal Owner
Address 606 York Road - Towson, Md.

Protestant's Attorney
Philip G. Tilden V.P.S. 2173
Address 606 York Rd. - Towson, Md.

ORDERED BY The Zoning Commissioner of Baltimore County, this 22nd day

of July 1963, that the subject matter of this petition be advertised as required by the Zoning Law of Baltimore County, in two newspapers of general circulation throughout Baltimore County; that property be posted, and that the public hearing be had before the Zoning Commissioner of Baltimore County in Room 10, County Office Building in Towson, Baltimore County, on the 22nd day of September 1963, at 10:00 o'clock a.m.



10-08 AM 9/18/63
12:44 PM

Pursuant to the advertisement, posting of property, and public hearing on the above petition and it appearing that by reason of the following finding of facts that the granting of the Variance would grant relief to the petitioner without substantial injury to the health, safety and general welfare of the location involved.

the above Variance should be had, and is hereby appearing that by reason of

for a Variance to permit 110' on the northern corner and 11' on the southern corner should be granted

IT IS ORDERED by the Zoning Commissioner of Baltimore County this 18th

day of September 1963, that the herein Petition for a Variance should be and the same is granted, from and after the date of this order, to permit 110' on the northern corner and 11' on the southern corner instead of the reading 15'.

John G. Rose
Zoning Commissioner of Baltimore County

Pursuant to the advertisement, posting of property and public hearing on the above petition and it appearing that by reason of

the above Variance should NOT BE GRANTED.

IT IS ORDERED by the Zoning Commissioner of Baltimore County, this 18th day of September 1963, that the above Variance be and the same is hereby DENIED.

Zoning Commissioner of Baltimore County

MICROFILMED

BALTIMORE COUNTY, MARYLAND

INTER-OFFICE CORRESPONDENCE

TO: Mr. John G. Rose, Zoning Commissioner Date: September 6, 1963
FROM: Mr. George E. Cervelli, Deputy Director

SUBJECT: #63-68-V. "Variance to permit 8 feet 6 inches on the northern corner and 11 feet 9 inches at the Southeast corner instead of the required 15 feet. North side of Deer Pass Court 310.40 feet East of Topfield Road. Being property of Sherwood Hill Builders.

8th District

RECEIVED: Wednesday, September 13, 1963 (10:00 A.M.)

The Planning staff will offer no comment on the subject petition.

GBH:mas

BLOCK "B" -- LOT NO. 11
"Dunrovin" -- Plat Four

Beginning for the same at a point on the north side of Deer Pass Court 50 feet wide said point being distance 318.49 feet from the east side of Topfield Road thence leaving said Deer Pass Court the three following courses and distances viz: North 28 degrees 29 minutes 46 seconds East-285.56 -- South 58 degrees 00 minutes 00 seconds -- 63.73 feet -- South 18 degrees 18 minutes 09 seconds West -- 278.34 feet to the North side of said Deer Pass Court thence binding on north side of said Deer Pass Court with two curves the first with a curve to the right having a radius of 500.00 feet for an arc length 97.71 feet the second curve is to the left having a radius of 892.33 feet for an arc length of 15.64 to the point of beginning.

CERTIFICATE OF POSTING ZONING DEPARTMENT OF BALTIMORE COUNTY Towson, Maryland

82
District: 8th Date of Posting: 9/2/63
Posted for: Advertising and posting of property for Sherwood Hill Builders
Petitioner: Sherwood Hill Builders, Inc.
Location of property: 606 York Rd. - Towson, Md.
Location of Sign: 606 York Rd. - Towson, Md.
Remarks: Deer Pass Court 310.40 feet East of Topfield Road. Being property of Sherwood Hill Builders.
Posted by: George E. Cervelli Date of return: 9/5/63
Signature: George E. Cervelli

IS THE ONLY ONE THAT COULD BE THIS SIGN
15 FOR POSTER THAT ALL BUYING TOWN - HOUSES

INVOICE
BALTIMORE COUNTY, MARYLAND
OFFICE OF FINANCE
No. 19217
DATE: 7/22/63
To: Sherwood Hill Builders, Inc.
606 York Road
Towson, Md.
Baltimore County
Zoning Department of Baltimore County

EXHIBIT TO ACCOUNT NO.	QUANTITY	DETACH UPPER SECTION AND RETURN WITH YOUR REMITTANCE	TOTAL AMOUNT DUE
61622			\$25.00
Petition for Variance for Sherwood Hill Builders, Inc.			25.00
			25.00

IMPORTANT: MAKE CHECKS PAYABLE TO BALTIMORE COUNTY, MARYLAND
MAIL TO DIVISION OF COLLECTION & RECEIPTS, COURT HOUSE, TOWSON 4, MARYLAND
PLEASE RETURN UPPER SECTION OF THIS BILL WITH YOUR REMITTANCE.

OFFICE OF
THE BALTIMORE COUNTIAN
THE COMMUNITY NEWS
Baltimore, Md.
THE HERALD - ARGUS
Catonville, Md.
No. 1 Newburg Avenue
CATONVILLE, MD.
Sept. 3, 1963.




THIS IS TO CERTIFY, that the announced advertisement of John G. Rose, Zoning Commissioner of Baltimore County was inserted in THE BALTIMORE COUNTIAN, a group of three weekly newspapers published in Baltimore County, Maryland, once a week for One Week successively before the 3rd day of September, 1963, that is to say the same was inserted in the issues of August 30, 1963.

THE BALTIMORE COUNTIAN
By: Paul J. Morgan
Editor and Manager



INVOICE
BALTIMORE COUNTY, MARYLAND
OFFICE OF FINANCE
No. 20113
DATE: 7/21/63
To: Philip G. Tilden, Esq.
606 York Rd.
Towson, Md.
Baltimore County
Zoning Department of Baltimore County

EXHIBIT TO ACCOUNT NO.	QUANTITY	DETACH UPPER SECTION AND RETURN WITH YOUR REMITTANCE	TOTAL AMOUNT DUE
61622			\$33.00
Advertising and posting of property for Sherwood Hill Builders			33.00
			33.00

IMPORTANT: MAKE CHECKS PAYABLE TO BALTIMORE COUNTY, MARYLAND
MAIL TO DIVISION OF COLLECTION & RECEIPTS, COURT HOUSE, TOWSON 4, MARYLAND
PLEASE RETURN UPPER SECTION OF THIS BILL WITH YOUR REMITTANCE.

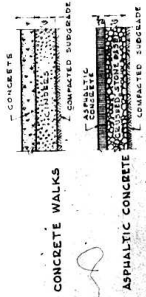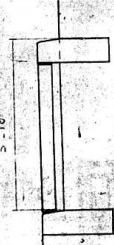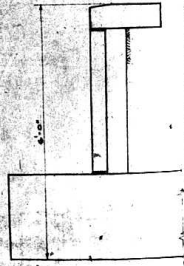

PAVEMENT SECTIONS

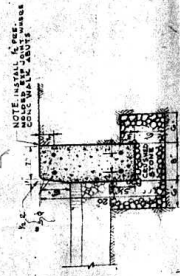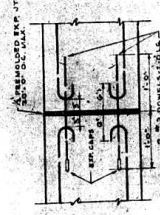


LEGEND


- EXIST. CONTOUR
- PROPOSED CONTOUR
- PROPOSED SPOT ELEVATION
- PROPOSED MANHOLE
- EXIST. CATCH BASIN
- EXIST. PIPE
- EXIST. TIE-TO-BE REMOVED
- EXIST. TIE-TO-BE REMAIN
- EXIST. LIGHT
- NEW OR RELOCATED LIGHT


SECTION

CONCRETE CURB

SCALE: 1"=1'-0"

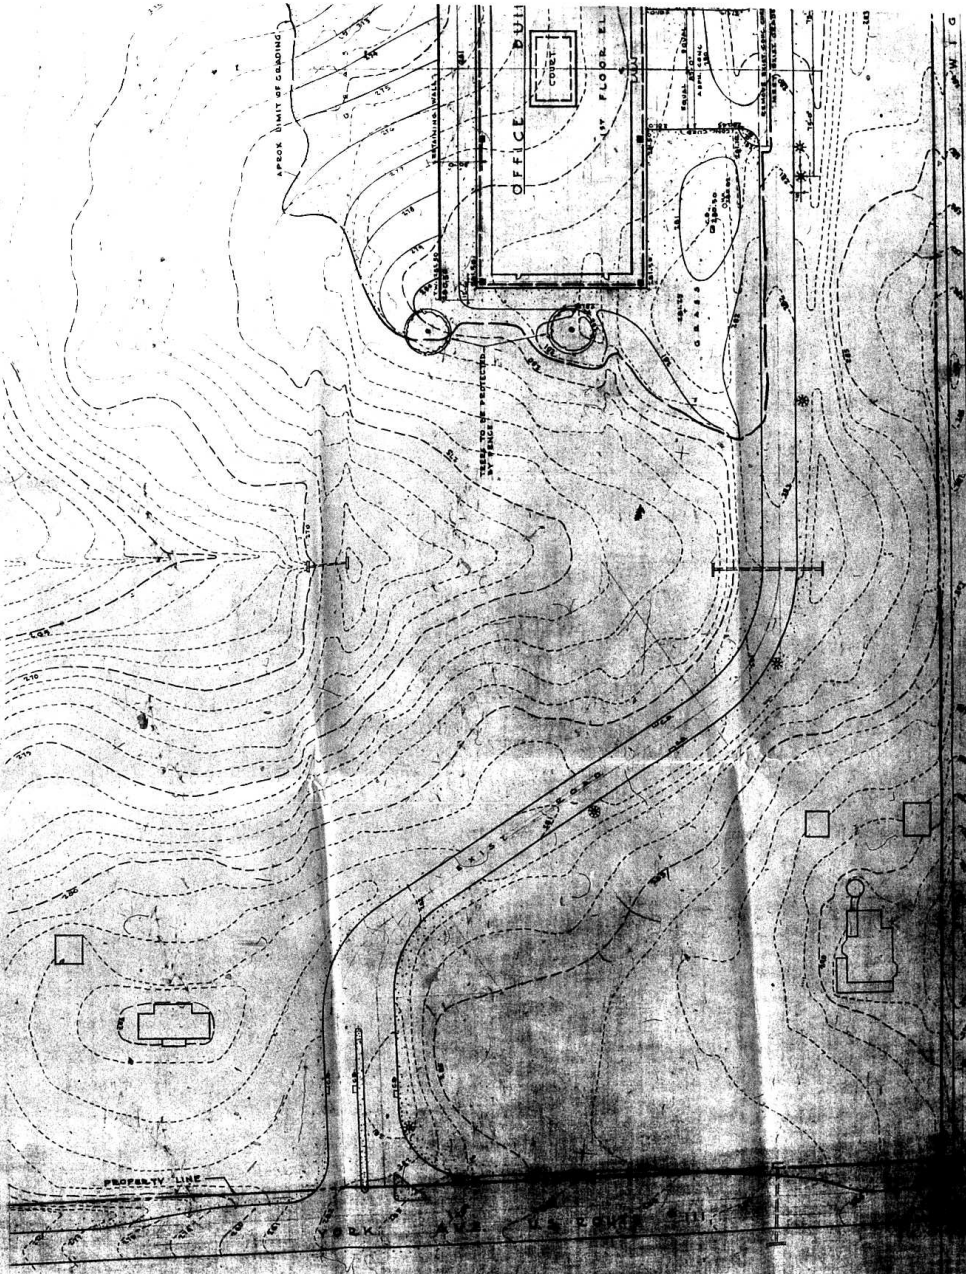

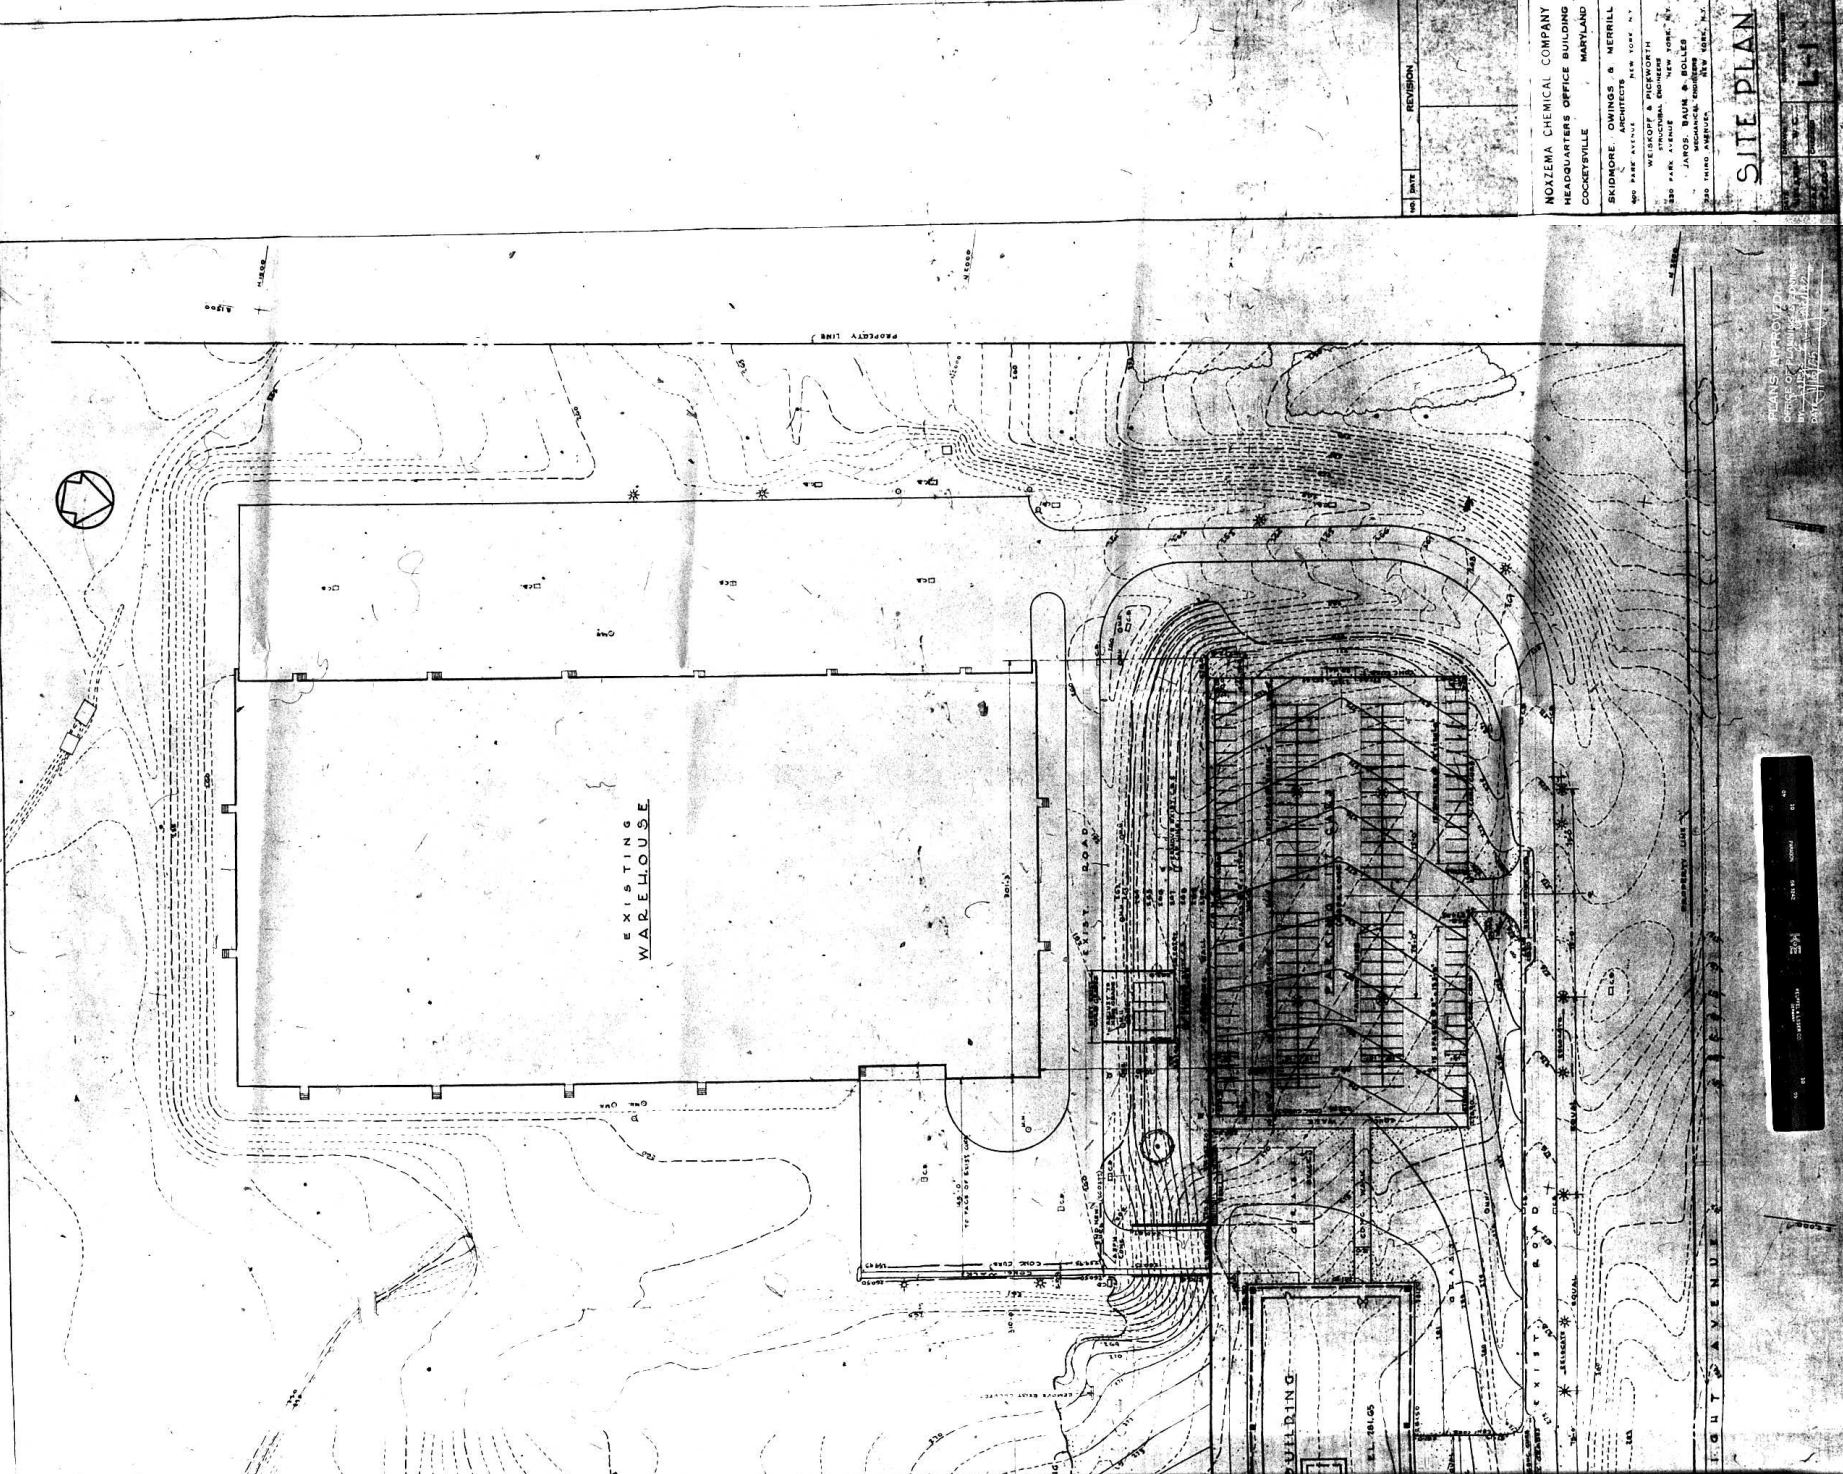

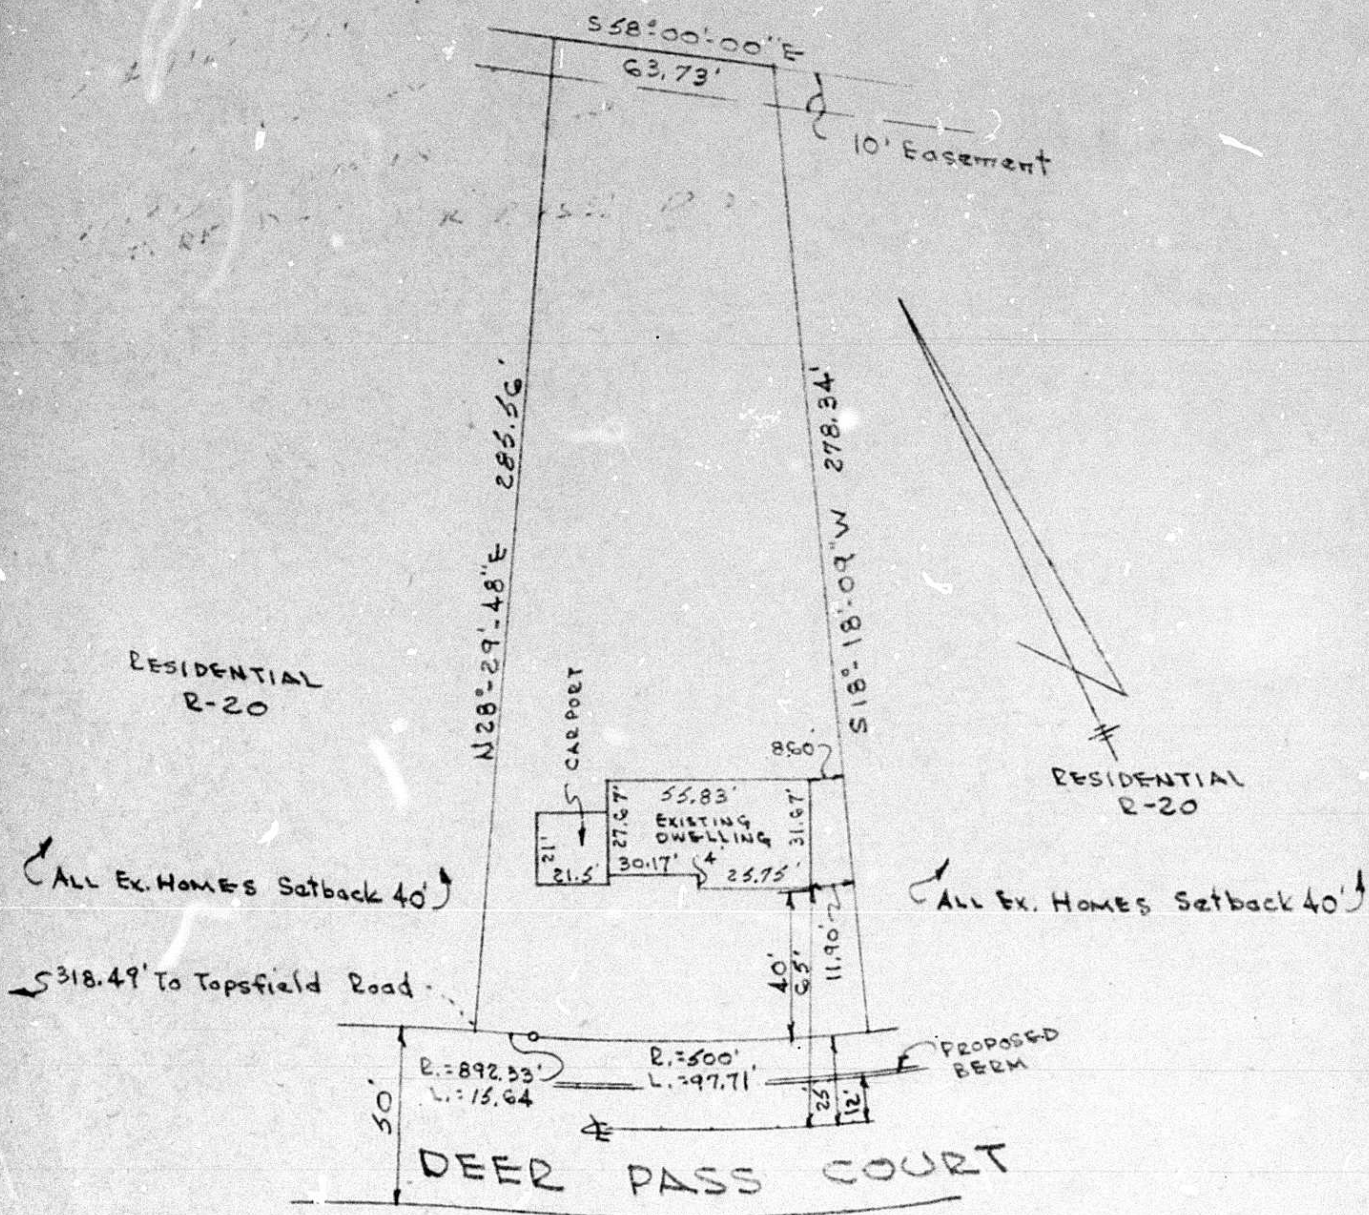

VARIANCES PLAT
 FOR
 BLOCK "E" - Lot No. 11
 PLAT FOUR
 "DUN - ROVIN"

8TH ELEC. DIST. - BALTO. COUNTY, MD.
 Scale: 1" = 50' JULY 15, 1982

MICROFILMED

