


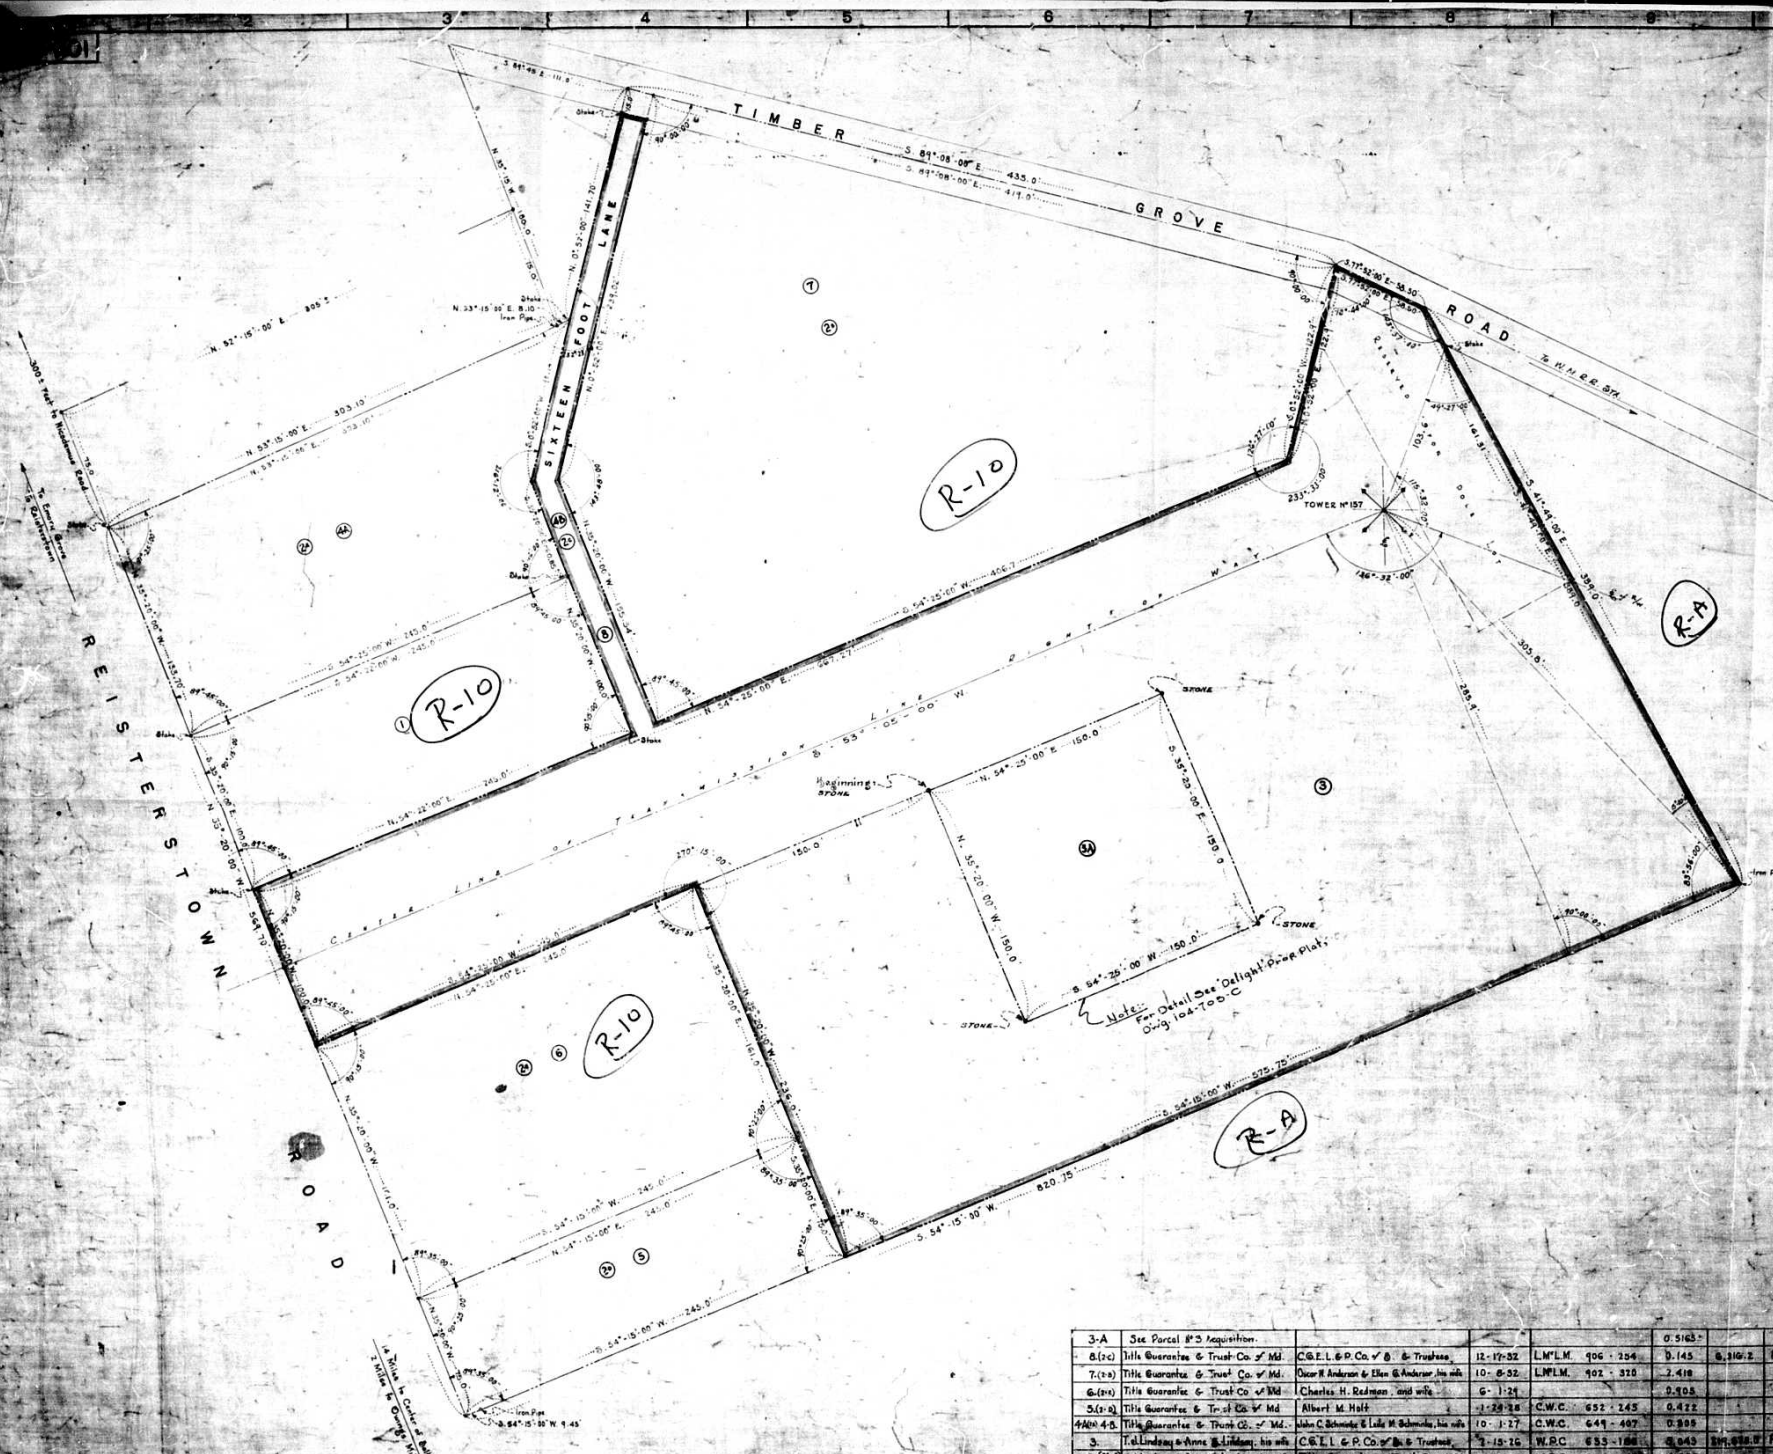

PLANS APPROVED
OFFICE OF PLANNING & ZONING
BY: *[Signature]*
DATE: *10/16/5*
ZONING COMMISSION
DATE: *10/17/5*

PLANS APPROVED
OFFICE OF PLANNING & ZONING
BY: *[Signature]*
DATE: *10/16/5*

NOTES

One half of Timber Grove Road located but not included in area of 10.90 Acres.

Title to Sixteen Foot Lane from C.E.L. & P. Co. was transferred to Timber Grove Road was transferred to this company from Title Guaranty & Trust Co. subject to use in connection with abutting property owned by it. This parcel was transferred to the company after disposal of all excess property and is not included in transfer of parcel 3 (5.643 A).

Bearings and Distances shown in red are from said descriptions in Conveyances.


Location Dimensions for Tower and the Tower Tower Ht 145. New tower Ht 157.25. This parcel was included in the same approximate location.

Based on Transmission Line Right of Way returned to the True Meridian.




NO.	GRANTOR	GRANTEE	DATE	ACRES	PRICE	REMARKS
3-A	See Parcel #3 Acquisition.					
8(1c)	Title Guaranty & Trust Co. of Md.	C.E.L. & P. Co. & Trustee	12-17-52	1.145	0.5163	Ac. defined as 8th Sta. P.
7(1a)	Title Guaranty & Trust Co. of Md.	Osceola Anderson & Ellen & Anderson, his wife	10-6-52	1.418	0.5163	Ac. defined as 8th Sta. P.
6(1a)	Title Guaranty & Trust Co. of Md.	Charles H. Redman, and wife	6-1-24	2.905		For Sample: part 2 of Parcel 2.
5(1a)	Title Guaranty & Trust Co. of Md.	Albert M. Hall	1-29-28	0.472		For Sample: part 2 of Parcel 2.
4(1a)	Title Guaranty & Trust Co. of Md.	John C. Schwab & Lady M. Schwab, his wife	10-1-27	0.398		For Sample: part 2 of Parcel 2.
3	Ted Lindsay & Anne & Lindsay, his wife	C.E.L. & P. Co. & Trustee	7-15-26	0.043		For Sample: part 2 of Parcel 2.
2(1a)	Ted Lindsay & Anne & Lindsay, his wife	Title Guaranty & Trust Co. of Md.	7-15-26	0.043		For Sample: part 2 of Parcel 2.
1	Ted Lindsay & Anne & Lindsay, his wife	John C. Schwab & Lady M. Schwab, his wife	4-3-28	0.043		For Sample: part 2 of Parcel 2.
1 & 2	Ted Lindsay & Anne & Lindsay, his wife	Ted Lindsay & Anne & Lindsay, his wife	4-3-28	0.043		For Sample: part 2 of Parcel 2.

ELECTRIC
PROPER
GALLAGHER
ON EAST SIDE OF

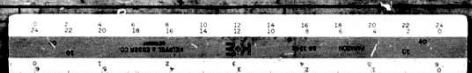

PLANS APPROVED
OFFICE OF PLANNING & ZONING
BY: *[Signature]*
DATE: *10/10/65*
BY: *[Signature]*
DATE: *10/10/65*

PLANS APPROVED
OFFICE OF PLANNING & ZONING
BY: *[Signature]*
DATE: *10/10/65*

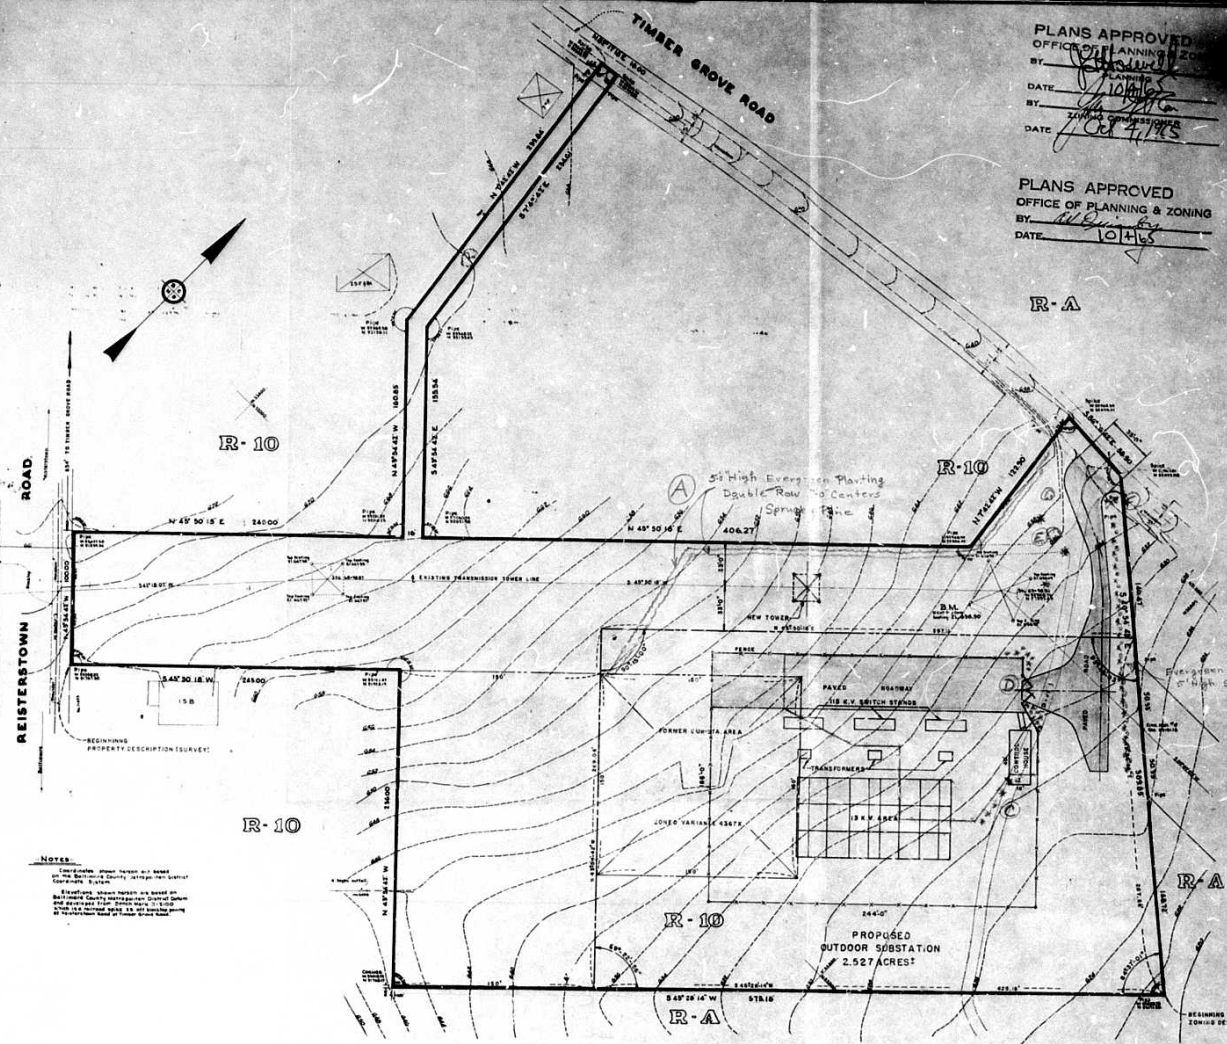

NOTES:
1. The location of the tower is based on the Baltimore County Survey Map of 1964.
2. The location of the tower is based on the Baltimore County Survey Map of 1964.
3. The location of the tower is based on the Baltimore County Survey Map of 1964.

ZONING PLAT OF PROPERTY OF
BALTIMORE GAS & ELECTRIC CO.
4TH EIGHTH DIST. BALTIMORE, MD.
SCALE: 1" = 100' OCT 18, 1964

JAMES E. SPANER & ASSOCIATES
ENGINEERS & ARCHITECTS
415 FREDERICK STREET
BALTIMORE, MD. 21204
The O'Kall of

