


GEG-hms

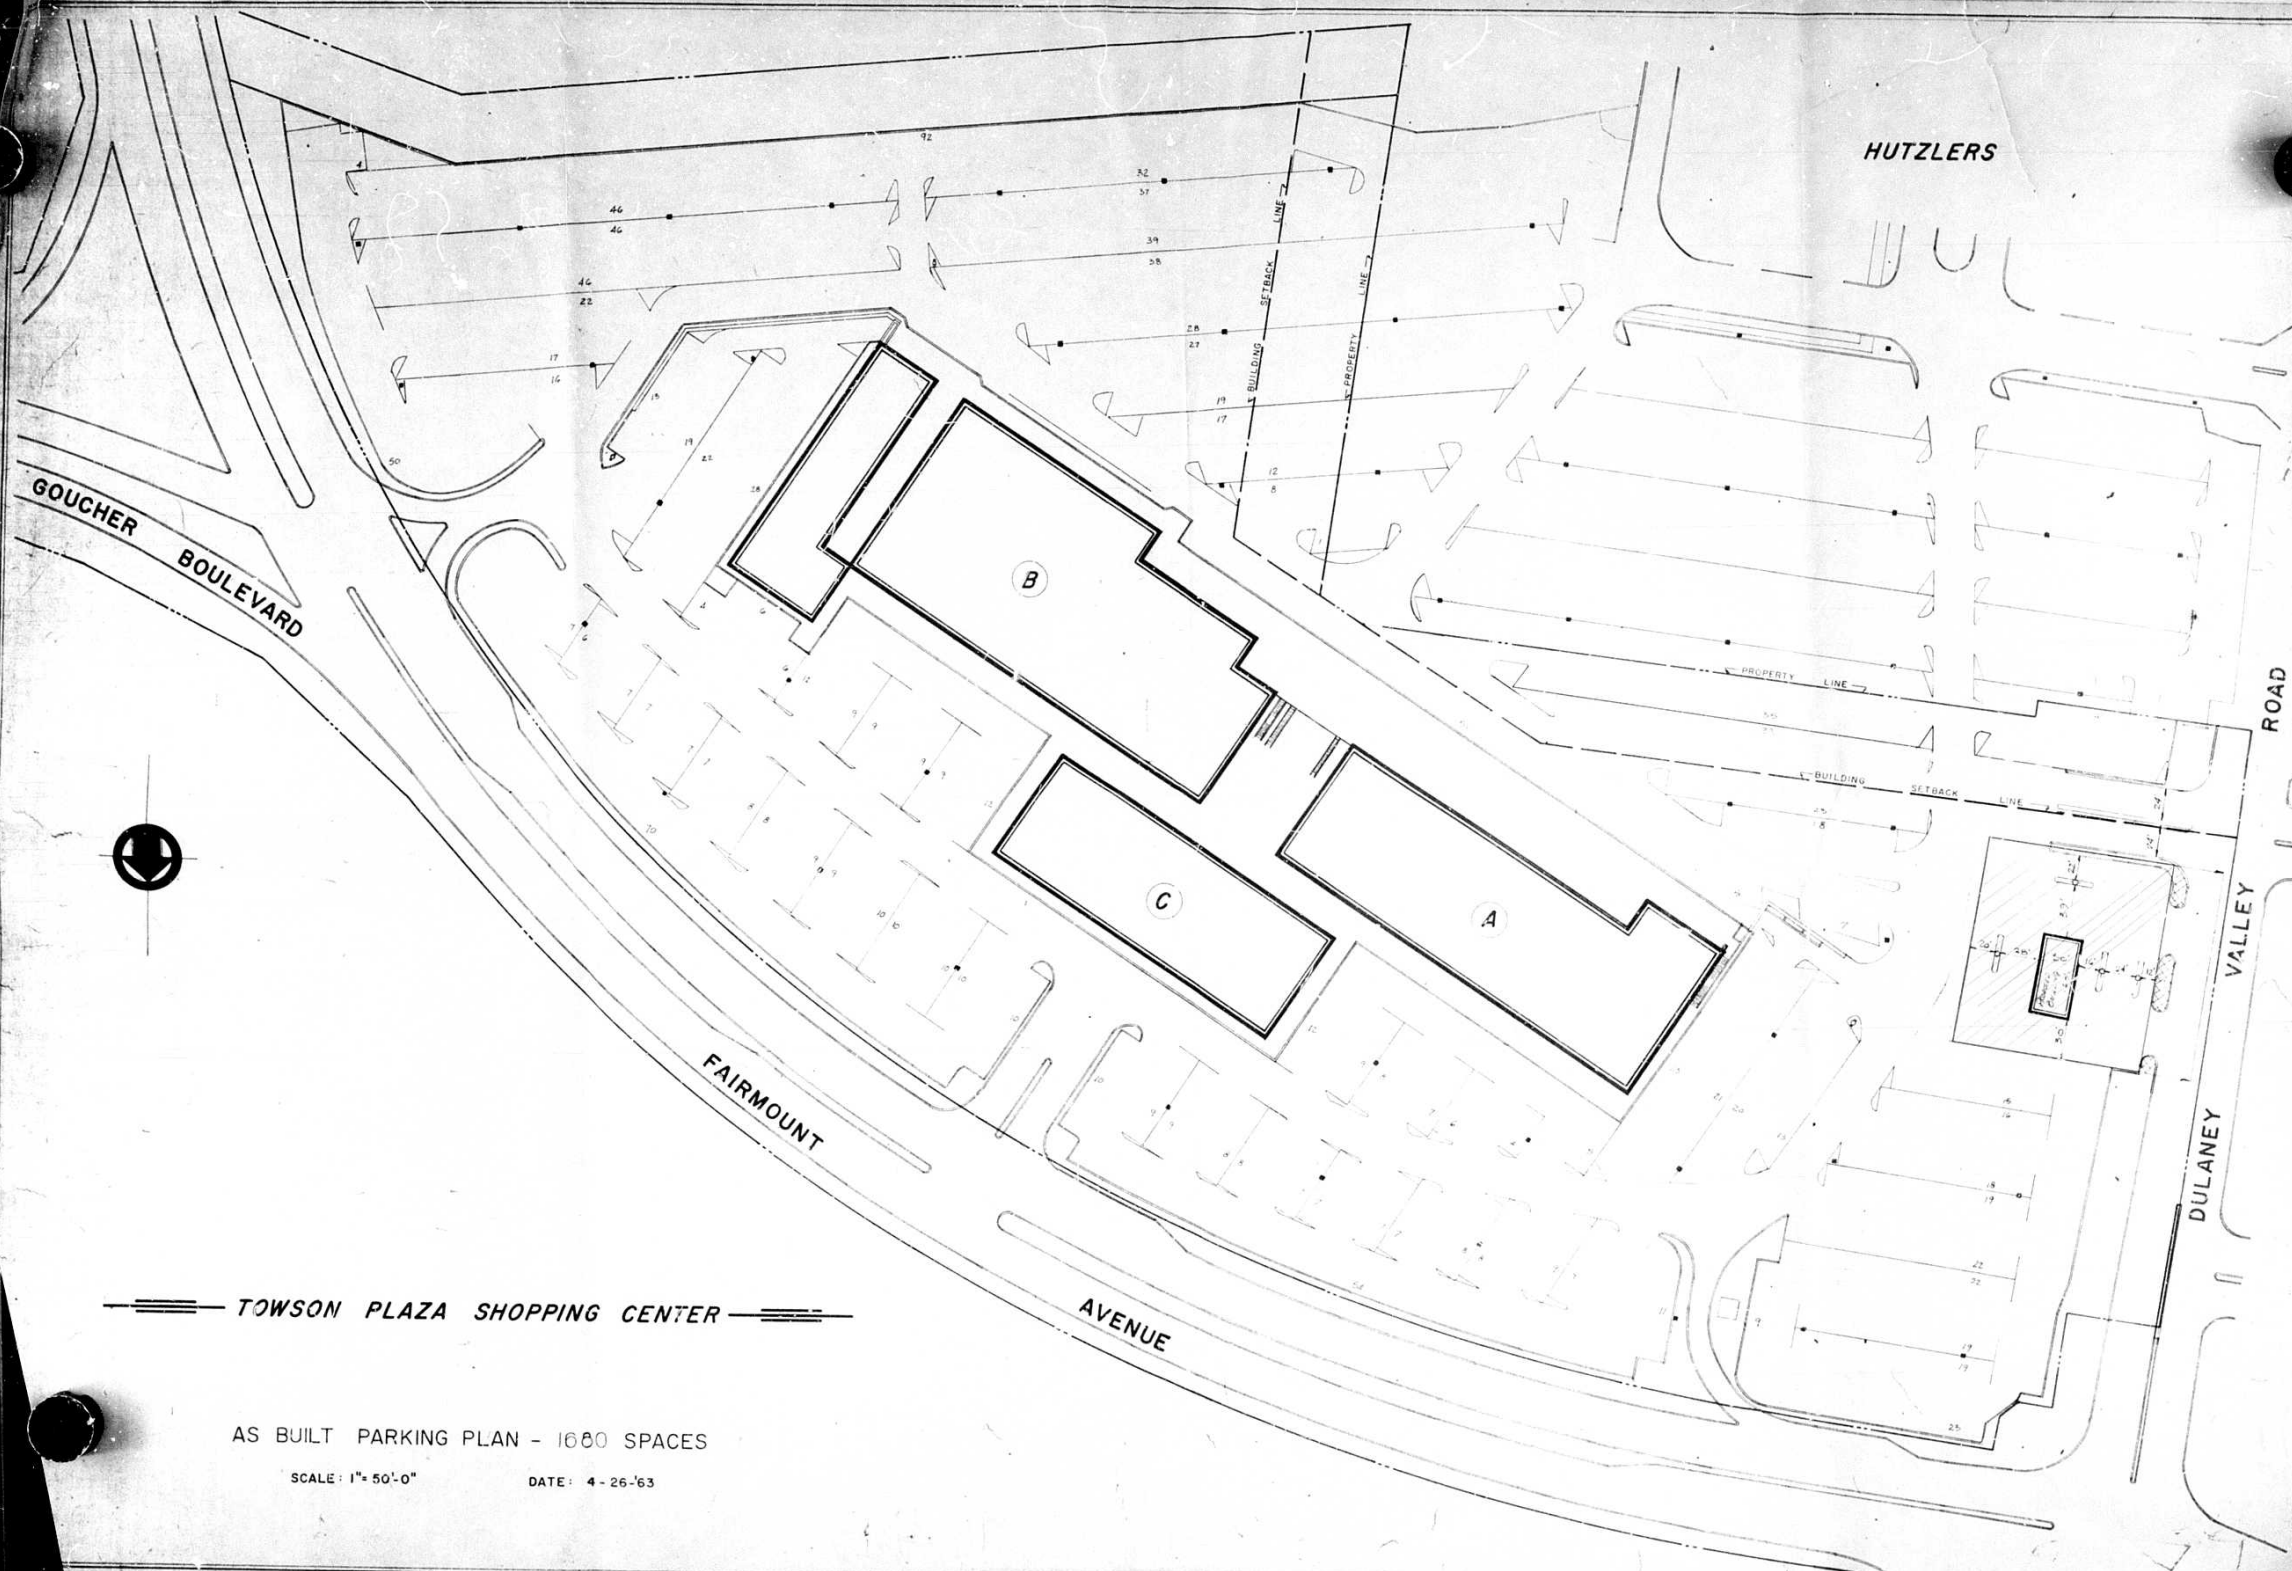

HUTZLERS

GOUCHER BOULEVARD

FAIRMOUNT AVENUE

DULANEY VALLEY ROAD

B

C

A

TOWSON PLAZA SHOPPING CENTER


AS BUILT PARKING PLAN - 1000 SPACES

SCALE: 1"= 50'-0"


DATE: 4-26-63



EXISTING TOWSON PLAZA SHOPPING CENTER
COMMERCIAL PROPERTY ZONED B-M

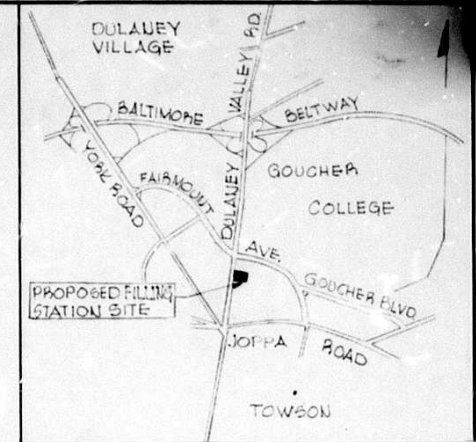

VICINITY MAP
Scale: 1" = 0.5 Mi.

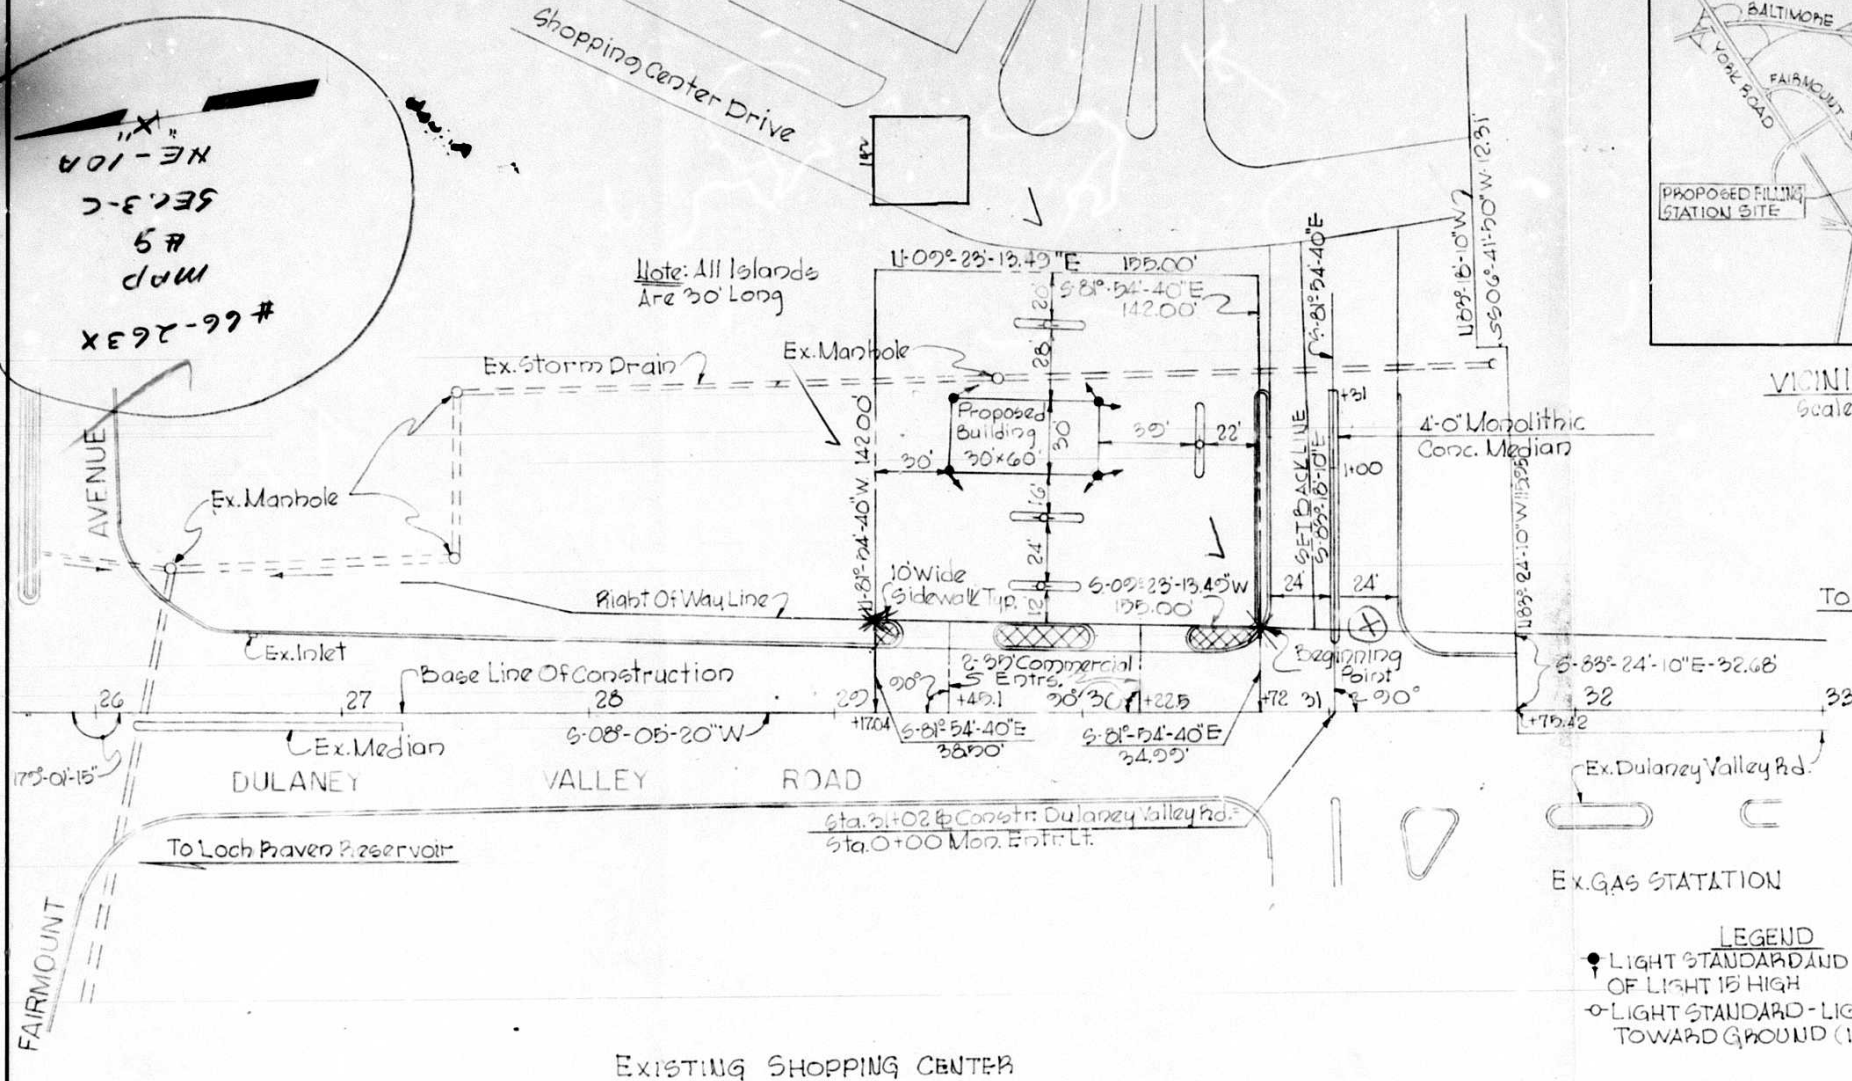

#66-263X
MAP
#9
SE13-C
NE-10A
"X"

- LEGEND
- LIGHT STANDARD AND DIRECTION OF LIGHT 15' HIGH
 - LIGHT STANDARD - LIGHT DIRECTED TOWARD GROUND (12' HIGH)

EXISTING SHOPPING CENTER

ZONING PLAT

for

PROPOSED FILLING STATION

TOWSON PLAZA SHOPPING CENTER

ELECTION DISTRICT NO. 9, BALTIMORE COUNTY, MD.

Scale: 1" = 50'

Notes:

1. Property Outlined in Red Now Zoned To Be Granted A Special Exception For Use As A Filling Station Site
2. Property Contains 0.205 Acres. Existing Ground Slope Is Approx. 4.0%

