I, or we Delbert L. Fowler leg-i owner of the property situate in Baltimore County and which is described in the description and plat attached hereto and made a part hereof, hereby petition (1) that the zoning status of the herein described property be re-classified, purs at to the Zoning Law or Baltimore County, from an.....

.....tone; for the following reasons:

See attached description

Mop #143 Eostern Avea NE 1-G 11 X'

and (2) for a Special Exception, under the said Zoning Law and Zoning Regulations of Baltimore County, to use the herein described property, for living quarters in a compersial 1909.

Property is to be posted and advertised as prescribed by Zoning Regulations.

I or we, agree to pay expenses of above re-classification and/or Special Exception advertising. posting, etc., upon filing of this petition, and further agree to and are to be bound by the roaing posting, etc. upon ming of this plaintore County adopted pursuant to the Zoning law for Baltimore

Contract purchase Petitioner's Attorney

Questit y franche Address 205 Eastern Av Bolto 21721

Protestant's Attorney

OPDERED By The Zoning Commissioner of Baltimore County, this 24th required by the Zoning Law of Baltimore County, in no newspapers of general circulation through-out Baltimore County, that property be posted, and that the rublic hearing be had before the Zoning Comalisationer of Baltimore County in Room 106, County Office Building in Towson, Baltimore

day of March 196 9 at 10:00 clock County, on the 24th

Zoning Commissioner of Baltimore County.

it appearing that by reason of the requirements of Section 502, 1 of the Baltimore County Zening Regulations having seen met. constant by the hard-careful further appearing that hyperasons of a

ant to the advertisement, posting of property, and public hearing on the above petition and

a Special Exception for a Living Quarters in a Commercial Building should be granted.

day of March 196.9., hink the head scheenbook property see arone should be and

soor, and as a Special Exception for a Living Quarters in A Connactorial and the same is mercial Building granted, from and after the date of this order, subject to approval of the site plan by the State, Roadis Commission, the Bureau of Public Services and the Office of Planning and Zoning.

DEPUTY Zoning Commissioner of Buildings Comp ertiscment, posting of property and public hearing on the above petition

earing that by reason of ...

therabove re-classification should NOT BE HAD, and/or the Special Exception should NOT BE

IT IS CEDERED by the Zoning Commissioner of Baltimore County, this.... 195 that the above re-classification be and the same is hereby DENIED and that the above described property or area be and the same is hereby continued as and ... zone; and/or the Special Exception for...

Zoning Commissioner of Baltimore County

MICROFILMED

Febr uary 17, 1969

RE: Type of Hearing: Special Exception for Itving quarters in a commercial zone Location: SE/S Eastern Ave., 100' SW/S of Holana Ave., Petitioner: Bolart L. Fowler Committee Meeting of Feb. 4th, 1969 Item 176

BALTIMORE COUNTY, MARYLAND

INTER-OFFICE CORRESPONDENCE

TO. Mr. John 3, Kose, Zoning Commissioner Date March 14, 1969

FROM George E. Gavrelis, Director of Planning

Petition #69-195-X. Special Exceptio.: for Living Quarters in a commercibuilding. Southeast side of Eastern Avenue 100 feet Sout.west of Helena Avenue. Delbert L. Fowler, Petition.r.

Monday, March 24, 1969 (10:00 A.M.)

The planning staff of the Office of Planning and Zoning will offer no

- MAD 1 / 100 DM -And O To

m Avenue , Md. 21221

BALTIMORE COUNTY OFFICE OF PLANNING AND ZONING

Your Petition has been received and accorded for filing this

Petitioner Hr. Delbert L. Forler

BALTIMORE COUNTY ZONING ADVISORY COMMITTEE

Mr. Delbert L. Fowler 205 Eastern Avenue

BUREAU OF ENGINEERING:

Baltimore, Maryland 21221

#64-195X SURVEYORS AND CIVIL ENGINEEPS 4200 ELSHODE AVENUL / BALTIMORE, MD. 21214 (301; 426-2)44 EASTER

NE-1-6

"X

January 10 1969. DESCRIPTION OF 205 EASTERN AVENUE FOR SPECIAL EXCEPTION FOR A RESIDENCE IN A BUSINESS LOCAL ZONE

HAGAN & HOLDEFER, INC.

BEGINNING for the same at a point on the southeast side of Eastern Avenue, distant 100 feet measured southwesterly from its intersection with the southwest side distant 100 foot measured southwesterly from its intersection with the southwest give of fishers Average, these learning eatingless of beginning and running and binding on the southwest side of Eastern Avenue South 61 degrees 15 similes West Soffent, thence leav-ing eath southeast side of said avenue and/v ving the 3 following sources and distance, vits South 25 degrees 45 minutes East 125 feet to a point, thence North 61 degrees 15 similes East 30 feet to a point, thence North 28 degrees 45 minutes West 135 feet to the place of beginning.

Containing 0.143 acres of land, more or less.

Being lots No. 69 and 70 as laid out and shown on the Plat of Section 2 mt. Holly Terrace; recorded among the Land Records of Baltimore County in Fint Book W.P.C. No. 8 folio 25.

> Note: This description has been prepared for coming purposes only and is not intended to be used for convergnce.



Highways: Eastern Boulevard is a State Road.

Oliver L. Nyers

BUREAU OF ENGINEERING

TE ROADS COME BUREAU OF

PROTECT PLANNING

BOARD OF EDUCATION

ZONING ADDRESS

BUREAU OF TRAFFIC ENGINEE

Storm Drains: The Applicant must provide necessary drainage facilities (temporary or otherwise) to prevent creating any nuisances or damages to adjacent properties, especially by the concentration of surface waters. Correction of any problem which may result, due to improper gracing or other drainage facilities, would be the full responsibility of the Applicant.

The Loning Advisory Committee has reviewed the plans submitted with the above referenced petition and has made an on site field inspection of the property. The following comments are a result of this review and inspection.

The subject property is presently improved with a two story frame dwelling, 30 years old, in fair repair. The property to the east is improved with a High's Store.and a WTW Hall. To the west with a Hatlomide Insurance Company and peckage goods store. To the north are service Lations and several other stores. To the rear is strictly residential homes, one and a half to two story frame dwellings, 10 to 15 years old, in good repair. The strictly residential homes, the strictly residential homes, the composition of the property immediately to the wast.

Mater: There is an existing 12-inch water main in Eastern Boulevard. (See Drawing 25-0023 (3).

Sewers There is an existing 8-inch sanitary sewer in Eastern Boulevard (See Brawings 37-225, A-10 and 37-208, A-10).

- Page 2 -

Mr. Delbert L. Fowler 205 Eastern Avenue Baltimore, Haryland 21221 Item 176

PROJECT PLANNING CIVISION: Depending on the intensity of the use, the driveway is inadequate for access to the parking in the rear.

BUREAU OF TRAFFIC EMGINEERING: On the date of inspection, the parking spaces in the rear were being used to store a yacht. Therefore, provisions must be for workable parking spaces for vehicles.

MEALTH DEPARTMENT:
Public water and sewers are available to the site.

Air Pollution Comments: The building or buildings on this site may be subject to registration and compliance with the Naryland State Health Air Pollution Control Regulations. Additional Information may be obtained from the Division of Air Pollution, Beltimore County Department of Health.

FIRE DEMARTMENT: Fetitioner shall be required to meet Fire Department regulations pertaining to elteration of this building at time zoning is granted.

BUILDING ENGINEER'S OFFICE: This building must be made to conform with Building Code, and a Change of Occupancy must be made.

BOARD OF EDUCATION: No affect on school population.

STATE ROADS COMMISSION: The plan indicates an entrance of 8° in width. The minimum width for a

An on-Lite inspection revealed that there is an entrance which appears to be used in common with the adjacent property to the west (package goods store). The entrance is 30 ft, wide within the State Roads Commission Right of tay.

We have no objection to this arrangement but the plan should be revised to show the extrance as it presently exists.

ZONING ADMINISTRATION DIVISION:

The plan must be revised in accordance with the State Roads Commission comments above. Also, while the petitioner is revising the site plan, he should indicate what type of showroom and office will be proposed for the subject property.

OLIVER L. HYERS, Chairman

ESSEX LIMIS ESSEX, MD. 21221 Merch 10,

THIS IS TO CERTIFY, that the annexed advertise John G. Rose, Zoning Commissioner of Beltimore County

Control Control Poses 104, Control Con

FREEDRICK STATES AND THE STATES AND

Worth 61 degrees 15 minutes that to a point, thence North was 45 minutes West 125 feet ace of segion, one. Asias 0,143 acres of land.

No. 69 and 70 as tal

EXCEPTION FUR SPECIAL EXCEPTION — 13th DISTRICT

DANISO Politico de Seraito Ecopotico de Cartera lo
maio Living Constera lo
maio Living Constera lo
maio Living Constera lo
maio Living Constera lo
COCATION. Socializati del
facilità del Constera lo
construire del
con

rathic hearing: will held a Pelition for h wriat Exception for lying Quarters in a commercial

stiding.
All that periel of land in the discernith District of Ballimore

was inserted in THE ESSEX TIMES, a weekly newspaper published in Ballimore County, Maryland, once a week for One

week before the 10th day of Merch, 1969 that is to as was inserted in the issue of Karoh 6, 1969.

STROMBERG PUBLICATIONS, Inc.

By Buth morgan

CERTIFICATE OF PUBLICATION

TOWSON, MD. MAR. 6 1963 19. THIS IS TO CERTIFY, that the annexed advertisement was published in THE JEFFERSONIAN, a weekly newspaper printed of one time Excessive weaks before the ... 21th day of __March____

..... 19_62., the acce publication appearing on the 5th day of Earsh 19.60

> THE JEFFERSONIAN. H. Frank Str

CERTIFICATE OF POSTING DEPARTMENT OF BALTIMORE COUNTY

#69-195X


District 15 M. Posted for Helding Manday March 39, 1949 C. 10.00 Rd. Date of Posting Mout 6" 69 Location of property SE/S of Carlon Ole 100' SW of Below on Location of Signe Longin Portal on Property believer Migle & Ligerar Stare. Posted by Sent No Muse Date of return Massel 12 -69


> BALTIMORE COUNTY, MARYLAND OFFICE OF FINANCE

Birrao

COURT HOUSE
TOWSON, MARYLAND 2204

IMPRITART, MAKE CHECKS PAYABLE TO CALTUNORE COUNTY, MARYLA

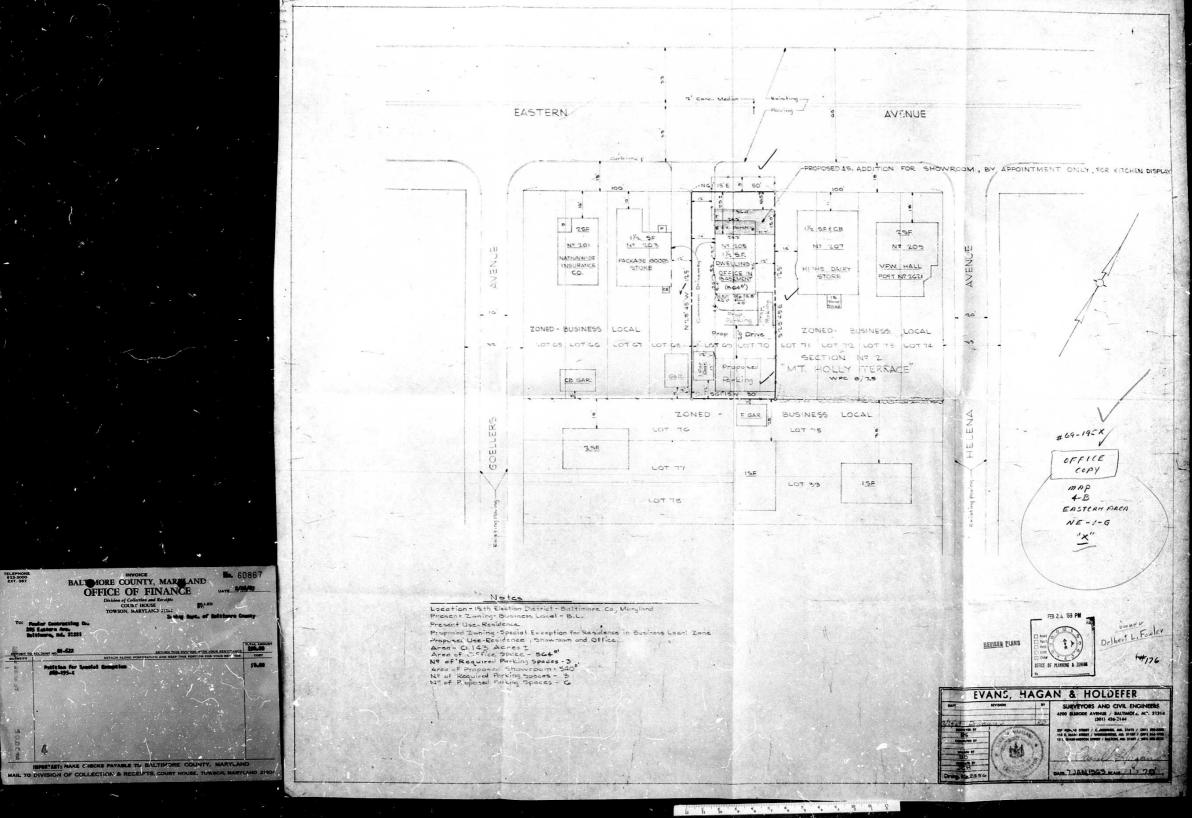

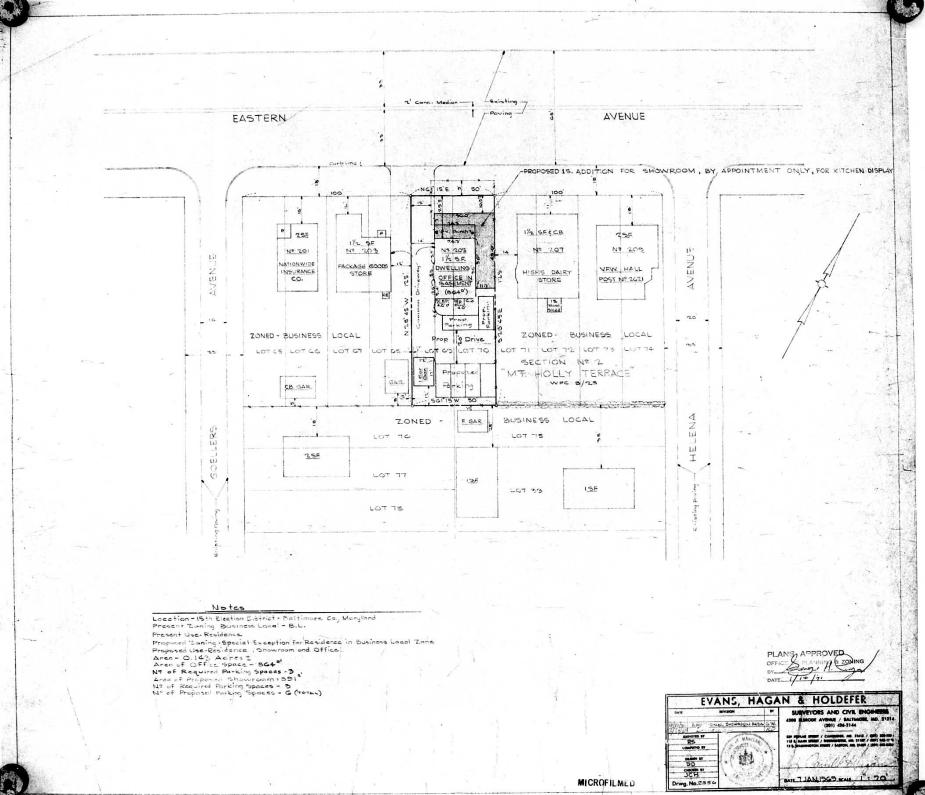

: 11.

1, 4, 5, 6, 7, 4, 7,