### PETITION FOR ZONING RE-CLASS... LATION 70-217-R AND/OR SPECIAL EXCEPTION

TO THE ZONING COMMERSIONER OF BALTIMORE COUNTY:

Barnese A. Miller

1 or we\_Joseph\_Ge\_Miller\_RDd/...legal owner... of the property situate in Baltim County and which is described in the description and pitzt disturbed storeto and made a part haylor, & & / hereby position (1) that the seeing status of the herein described property to re-classified, pursuant SE. 2-R 

25

County, to use the herein described property, for ....

Property is to be posted and advertised as prescribed by Zoning Regula

I, or we, agree to pay expenses of above re-classification and/or Special Exception advertising, sting, etc., upon filing of this petition, and further agree to and are to be bound by the soning

Joseph S. Mille Forms Q. Skeller and Some David D. Downer 212 Mashington Avenue Towson, Maryland 21204 mer of Baltimore County, this 9th

, 19670, that the subject matter of this petition be advertised, as required by the Zoning Law of Baltimore County, in two newspapers of general circulation throughout Baltimore County, that property he posted, and that the public hearing be had before the Zoning Commissioner of Baltimore County in Room 106, County Office Building in Towson, Baltim County, on the 25th day of May 19870, at 2100 o'clock

MAR 9-70 PM OFFICE OF PLANTING & Z

FILING

FOR RECEIVED

35/25/70 lour

24 of 100

Merchanian 575-2521 minn.

EDWIN J. KIRBY AND ASSOCIATES

YORK - ENGINEERS - PLAINERS MATERIANNE ASSEKK 21 Court Street BALTHOGE MD 200EX 'catminstor, Nd. 21157

\$70-217R

Zoning Description Joseph C. Miller and ""fe Property, First Election District, Nathimore County, Nd.

Peginning for the same at a a point on the southwesternmost side of River Road as laidout thirty feet wide said point being distant t measured in a southeasterly direction from the intersection Read as laidout fifty feet wide and running thence and binding on said side of River Road the two following courses and distances, yiz; (1) fouth 57 degrees 15 minutes East 00.12 feet and (2) ... the course of the derrees 1º minutes East 37.70 feet , thomes leaving (3) South 45 decrees 27 - reases 42 seconds West 127.25 feet, (4) North 42 decrees 24 elemen Nest 321.00 Feet and (5) North 45 decrees 30 minutes hast 00.04 feet to the place of beginning .... containing 0.32°2 acres of land more or less.

Edwin J.Kirby, Jr. RS 5481 January 20,1970



ATTACHED TO AND MADE A FART OF PETITION FOR ZONING RECLASSIFICATION BY JOSEPH G. MILLER AND EARNESE A.

#### REASONS FOR REQUEST FOR RECLASSIFICATION

0 0

- Since the adoption of the zoning map for the First Election District of Baltimore County the character and conditions of the area have so changed that a reclassification of Petitioners' premises to a B-L zone is justified, appropriate and in fact required under proper zoning standards and principles.
- There was error in adoption of the zoning map for the First Election District of Baltimore County by virtue of its failure to make adequate provisions thereon for business uses in the neighborhood of the subject premises and reclassification of Petitioners' property will remedy such error and serve to provide business use demanded and required, without adverse effect on neighboring properties.
- 3. The premises desired to be reclassified have been occupied as a non-confirming use since prior to the adoption of Baltimore County Zoning Regulations and for some years have been used for a barbersho and ceramic shop by the owners.
- Under Petition 67-195% a Special Exception for community building was granted on property immediately opposite the subject property.
- Under Petition 70-62X a Special Exception was granted for land and structure devoted entirely to civic, social and recreational activities, that land being adjacent to the land covered under Petition 67-195X.
- Under Petition 69-242RX covering property situate on Oella Avenue north of the subject property reclassification was granted changing that property from R-10 and R-20 to B-L, MLR and MH with Special Exception for slaughter house and variances.
- 7. On the existing map the property on the opposite side of Frederick Road and to the west of the subject property is zoned B-R and M-L and property to the west on the same side of Frederick Road and between Frederick Road and the Patapsco River is zoned M-L.
- The subject property and the improvements thereon cannot be devoted to R-40 uses due to the size of the property and the location thereof, it being a small parcel binding on River Road and the Patapaco River.
- 9. The subject property is bounded on the east by a sub-station of Baltimore Gas and Electric Company and on the south by the Patapseo River and land owned by Maryland State Department of Forest and Parks and the requested reclassification would not in any way be detrimental to adjoining uses.
  Respectfully submitted,

Respectfully submitted,

David D. Downes
Petitioners' Attorney

BALTIMORE COUNTY ZONING ADVISORY COMMITTEE

March 13, 1970

OLIVER L. MYERS

MEMBERS

BUREAU OF ENGINEERING DEPARTMENT OF TRAFFIC ENGINEERING BUREAU OF FIRE PREVENTION

HEALTH DEPARTMEN PROJECT PLANNING SOARD OF EDUCATION ZONING ADMINISTRATIO INDUSTRIAL DE FELOPMENT

David D. Sownes, Esq., 212 Washington Avenue Towson, Maryland 21204

RE: Type of Hearing: Reclassification from an A-LG ... we to an B-L zone Locations/U/S siver Ada, 72.92° SE of Frederick Road Poitioner: Joseph G. Miller Committee Meeting of March 3, 1970 is: District Item 178

The Zoning Advisory Committee has reviewed the plans submitted with the above referenced potition and has made an on site field inspection of the property. The following comments are a result of this review and

The subject property is presently imprived with a tun story stone building, with the property to the north improved with a "bistory brice desilings to the west with the Patapace River and property whend by the Maryland State Department of Forests and Parks; the Gas & Liestife Compay to the southeast and sone wednit land and duellings to the north and northeast. Proceedings Read and River Read in this location are not improved as for as concrete curb and gutter are concrete.

PROJECT PLANNING DIVISION:

This plan has been reviewed and there are no site planning factors requiring comment.

DEPARTMENT OF TRAFFIC ENGINEERING:

The existing protence is located in an undesirable area and should be released at such time as the building is removed and the site redesigned.

SCARD OF EDUCATION:

Acresge too small to have an effect on student population.

David D. Downes, Esq.

- 2 -

March 13, 1970

FIRE DEPARTMENT:

Owner shall be required to comply with all applicable requirements of the fire Prevention Code and the IOI Life Safety Code, and unition, when construction plans are submitted for approved.

HATELING ENGINEER'S OFFICE:

Potitioner to meet requirements of Parking Lots (see section 409,10H).

The subject site has no direct access to Frederick Road; therefore, there will be no reconstant from the State Roads Commission for improvements to Frederick Roads.

An inspection at the site revealed a heardous situation at from the entrance due to the class area sky of the entrance to French the firm, the extreme angle of the intersection of River flow. The farfick Road and poor sight distance due to the survivier of freich class and the leading of utility policy, paid with, site along the road.

It is our opinion that commercial use of the entrance would cause a considerable traffic hazard.

ZONING ADMINISTRATION DIVISION:

Oue to the community the Health department, this effice is withhelding a hearing date until such time as the putitional indicate on row-sed plant manifer, decaying name for disposal of summer of the community of the suggested that the patitionar maderals are not to the community of the communit

111 OLIVER L. MYLAU, Chairman

BUREAU OF ENGINEERING

Zoning Plat - Comment

176, Property Owner: Joseph G. Hiller (1899-1970) Locktion: SHPS River Road, 72.92 52 of Frederick Ad-Present Zonlog: Balo Proposed Zontny: Raio to ML No. Acress 0.3292

HIGHWAYS:

Frederick Road (MD. 144) is a State Road; therefore, all improvements, intersections, and entrances on this road will be subject to State Roads

River Road, an existing read, will be improved as a 36-foot closed section with flexible paying on a 50-foot right-of-way along the fronters of this property.

Highway improvements, including highway right-of-way widening will be fired in connection with any subsequent grading or building permit appl

The entrance locations are subject to approval by the Department of Traffic

Development of this property through stripping, grading and stabilization could result in a sediment pollution problem, damaging private and public holdings downstroam of the property. A grading permit is, therefore, necessary for all grading, including the stripping of top soil.

ireding studies and sediment control grawings will be necessary to be reviewed and approved prior to the issuance of any grading or building permits.

Provisions for accommodating storm water or drainage have not been indicated on the submitted plan.

In accordance with the dem, note palley for this type development, the Apallemant is responsible for the total actual cost of desince facilities resident is responsible for the total actual cost of desince facilities resident to a suitable outfall. The Applicant's cost responsibilities indise the scale outfall. The Applicant's cost responsibilities indise the scale of the facility of the following desired in the consideration of the following desired construction, rights-of-way and easewest demands including entiresting and surveys, and powent of all studic construction costs including the construction of the column to a construction of the column to the the c

Petition #70-217-R. Southwest side of River Road 72,92 feet South Frederick Road. Petition for Reclassification from R-40 to B.L. Joseph G. Miller - Petitioner 1st District

FROM George E. Gavrelis, Director of Planning

HEARING: Monday, May 25, 1970 (2:00 P.M.)

TO Mr. Edward D. Hardesty, Zoning Commissioner Date May 22, 1970

The Staff of the Office of Planning and Zoning has reviewed the subject partition for reclassification from R-40 to 8 J. . zoning. We recommend against reclassification of this time. We note that no changes have occurred in the menner of land use which justifies reclassification. The consected land with special exceptions immediately neetly could only have been granted if the requirements of Section 502. I of the Regulations and bean mest. As such, there has to be an enfirmative finding of fact that no etheres effect on odjoining properties would esuit from the greating of the special exceptions for community buildings.

BALTIMORE COUNTY, MARYLAND

INTER-OFFICE CORRESPONDENCE

Resolution of the zoning status of this property should await a compre review through the map processes of land use and zoning issues.



178. Joseph Miller Page 2 March 18, 1970

The Applicant must provide necessary drainage facilities (temporary or expension) to prevent creating any misances or damages to adjacent properties, especially by the concentration of surface seture. Correction of any problem which may result, so to improper pressing or improper installation of drainage facilities, would so the full responsibility of the Application.

Prederick auad (ND. 144) is a State Road. Therefore drainage requirements they affect the road come under the jurisdiction of the Maryland State Roads

Public water supply is not available to serve this property.

Public sanitary sewerage can be made available to serve this, and other perties, by construction of lateral public sanitary sewerage to connect in the Parapaco Sanitary Interseptor Sewer. (Degs: 67-0700 and 0609, A-10)

P Ring

11-10-70

Pursuant to the advertisement, posting of preperty, and public hearing on the above petition and it appearing that by reasoned, sufficient change in the area, warrants the reconing. and the petitioner having proved error in the zoning of the subject property.... on the Land Use Map the above Reclassification should be had; and sociocities expensions that by common security IT IS ORDERED by the Zoning Commissioner of Baltimore County this. the same is hereby reclassified; from a.n.R.40....zone to a...B.L. greated, from and after the date of this order, subject to appropriat of the situation by the Bureau of Public Services and the Office of Planning and Zoning. ant to the advertisement, posting of property and public hearing on the above petition earing that by reason of..... the above re-classification should NOT BE HAD, and or the Special Exception should NOT BE IT IS ORDERED by the Zoning Commissioner of Baltimore County, this. . . . . day ......, 196.... that the above re-classification be and the same is hereby DENIED and that the above described property or area be and the same is hereby continued as and ... be and the same is hereby DENIE!

RECFIVED F

ORDER F

M'CHOFILMED

Zoning Commissioner of Baltimore Counts

# CERTIFICATE OF POSTING

District 127. Di

70-217-R

#### B...TIMORE COUNTY, MAR. LAND

INTER-OFFICE CORRESPONDENCE

TO Mr. Oliver Nyers Date April 9, 1970

FROM. Ian J. Porrest

SURFECT. Item 178 - Zeming Advisory Committee Meeting, March 3, 1970

Health Department Comments:

178. Property Owner: Joseph G. Filler
Location: SW/S Elver Ed., 72,92 SE of Frederick Rd.
Proposed Zoning: R-40 to EL
District. 1st
No. Arres: 0.2392

A private water supply and sewage disposal system is located on this property. An inspection by this department revealed that the sewage disposal system was operating satisfactorial.

Air Pollution Comments: The building or buildings on this site may be subject to registration and compliance with the Maryland State Health Air Pollution Control Regulations. Additional information may be obtained from the Division of Air Pollution, Baitimore County Department of Health.

Chief

IJF/ca

The second secon

# CERTIFICATE OF PUBLICATION

BALTIMORE COUNTY, NO. May 7, 1870

70.

John M. Martin

Cost of Advertisement, 8 24.00

P.O. G 9901

Requisition Y 7099

TO DIVISION OF COLLECT ON & ACCEPTS. COURT HOUSE, TOWSON, MARYLAND

CATTON-100 and SIGNAL AND AND SI

# CERTIFICATE OF PUBLICATION

BALL ORE COUNTY, MARYIND
OFFICE OF FINANCE

Division of Collection and Receipts
COUNTY HOUSE
COUNTY HOUSE

DIVISION MARYLAND 31204

SOlumn

DIVISION MARYLAND 31204

MINORITARITY MAKE CHECKS PAYABLE TO BALTIMORE COUNTY, MARYLAND 31204

MAIL TO DIVISION OF COLLECTION & RECEIPTS, COURT HOUSE, TOWSON, MARYLAND 31204


Comments of the Comments of th

## CERTIFICATE OF PUBLICATION

Lon & Martin

John M. A

P.O. # G 9901 Requisition Y 709b

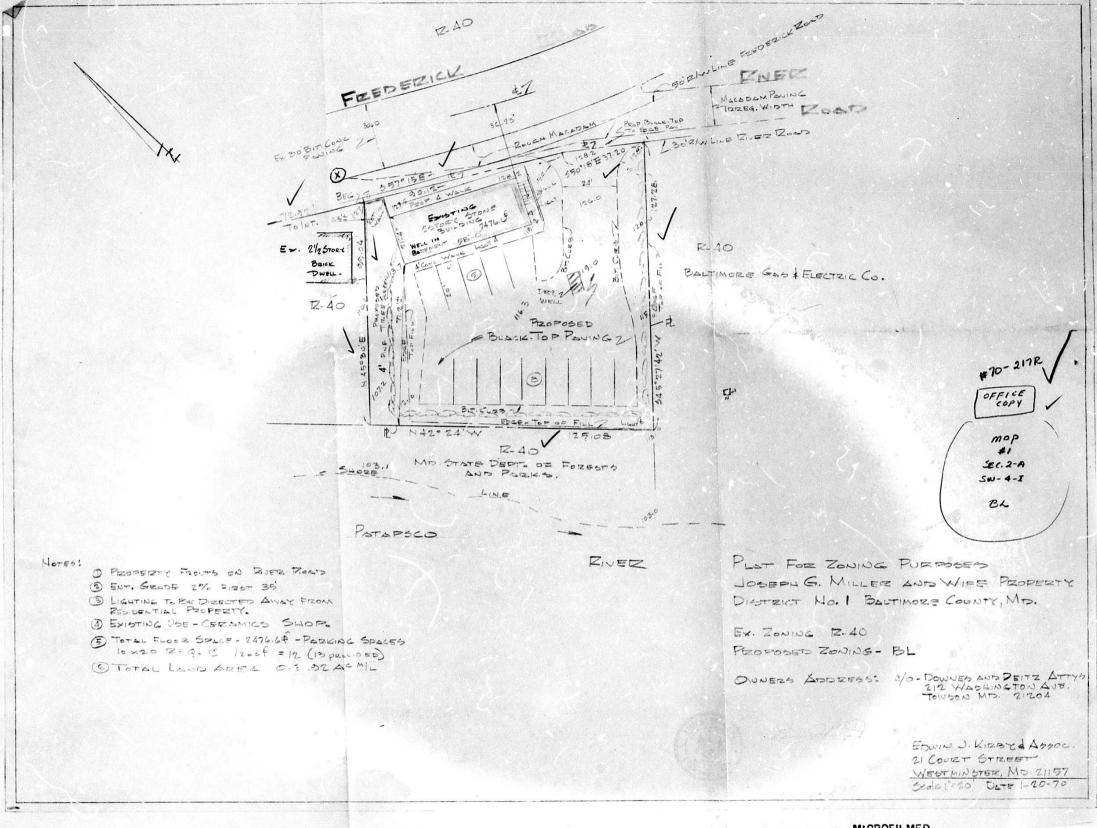

MICROFILMED