



BALTIMORE COUNTY
OFFICE OF PLANNING & ZONING
TOWSON, MARYLAND 21204
494-3353

WILLIAM E. HAMMOND
ZONING COMMISSIONER

September 22, 1981

Mr. Joseph L. Soley
8001 York Road
Towson, Maryland 21204

RE: Request for Extension of Special
Exception (Case No. 75-139-XA)
NE/corner of York Road and
Aigburth Avenue - 9th Election
District

Dear Mr. Soley:

I am in receipt of your letter of September 21, 1981, and wish to advise that the Order granting the special exception cannot be extended for any additional period of time.

The Court of Special Appeals of Maryland has held that the Ex Parte granting of an extension denies due process by failure to give notice of such extension with an opportunity to be heard. In addition, Section 502.3 of the Baltimore County Zoning Regulations states:

"A Special Exception which has not been utilized within a period of two years from the date of the final order granting same, or such longer period not exceeding five years, as may have been specified therein, shall thereafter be void."

The file reflects that an Extension Order was signed by S. Eric DiNenna, the then Zoning Commissioner, on October 18, 1978, for a period of three years, expiring April 19, 1982. Adding this three-year extension to the two original years from the granting of the special exception equals a total of five years—the maximum permitted period.

If any further information is required, please advise.

Very truly yours,


WILLIAM E. HAMMOND
Zoning Commissioner

WEH/srl

81-2159

8001 York Road
Towson, Maryland 21204

September 21, 1981

Mr. William D. Hammond
Zoning Commissioner
Room 109
County Office Building
Towson, Maryland 21204

Re: Case No. 75-139-XA
Joseph L. Soley


Dear Mr. Hammond:

I wish to apply for an extension for the utilization of the Special Exception in the above case.


Please advise that the extension has been granted.

Thank you.

Very truly yours,

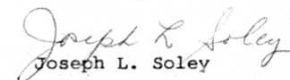
Joseph L. Soley

JLS:da

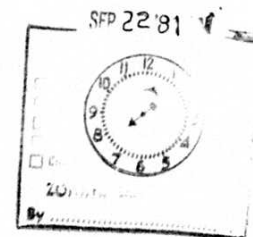

7-367
With
G. J. Martinak
O.K.
filed

8001 York Road
Towson, Maryland 21204

October 3, 1978

Mr. S. E. DiNenna, Zoning Commissioner
Room 109
County Office Building
Towson, Maryland 21204

Re: Case No. 75-139-XA
Joseph L. Soley

Dear Mr. DiNenna:

I wish to apply for a three year extension for the utilization of the Special Exception in the above case.



Please advise that the extension has been granted.

Thank you.

Very truly yours,

Joseph L. Soley
Joseph L. Soley

da

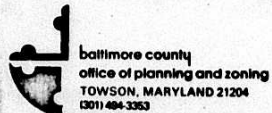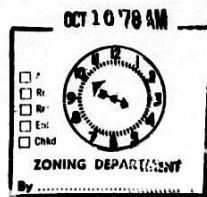

S. ERIC DINENNA
ZONING COMMISSIONER
George J. Martinak
Deputy Zoning Commissioner

October 18, 1978

Mr. Joseph L. Soley
8001 York Road
Towson, Maryland 21204

RE: Petition for Special Exception
NE/corner of York Road and Aigburth Avenue - 9th Election District
Joseph L. Soley - Petitioner
NO. 75-139-XA (Item No. 65)

Dear Mr. Soley:

I have this date passed my Order in the above referenced matter, in accordance with the attached.

Very truly yours,

S. Eric DiNenna
S. ERIC DINENNA
Zoning Commissioner

SED:mr

Attachment

RE: PETITION FOR SPECIAL EXCEPTION : BEFORE THE
NE/corner of York Road and Aigburth : ZONING COMMISSIONER
Avenue - 9th Election District :
Joseph L. Soley - Petitioner : OF
NO. 75-139-XA (Item No. 65) :
: BALTIMORE COUNTY

::: ::::

::: ::::

EXTENSION ORDER

It is hereby ORDERED by the Zoning Commissioner of Baltimore County, this 18th day of October, 1978, that the Special Exception for an office building and offices, granted April 28, 1977, be and the same is hereby extended, in accordance with Section 502.3 of the Baltimore County Zoning Regulations, for a period of three years, beginning April 28, 1979, and ending April 28, 1982.

S. Eric DiNenna
Zoning Commissioner of
Baltimore County

ORDER RECEIVED FOR FILING

DATE October 17, 1978
BY *Joseph L. Soley*

PETITION FOR ZONING VARIANCE FROM AREA AND HEIGHT REGULATIONS

TO THE ZONING COMMISSIONER OF BALTIMORE COUNTY:

I, or we, Joseph L. Soley, legal owner of the property situate in Baltimore County and which is described in the description and plat attached hereto and made a part hereof,

hereby petition for a Variance from Section 1102.2B(504-V.B.2) to permit a not less than 30 feet and not more than 35 feet wide and not less than 10 feet and not more than 15 feet deep

yard set back instead of the required 25 feet and a variance to Section 409.2c.4 to permit off street parking to be 3 feet from a street property line instead of the required 5 feet.

of the Zoning Regulations of Baltimore County to the Zoning Law of Baltimore County; for the following reasons: (indicate hardship or practical difficulty)

Extreme hardship and practical difficulty because of proposed future street widening.

Property is to be posted and advertised as prescribed by Zoning Regulations. I, or we, agree to pay expenses of above Variance advertising, posting, etc. upon filing of this petition, and further agree to and are to be bound by the zoning regulations and restrictions of Baltimore County adopted pursuant to the Zoning Law For Baltimore County.

Contract purchaser _____ Legal Owner _____
Address _____ Address 801 York Road, 21204
W. Lee Harrison, Petitioner's Attorney _____ Protestant's Attorney _____
Address 306 W. Joppa Road _____
Towson, Maryland 21204

ORDERED BY The Zoning Commissioner of Baltimore County, this _____ day

of _____ 196____, that the subject matter of this petition be advertised, as required by the Zoning Law of Baltimore County, in two newspapers of general circulation throughout Baltimore County, that property be posted, and that the public hearing be had before the Zoning Commissioner of Baltimore County in Room 100 of the County Office Building in Towson, Baltimore County, on the _____ day of _____, 196____, at _____ o'clock _____ M.

Zoning Commissioner of Baltimore County.

JAMES S. SPAMER & ASSOCIATES
PROFESSIONAL ENGINEERS & LAND SURVEYORS
6037 YORK ROAD - TOWSON, MD. 21204
BY WOL Description of Property Located at Northeast Corner of Aigburth Road and York Road SHEET 1 OF 1
DATE 3/23/75 FILE 1-1356A
April 17, 1975

All that piece or parcel of land situate, lying and being in the 9th Election District of Baltimore County, Maryland and described as follows, TO WIT:

BEGINNING for the same at a stone heretofore planted at the corner formed by the intersection of the east side of York Road with the north side of Aigburth Road; and running thence binding on the east side of York Road, (1) North 11° 50' 00" East 310 feet, thence for line of division now made, the four following courses and distances, (2) South 89° 17' 50" East 75 feet, (3) South 11° 50' 00" West 50 feet, (4) South 89° 17' 50" East 35 feet, and (5) South 11° 50' 00" West 260 feet, thence binding on the north side of Aigburth Road, (6) North 89° 17' 50" East 100 feet to the place of beginning.

CONTAINING 0.68 Acres of land more or less.

BEING part of the two parcels of land which by a deed dated April 30, 1957 and recorded among the Land Records of Baltimore County in Liber 311.8, No. 3185 folio 167 and which was conveyed by Alma M. Vandermast, et al, to Greater Towson Development Corporation.

RE: PETITION FOR SPECIAL EXCEPTION : BEFORE
for Offices and Office Building, and : COUNTY BOARD OF APPEALS
VARIANCES from Section 1102.2B : OF
(504-V.B.2) and Section 409.2c.4 : BALTIMORE COUNTY
of the Baltimore County :
Zoning Regulations :
NE corner York Road :
and Aigburth Avenue :
9th District :
Joseph L. Soley :
Petitioner :
Nc. 75-139-XA

OPINION

This case comes before the Board on an appeal by the Petitioner from an Order of the Deputy Zoning Commissioner, dated March 5, 1975, denying the requested petition for a special exception and variances from required setbacks.

The property in question is located on the northeast corner of Aigburth Road and York Road, adjacent to D.R. 16 zoning classification and contains approximately .68 acres, which is out of a larger tract owned by the Petitioner that is already improved with apartments and offices.

The proposal which is under consideration here is for the construction of a two story office building, 60 feet by 60 feet, as indicated on Petitioner's Exhibit #1. In support of this the Petitioner testified, as did his professional engineer, and both indicated that the requirements of Section 502.1 of the Baltimore County Zoning Regulations would be fully satisfied. There was no testimony from the Protestants side of the case to the contrary. There was some general reference as to the increase in traffic congestion, however, the Board notes from the report, dated October 17, 1974, from the Baltimore County Department of Traffic Engineering that the increase of traffic generated by the proposal over that which would be generated if the subject property were developed under the existing zoning would be negligible; namely, an increase of from 90 trips per day to approximately 108 trips per day. Consequently, the Board feels that the special exception for offices should be granted.

Also, it is interesting to note that the only individual witnesses from the neighborhood who were opposed to the idea of an office building at the subject site were unaware that the Petitioner already has offices in that portion of his property which has already been developed. We feel that this speaks well for the type of project that the

Joseph L. Soley - #75-139-XA

Petitioner proposes, and that same will be developed in taste and in harmony with his existing apartment and office development.

The second aspect of this case is for variances requested by the Petitioner; namely, from a required thirty (30) foot from yard setback the Petitioner is requesting a zero (0) foot setback. This variance is requested because of the proposal for a future widening of York Road to eighty-four (84) feet. Similarly, a variance for a three (3) foot setback for the parking area from York Road from the required distance of eight (8) feet is requested for the same reason. Under the testimony from the Petitioner's engineer, it was disclosed that the Petitioner could have met the requirements for the front yard setbacks prior to the proposal for the widening of York Road. The Petitioner is required by the State and County to dedicate the right-of-way to obtain the necessary permits in order to proceed with his project. Consequently, the Board feels that this does present both an unreasonable hardship and a practical difficulty upon the Petitioner, and as can be evidenced by Petitioner's Exhibit #1, shows that by moving the building back from the York Road further would cause the loss of some of the parking area which would be necessary for this project.

The remaining variance requested is from a required twenty-five (25) feet to a zero (0) foot setback on the side yard from Aigburth Road. This is required as the Petitioner plans to put a chanfer on the corner of the intersection of York and Aigburth Roads, thereby increasing the sight distance along York Road. However, in so doing this would reduce the side yard setback to zero (0) feet at the point where the chanfer meets the proposed office building. An examination of Petitioner's Exhibit #1 shows this situation delineated in red ink and will further show that the building itself actually does sit back twenty-five (25) feet from the Aigburth Road proper, with the exception of the shortening of that distance occasioned by the construction of the chanfer aforesaid. According to the engineer, the variances are required because the chanfer technically becomes a permanent property line and thereby would necessitate the requested variance.

Joseph L. Soley - #75-139-XA

Again, the Board feels that to deny this variance would not only place a hardship and difficulty upon the Petitioner, but also would not be in the best interest of the public for by granting the variance, which requires the Petitioner to again relinquish some of his property, this would also serve the public by giving the vehicular traffic a better and improved sight distance, both on York Road and Aigburth Road. Therefore, the Board finds that the special exception for an office building should be granted, and also the three variances should likewise be granted.

ORDER

For the reasons set forth in the foregoing Opinion, it is this 28th day of April, 1977, by the County Board of Appeals, ORDERED that the special exception and variances petitioned for, be and the same are hereby GRANTED.

Any appeal from this decision must be in accordance with Rules 8-1 thru 8-12 of the Maryland Rules of Procedure.

COUNTY BOARD OF APPEALS
OF BALTIMORE COUNTY

Walter A. Reiter, Jr., Chairman

Robert L. Gilland

John A. Miller

BALTIMORE OFFICE
WILLIAM D. FROMM
JAMES E. DYER
JAMES L. MILLER
JAMES S. SPAMER & ASSOCIATES
PROFESSIONAL ENGINEERS & LAND SURVEYORS
6037 YORK ROAD - TOWSON, MD. 21204
TOWSON OFFICE
WILLIAM D. FROMM
JAMES E. DYER
JAMES L. MILLER
JAMES S. SPAMER & ASSOCIATES
PROFESSIONAL ENGINEERS & LAND SURVEYORS
6037 YORK ROAD - TOWSON, MD. 21204
LAW OFFICES
WEINBERG AND GREEN
NINETEENTH FLOOR
10 LIGHT STREET
BALTIMORE, MD. 21202
SUITE 601
401 WASHINGTON AVENUE
TOWSON, MD. 21204
March 6, 1975

S. Eric DiNenna, Esq.
Zoning Commissioner
County Office Building
Towson, Maryland 21204

Re: Petition for Special Exception and Variance,
NE corner of York Road and Aigburth Avenue - 9th District
Joseph L. Soley - Petitioner, 75-139-XA (Item No. 65)

Dear Mr. DiNenna:

Please note an appeal to the County Board of Appeals from the decision and Order dated March 5, 1975, denying the above requested Special Exception and Variance on behalf of the Petitioner.

I enclose herewith check in the amount of \$75.00 to cover the costs of said appeal.

Very truly yours,
W. Lee Harrison
W. Lee Harrison

b/enc.

BALTIMORE COUNTY OFFICE OF PLANNING & ZONING

OFFICE OF ZONING COMMISSIONER

S. ERIC DINENNA
Zoning Commissioner
JAMES E. DYER
Deputy Zoning Commissioner
March 5, 1975

W. Lee Harrison, Esquire
Suite 601
401 Washington Avenue
Towson, Maryland 21204

RE: Petition for Special Exception and Variance
NE corner of York Road and Aigburth Avenue - 9th District
Joseph L. Soley - Petitioner
NO. 75-139-XA (Item No. 65)

Dear Mr. Harrison:

I have this date passed my Order in the above captioned matter in accordance with the attached.

Very truly yours,
James E. Dyer
JAMES E. DYER
Deputy Zoning Commissioner

JED/mc

Attachments

cc: Mr. Herbert R. Steiner
President
Towson Manor Association
13 Maryland Avenue
Towson, Maryland 21204

Mr. Martin S. Reff
8011 York Road, Apt. C-8
Towson, Maryland 21204

Mr. William A. Miller
8005 York Road
Towson, Maryland 21204

BALTIMORE COUNTY, MARYLAND

INTER-OFFICE CORRESPONDENCE

TO: S. Eric DiNenna, Zoning Commissioner Date January 3, 1975

FROM: William D. Fromm, Director of Planning

SUBJECT: Petition 75-139-XA, Northeast corner of York Road and Aigburth Avenue.
Petition for Special Exception for Offices and Office Building.
Petition for Variance for Front and Side Yards and Off-Street Parking.
Petitioner - Joseph L. Soley

9th District

HEARING: Monday, January 6, 1975 (1:00 P.M.)

The staff of the Office of Planning and Zoning has reviewed the subject petition and has the following comments to offer.

The 1980 Guideplan, the County's official master plan, recommends that office buildings be confined to designated town and community centers. The subject property lies outside the Towson town center boundary as officially designated by the Planning Board. Further the proposed Towson Master Plan recommends that offices be allowed in D.R. 16 zones adjacent to the ring road system via conversion of existing dwelling and that the buildings should retain the outward appearance of a dwelling.

This request does not appear to be consistent with the policies of either the 1980 Guideplan or the proposed Towson master plan policies.

William D. Fromm
Director of Planning

WDF:NEG:rw

75-139 XA
J. L. Soley
EXHIBITS
BOARD OF APPEALS
PETITIONER'S
EXHIBIT ① Plot of S.P.
James Spamer 10-29-74
③ Plot of S.P. - Spamer
9-25-74
⑤ Plot sheet 4 of 8
④ Plot u 2 of 8
RETURNED TO ZONING
WITH FILE - 6-6-77
Per Counsel
① A-F Photos of Immed. Area.
② Plot of S.P.
4-14-71
③ Plot - Spamer - 4-14-71
4 accompanying Zoning File
72-40 XA 4071-283 A
RETURNED TO P.C.

RE: PETITION FOR SPECIAL EXCEPTION : BEFORE THE
AND VARIANCE : DEPUTY ZONING
NE/corner of York Road and Aigburth : COMMISSIONER
Avenue - 9th District :
Joseph L. Soley - Petitioner :
NO. 75-139-XA (Item No. 65) :
OF
BALTIMORE COUNTY

This Petition represents a request for a Special Exception for an office building and offices as well as Valances to building and parking setback requirements. The subject property is located on the northeast corner of York Road and Aigburth Avenue and lies within the Ninth Election District of Baltimore County.

The property in question contains a total of 6.923 acres of land, is improved with several apartment buildings containing a total of one hundred units, within which is also included four office units containing 4,135 square feet.

The above described apartments were considered by many, including present residents of the apartment complex who testified, as having been done in excellent taste with the saving of many large trees and aesthetically pleasing use of open space and green areas.

Considering the total number of apartment and office units and provisions for the required parking spaces, the total area of the site has been determined to contain sufficient area to permit the construction of the proposed office building. Said building would be located within the open space situated at the northeast corner of York and Aigburth Roads.

The developer testified that while residue area over and above that required to meet density requirements does exist, its shape, as dictated by existing structures and parking areas, is narrow and elongated requiring setback Variances. If granted, the office structure would set back two feet

and the parking area three feet from the York Road right of way line as proposed to be widened to seven feet.

Testimony of area residents together with comments of the Zoning Plans Advisory Committee raised serious question as to overcrowding of the subject land and the existence of traffic problems on York Road that would be aggravated by the proposed improvements.

Without reviewing all testimony and evidence in detail but based on all such testimony and evidence presented, it is the opinion of the Deputy Zoning Commissioner that the testimony of the Petitioner/Developer was not sufficient to overcome the prerequisites of Section 502.1 and/or the provisions of Section 307, necessary to grant the requested Variances.

Therefore, IT IS ORDERED by the Deputy Zoning Commissioner of Baltimore County, this 5th day of March, 1975, that the herein requested Special Exception for an office building and offices as well as Variances to building and parking setback requirements for said building and parking, should be and the same is hereby DENIED.

James S. Spamer
Deputy Zoning Commissioner of
Baltimore County

ORDER RECEIVED FOR FILING

DATE March 5, 1975
BY John P. Langick

ORDER RECEIVED FOR FILING


DATE March 5, 1975
BY John P. Langick

BALTIMORE COUNTY OFFICE OF PLANNING & ZONING Item 65
J. Lee Harrison, Esq.
306 W. Joppa Road
Towson, Maryland 21204
County Office Building
111 W. Chesapeake Avenue
Towson, Maryland 21204
Your Petition has been received and accepted for
filing this 2nd day of December 1974.
S. Eric DiMenna
Zoning Commissioner

Petitioner Joseph L. Soley
Petitioner's Attorney W. Lee Harrison, Esq. Reviewed by
cc: James S. Spamer & Associates Franklin T. Hogans, Jr.
8017 York Road Chairman,
Towson, Md. 21204 Zoning Plans
Advisory Committee

CERTIFICATE OF POSTING
ZONING DEPARTMENT OF BALTIMORE COUNTY 75-139-XA
Towson, Maryland

District 9th
Posted for: H
Date of Posting 3-22-75
Petitioner: Joseph L. Soley
Location of property: NE/cor. of York Rd. & Aigburth Ave.
Location of Signs: 2 signs 1 on York Rd. one on Aigburth Ave.
Remarks: [Signature]
Posted by: [Signature] Date of return: 4/3/75

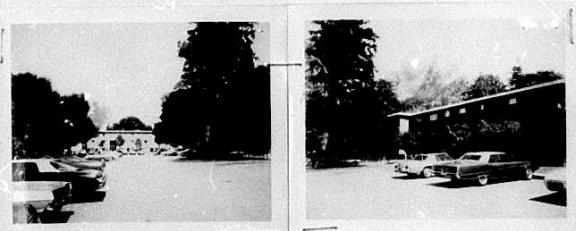

PETITION FOR ZONING RE-CLASSIFICATION
AND/OR SPECIAL EXCEPTION

TO THE ZONING COMMISSIONER OF BALTIMORE COUNTY:
I, or we, Joseph L. Soley, legal owner, of the property situate in Baltimore County and which is described in the description and plat attached hereto and made a part hereof, hereby petition (1) that the zoning status of the herein described property be re-classified, pursuant to the Zoning Law of Baltimore County, from an _____ zone to an _____ zone; for the following reasons:

See attached description
and (2) for a Special Exception, under the said Zoning Law and Zoning Regulations of Baltimore County, to use the herein described property, for: _____

Property is to be posted and advertised as prescribed by Zoning Regulations.
I, or we, agree to pay expenses of above re-classification and/or Special Exception advertising, posting, etc., upon filing of this petition, and further agree to and are to be bound by the zoning regulations and restrictions of Baltimore County adopted pursuant to the Zoning Law for Baltimore County.

Contract purchaser _____
Address _____
Local Owner _____
Address 8001 York Road, 21204
W. Lee Harrison, Petitioner's Attorney _____
Protestant's Attorney _____
Address 306 W. Joppa Road _____
Towson, Maryland 21204
BY ORDERED By The Zoning Commissioner of Baltimore County, this 12th day of December, 1975, that the subject matter of this petition be advertised, as required by the Zoning Law of Baltimore County, in two newspapers of general circulation throughout Baltimore County, that property be posted, and that the public hearing be had before the Zoning Commissioner of Baltimore County in Room 106, County Office Building in Towson, Baltimore County, on the 6th day of January, 1975, at 1:00 P.M.
Zoning Commissioner of Baltimore County
(over)

BALTIMORE COUNTY, MARYLAND No. 17932
OFFICE OF FINANCE - REVENUE DIVISION
MISCELLANEOUS CASH RECEIPT
DATE March 13, 1975 ACCOUNT 01-662
AMOUNT \$75.00
DISTRIBUTION
WHITE - CASHIER W. Lee Harrison, Esquire
PINK - AGENCY
YELLOW - CUSTOMER
Cost of Filing of an Appeal and Partial Posting (One (1) Sign) of Property on Case No. 75-139-XA (Item No. 65) NE/corner of York Road and Aigburth Avenue - 9th Election District
Joseph L. Soley - Petitioner 75.00 CASH

BALTIMORE COUNTY, MARYLAND No. 17179
OFFICE OF FINANCE - REVENUE DIVISION
MISCELLANEOUS CASH RECEIPT
DATE Dec. 6, 1974 ACCOUNT 01-662
AMOUNT \$50.00
DISTRIBUTION
WHITE - CASHIER W. Lee Harrison, Esq.
PINK - AGENCY
YELLOW - CUSTOMER
Equitable Bank Building
Towson, Md. 21204
Petition for Variance and Special Exception for Joseph L. Soley 75-139-XA 50.00 CASH

BALTIMORE COUNTY, MARYLAND No. 17422
OFFICE OF FINANCE - REVENUE DIVISION
MISCELLANEOUS CASH RECEIPT
DATE Jan. 6, 1975 ACCOUNT 01-662
AMOUNT \$82.00
DISTRIBUTION
WHITE - CASHIER Joseph L. Soley
PINK - AGENCY 8001 York Rd.
YELLOW - CUSTOMER Towson, Md. 21204
Advertising and posting of property 75-139-XA 82.00 CASH

November 29, 1974
W. Lee Harrison, Esq.
306 W. Joppa Road
Towson, Maryland 21204
RE: Variance Petition
Item 65
Joseph L. Soley - Petitioner
Dear Mr. Harrison:
This office is in receipt of revised plans and/or descriptions which reflect the required changes of the participating agency(s) of the Zoning Plans Advisory Committee.
This petition is accepted for filing on the date of the enclosed filing certificate. Notice of the hearing date and time, which will be held not less than 30, nor more than 90 days after the date on the filing certificate, will be forwarded to you in the near future.
Very truly yours,
JAMES B. BYRNES, III
Chairman,
Zoning Plans Advisory Committee
JBS:JD
Enclosure
cc: James S. Spamer & Associates
8017 York Road
Towson, Md. 21204

BALTIMORE COUNTY ZONING PLANS ADVISORY COMMITTEE

October 17, 1974

COUNTY OFFICE BUILDING
111 W. CHESAPEAKE AVENUE
TOWSON, MARYLAND 21204*****
JAMES B. BYRNES, III
Chairman

MEMBERS

ZONING ADMINISTRATION

HEALTH DEPARTMENT

BUREAU OF

FIRE PREVENTION

DEPARTMENT OF

TRAFFIC ENGINEERING

STATE HIGHWAY

ADMINISTRATION

BUREAU OF

ENGINEERING

PROJECT AND

DEVELOPMENT PLANNING

INDUSTRIAL

DEVELOPMENT

COMMISSION

BOARD OF EDUCATION

OFFICE OF THE

BUILDINGS ENGINEER

W. Lee Harrison, Esq.
306 W. Joppa Road
Towson, Maryland 21204RE: Variance Petition
Item 65
Joseph L. Soley - Petitioner

Dear Mr. Harrison:

The Zoning Advisory Committee has reviewed the plans submitted with the above referenced petition and has made an on site field inspection of the property. The following comments are a result of this review and inspection.

These comments are not intended to indicate the appropriateness of the zoning action requested, but to assure that all parties are made aware of plans or problems with regard to the development plans that may have a bearing on this case. The Director of Planning may file a written report with the Zoning Commissioner with recommendations as to the appropriateness of the requested zoning.

The subject property is located on the northeast corner of York Road and Albright Avenue, in the 9th Election District of Baltimore County, and is part of the Albright Manor apartment project.

The Lurleigh Square rowhouse development abuts the property to the north and Towson State College exists opposite the site on York Road.

The petitioner is requesting a Special Exception for offices and proposes to erect a two-story professional office building of 7200 square feet. Off street parking is proposed for 27 vehicles. Additional variances have been requested for front and side yard setbacks, as well as parking setback from a street right-of-way line.

W. Lee Harrison, Esq.
Re: Item 58
October 17, 1974

Page 2

This Committee is withholding approval of the subject application until such time as the site plans have been revised to reflect the comments of State Highway Administration.

Very truly yours,

JAMES B. BYRNES, III
Chairman,
Zoning Plans Advisory Committee

JBB:JD

Enclosure

cc: James S. Spaner & Associates
8017 York Road
Towson, Md. 21204Baltimore County, Maryland
Department of Public Works
COUNTY OFFICE BUILDING
TOWSON, MARYLAND 21204Bureau of Engineering
ELLENWORTH H. DIVER, P. E., C.E.P.

October 17, 1974

Mr. S. Eric DiNenna
Zoning Commissioner
County Office Building
Towson, Maryland 21204

Re: Item #65 (1974-1975)
Property Owner: Joseph L. Soley
1/4 E. of Albright Rd. & York Rd.
Existing Zoning: D.R. 16
Proposed Zoning: Special Exception for offices and office building. Variance from Sec. 1802.2B (504-V.2) to permit a front yard setback of 0' instead of the required 30' and to permit a 0' side yard setback instead of the required 25' and a Variance of Sec. 409.2C.4 to permit off street parking to be 3' from a street property line instead of the required 8'
No. of Acres: 0.68 District: 9th

Dear Mr. DiNenna:

The following comments are furnished in regard to the plan submitted to this office for review by the Zoning Advisory Committee in connection with the subject item.

General:

The comments supplied in connection with the Zoning Advisory Committee review of this site for Item #193 (1973-1974) remain valid, applicable and are reemphasized in connection with this Item #65 (1974-1975); the submitted plan must be revised accordingly.

Very truly yours,

ELLENWORTH H. DIVER, P.E.
Chief, Bureau of Engineering

END:HAM:PH:iss

N-W Key Sheet
35 NS 3 Pos. Sheet
NS 9 A Topo
70 Tax MapBALTIMORE COUNTY, MARYLAND
DEPARTMENT OF HEALTHJEFFERSON BUILDING
TOWSON, MARYLAND 21204DONALD A. MCOP, M.D., M.P.H.
DEPUTY STATE AND COUNTY HEALTH OFFICER

September 30, 1974

Mr. S. Eric DiNenna, Zoning Commissioner
Office of Planning and Zoning
County Office Building
Towson, Maryland 21204

Dear Mr. DiNenna:

Comments on Item 65, Zoning Advisory Committee Meeting, September 24, 1974, are as follows:

Property Owner: Joseph L. Soley
Location: NE/C of Albright Rd. & York Rd.
Existing Zoning: D.R. 16
Proposed Zoning: Special Exception for offices & office bldg. Variance from Sec. 1802.2B (504-V.2) to permit a front yard setback of 0 ft. instead of the required 30 ft. & to permit a 0 ft. side yard setback instead of the required 25 ft. & a Variance of Sec. 409.2C.4 to permit off street parking to be 3 ft. from a street property line instead of the required 8 ft.
No. of Acres: 0.68
District: 9th

Metropolitan water and sewer are available.

Jones Falls Moratorium: A moratorium was placed on new sewer connections in the Jones Falls Drainage Basin by Dr. Neil Solomon, Secretary of Health and Mental Hygiene, on November 13, 1973; therefore approval may be withheld for this connection.

Food Protection Comments: If a food service facility is proposed, complete plans and specifications must be submitted to the Division of Food Protection, Baltimore County Department of Health, for review and approval.

Page 2
Zoning Advisory Committee Meeting
September 24, 1974
Comment 65

Air Pollution Comments: The building or buildings on this site may be subject to a permit to construct and a permit to operate any and all fuel burning and processing equipment. Additional information may be obtained from the Division of Air Pollution and Industrial Hygiene, Baltimore County Department of Health.

Very truly yours,

THOMAS H. DEVLIN, Director
BUREAU OF ENVIRONMENTAL SERVICES

RVB/mcg

CC--L.A. Schuppert
W.L. PhillipsMaryland Department of Transportation
State Highway AdministrationHarry R. Hughes
Secretary
Bernard M. Evans
Administrator

September 26, 1974

Mr. S. Eric DiNenna
Zoning Commissioner
County Office Building
Towson, Maryland 21204

Attn: Mr. James B. Byrnes III

Dear Sir:

As mentioned several times in previous comments, the State Highway Administration does not see the need or advantage of the proposed entrance from York Road. The site has good access from York Road by way of Albright Ave. The intersection of Albright Ave. with York Road is signalized. Due to the heavy volume of traffic on York Road; 18,000 vehicles, 1973 average daily traffic, which causes back-ups from the signal, it may be extremely difficult for vehicles leaving by the proposed entrance to proceed south on York Road.

Although the plan has a note indicating a 3% down grade on the proposed entrance, a review of existing contours and inspections at the site revealed that it may be difficult, if not impossible, to provide the maximum permitted grade of 3%. In order to consider the entrance, the plan must indicate proposed contours with elevations from the highway to and including the parking lot.

It is our opinion that the petition should be held in abeyance until such time as this is accomplished.

Very truly yours,

Charles Lee, Chief
Bureau of Engineering
Access Permits
By: J. E. Meyers

CLJ:JTBk

WILLIAM D. FROMM
DIRECTOR
S. ERIC DINENNA
ZONING COMMISSIONER

October 14, 1974

Mr. S. Eric DiNenna, Zoning Commissioner
Zoning Advisory Committee
Office of Planning and Zoning
Baltimore County Office Building
Towson, Maryland 21204

Dear Mr. DiNenna:

Comments on Item #65, Zoning Advisory Committee Meeting, September 24, 1974, are as follows:


Property Owner: Joseph L. Soley
Location: NE/C of Albright Road and York Road
Existing Zoning: D.R. 16
Proposed Zoning: Special Exception for offices and office bldg Variance from Sec. 1802.2B (504-V.2) to permit a front yard setback of 0 ft. instead of the required 30 ft. and to permit a 0 ft. side yard setback instead of the required 25 ft. and a variance of Sec. 409.2C.4 to permit off street parking to be 3 ft. from a street property line instead of the required 8 ft.
No. of Acres: 0.68
District: 9th

This office has reviewed the subject petition and offers the following comments. These comments are not intended to indicate the appropriateness of the zoning in question, but are to assure that all parties are made aware of plans or problems with regard to development plans that may have a bearing on this petition.


This plan has been reviewed and there are no site-planning factors requiring comment.

Very truly yours,

John L. Wimbley
Planning Specialist II
Project and Development PlanningBALTIMORE COUNTY OFFICE OF PLANNING AND ZONING
SUITE 301 JEFFERSON BUILDING 105 WEST CHESAPEAKE AVENUE TOWSON, MARYLAND 21204
AREA CODE 301 PLANNING 484-3211 ZONING 484-3291

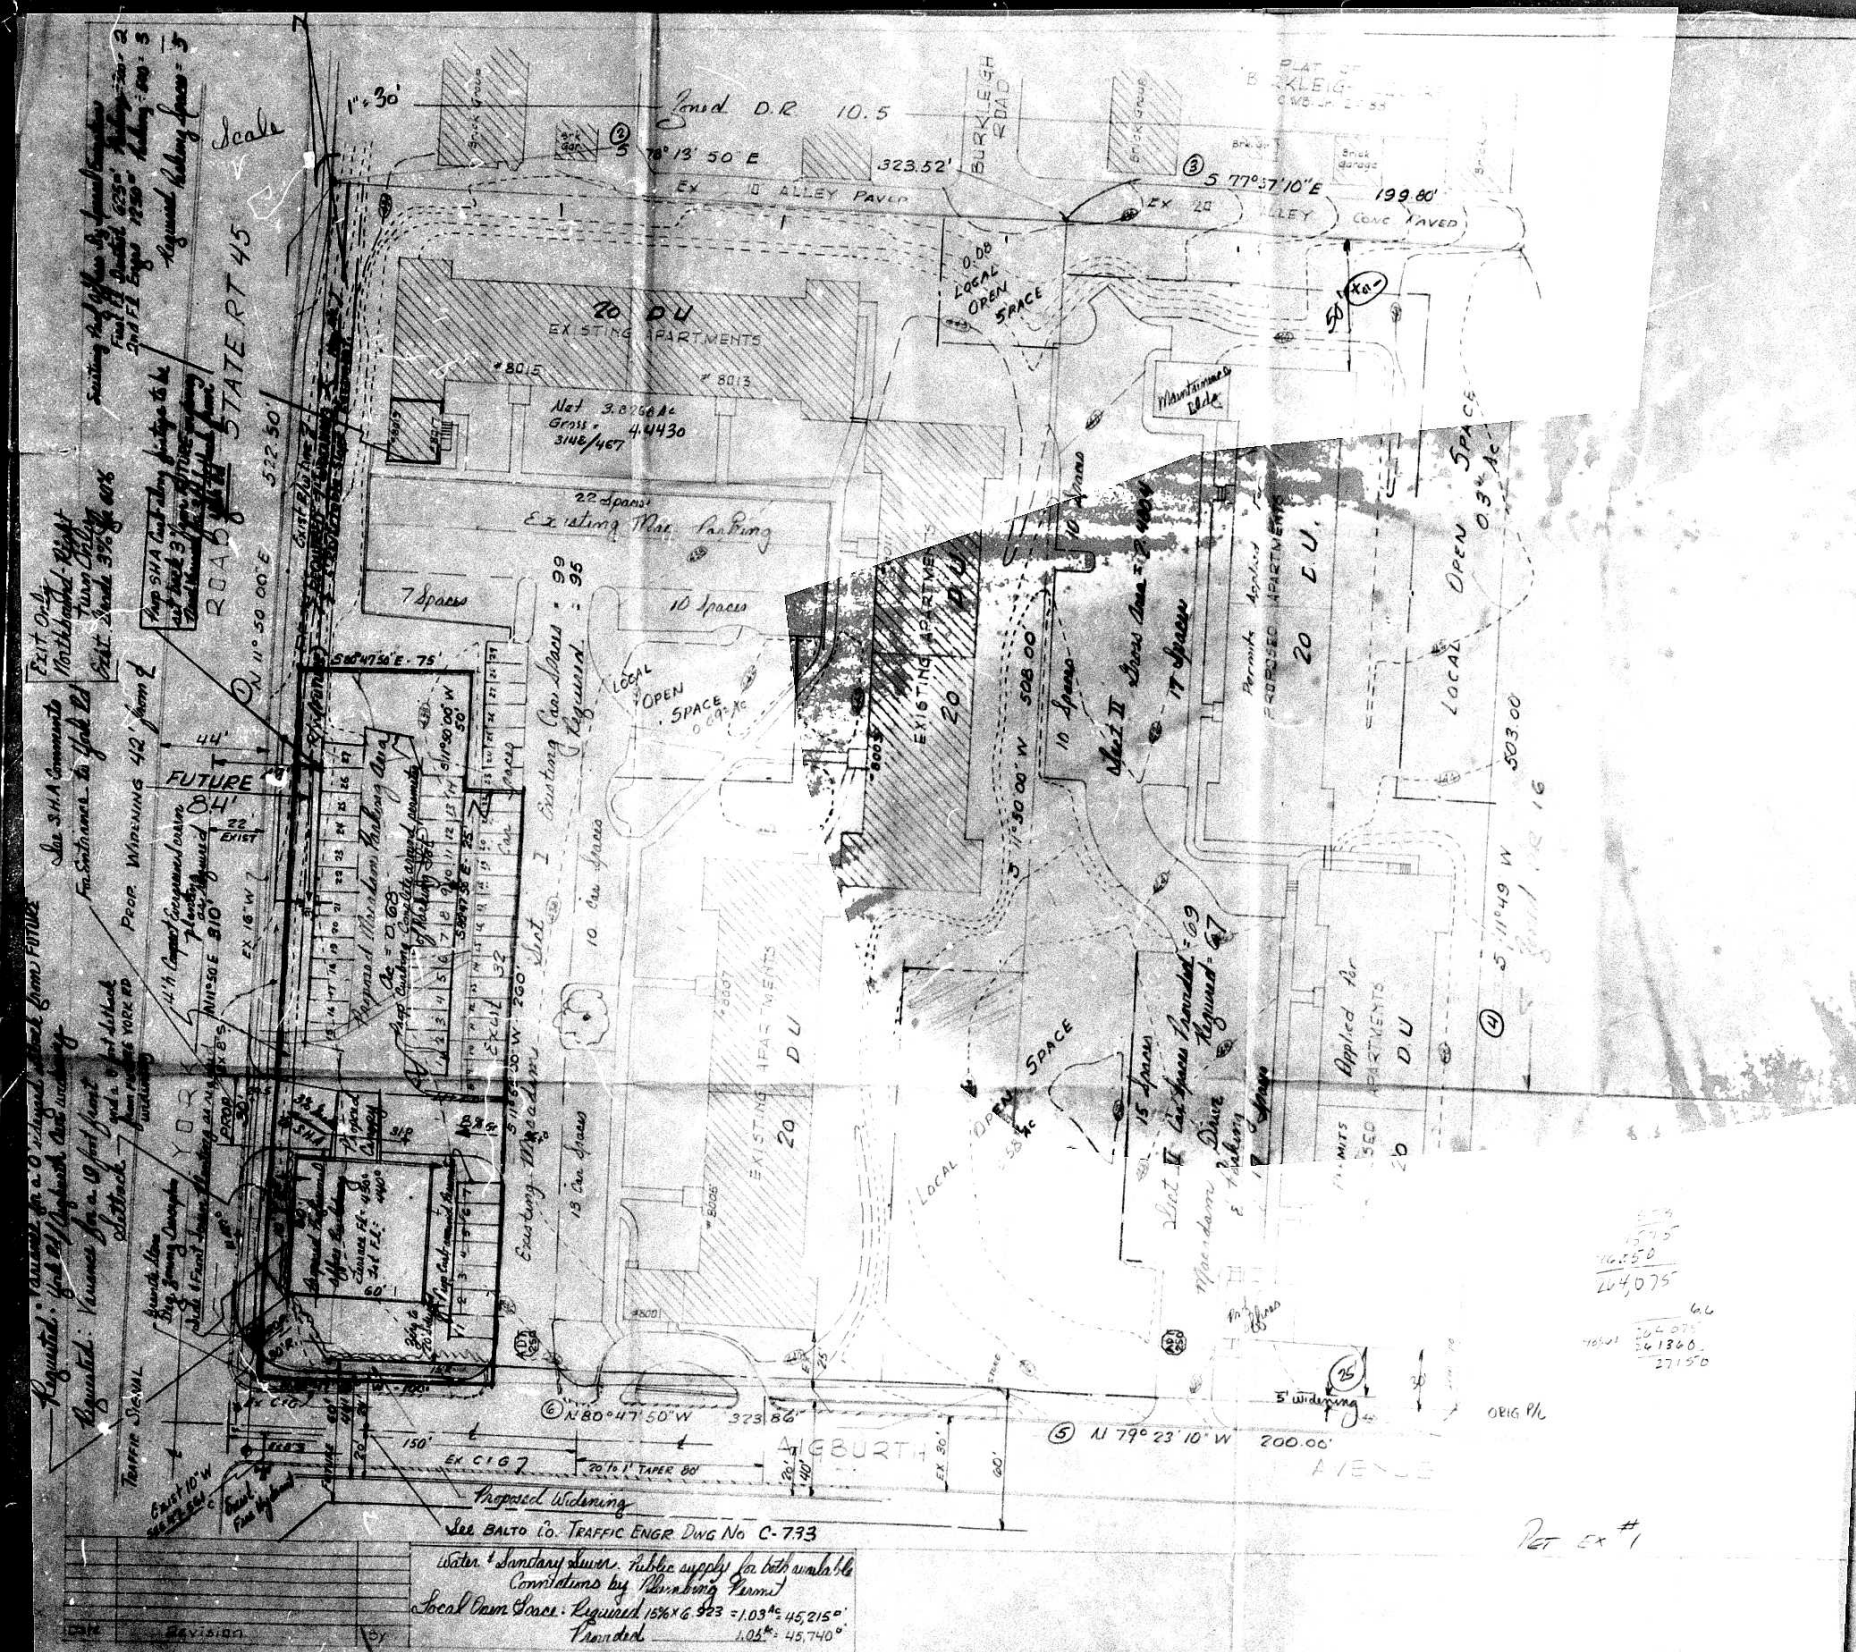

RET Ex #

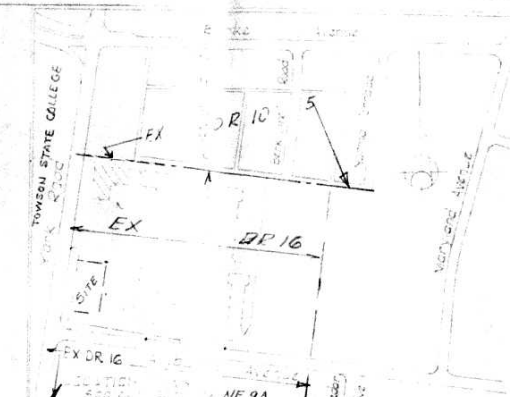

Young Data: Existing Pond DE 16, the Garden Plot
and Area = 6.923 AC of land (Guss)
adjoinable County = 9.223 AC ± 110.77 Units

<u>Existing</u>	<u>Acet II</u>	<u>Acet II</u>
33 Two BR = 53	32 BR = 22	
36 One BR = 27	24 1 BR = 16	
<u>60</u>	<u>40</u>	Ex. 100 Units

Site 2 offices in Dist I City Site 2 offices in Dist II Cities
625' and 1250' ± 760' and 1500' ±
Requires 5 Parking Spaces Requires 5 Parking Spaces

Converting to land Area. $\frac{\text{Acres Allotted}}{\text{Acres Existing}} = \frac{110}{100} \times 6923 = 0.76$
 of this 6.68" Ac of land to be used for Office Building

Working Standard SECT I
 40 DU x 1.53 = 90 Spaces
 20 Officers = 5 "
 95 Spaces

SECT II
 40 DU x 1.53 = 90 Spaces
 6 Officers = 6 "
 67 Spaces

Required 163
 Provided 168 Car Spares
 Tanking Office Elly Required 168 Car Spares
 1st Feb 50x50 = 5000 300 = 12
 1st Feb 50x50 = 5000 300 = 12
 Car Spares
 Required 24
 Provided in source book 27 Car Spares
 See Notes for Pumping & Required Car Spares

Plot for zoning purposes
Cordell Hall Professional Office Building
 for the Hamilton Building 6-3001 flaked from Midtown
 5th Dist. Baltimore County, Maryland

Type of Hearing: Special Exceptions for Officers Office Building in DR 1000
 Regd 30' x: Variance for a 10' front yard setback and a 0' front yard
 setback from FUTURE York Rd widening (to 60')
 Regd 25' x: Variance for a 0' side yard setback from FUTURE York Rd
 widening
 Regd 8' x 3': Variance for a 3' front setback for the parking against the
 FUTURE widening of York Rd with the parking lot
 DEEMED PERM method of the required 8' setback
 RET. EX #1 ✓
 ✓ Oct 29, 1974 Updated: SHA approval / B. B. B. /

✓ Oct. 29, 1974 Updated: SHA approval & Board Res./min
April 17, 74 Updated as per J.W.P.'s Co Meeting
Apr. 13, 1974 Updated as per J. Wondery meeting

James S. Spamer & Associated
Engineers and Surveyors
8017 York Road
Towson, Maryland 21204

Date: [redacted] Scale: [redacted]

YORK
(STATE ROAD)
ROAD

DENSITY TABLE
ZONE DRIG

AREA SECT. I	4.4430 AC
AREA SECT. II	2.8804
AREA SECT. I + SECT. II	6.9234
UNITS ALLOWED I + II * 10	1108 ALLOWED
UNITS EXISTING SECT. I	60
ADDITIONAL UNITS ALLOWED	50 ALLOWED
UNITS PROVIDED SECT. II	40 PROVIDED

EMPTY DENSITY UNITS, SECT. 1:

1B (84 x 0.75)	=	27
2B (33 x 1.0)	=	33
TOTAL	=	60 DENSITY UNITS

DWELLING UNITS : 69

PROP. DENSITY UNITS SECT II:
10 (24 x 0.75) = 18

15 (24 + 10)	= 18
20 (22 + 12)	= 22

TOTAL * 40 DENSITY UNITS

DWELLINGUNITS : 46

SECTS I-III : TOTAL 100 DENSITY UNIT
SECTS I-III : TOTAL 100 DENSITY UNIT

PARKING TABULATION

9x18 STALLS

SECT I 69-153 : 90 REQUIRE

2 OFFICES	5
TOTAL SECT. T	96. REQUIRED

TOTAL SECT I 1 99 PROVIDE

SECT II 40-1.55 61 REQ'D.

OFFICE 1 2
 NAME: NAME: 471 10000

TOTAL SECT II : 67 REQUIRED

10100 0201 2 01 00000000

BOARD OF APPEALS
PETITIONER'S
EXHIBIT 2

LOCAL OPEN SPACE

015-64234 : 104^{AC} REQD
PROVIDED : 105^{AC}
AND MAINTAINED
BY OWNER

CARDIFF HALL EAST APMTS.

JOSEPH L SOLEY

3001 YORK TOWSON MD-21204

9TH DIST. IV C BALTIMORE CO., MD.

I A. W. A. Complete: None DH
 Final Mail Checked: _____


 Engineering: _____
 Street Name: _____
 House No.: _____

TRAVERSE STATIONS


X-3164 { E 3278.65
N 35185.11

X-3165 { E 3177.48
N 34711.93

BALTIMORE COUNTY HEALTH DEPARTMENT APPROVAL	APPROVED FOR BALTIMORE COUNTY PLANNING BOARD	APPROVED FOR STREET ALIGNMENT & LOCATION	The streets and/or roads as shown hereon and the map thereon in herein are for the purpose of descrip- tion only and the same are not intended to be dedicated to public use, the fee simple title to the sub- ject is expressly reserved to the grantors of the deed to which this plan is attached, their heirs and assigns.	OWNERS CERTIFICATE The signers of this form to the effect of Article 17 of the Hosiery Code of Maryland, 1904 Edition, Chapter 104 of the Acts of 1945, as amended by Chaps. 434 and 753 of the Acts of 1947 and subsequent Acts, if any, amend their intent, to file as shown above the plan and street or road to which the same have been applied with.	ENGINEER'S CERTIFICATE I, WILLIAM O. LUETTIG, Jr., a Registered Professional Engineer and Licensed Surveyor of the State of Maryland, do hereby certify that the lines shown hereon have been laid out and the plat thereof has been approved by me in accordance with the provisions of Article 17 of the Hosiery Code of Maryland, 1904 Edition, Chapter 104 of the Acts of 1945, as amended by Chaps. 434 and 753 of the Acts of 1947 and subsequent Acts, if any, amend their intent, to file as shown above the plan and street or road to which the same have been applied with.		JAMES S. SPAMER & ASSOCIATES ENGINEERS & SURVEYORS BOX 9804 TOWSON, MD. 21204	
Deputy State (County) Health Officer	Date	Director	Date	Roads Engineer of Baltimore County	Date	JOSEPH L. SOLEY Chief of Land Division By <i>Joseph L. Soley</i>	Wm. O. Luettig Jr. Professional Engineer No. 2008	SCALE 1" = 50' DATE SEPT 25, 1974

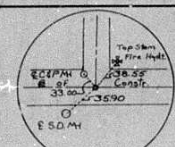


4+91.23 York Rd.
0+00 T.S.C. Entrance

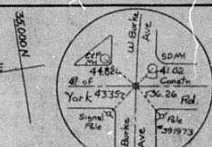

0+57.30 York Rd.
0+03.07 W Burke Ave


TOWSON STATE COLLEGE

Note: Construct steps at each end of walk on 2:1 slope with ornamental railing on both sides of steps, per Baltimore County Standard Details, R-36 and R-37A.

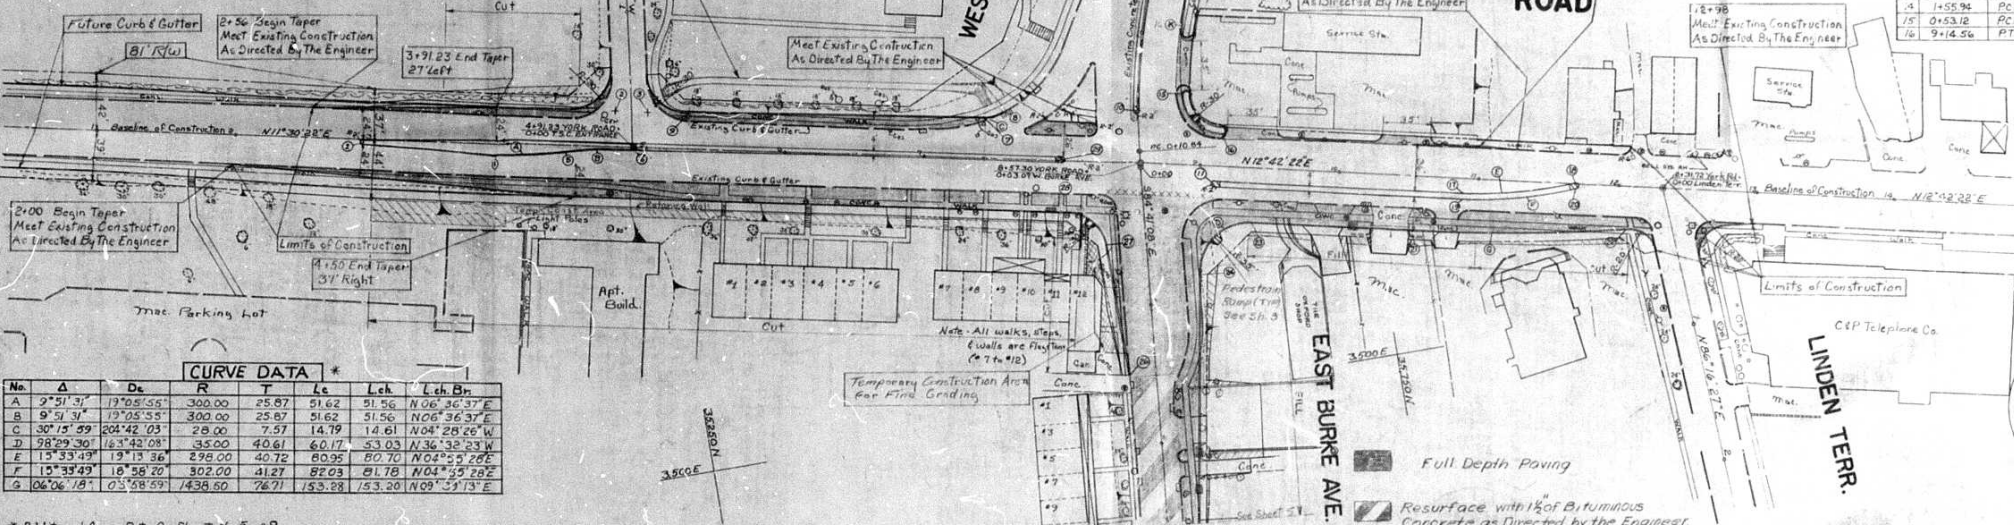

No.	Δ	D _s	R	T	L _e	L _{ch}	L _{ch} B _n
A	9°51'31"	17'05.55"	300.00	25.87	51.62	51.56	N06°36'37"E
B	9°51'31"	17'05.55"	300.00	25.87	51.62	51.56	N06°36'37"E
C	30°15'59"	204'42.03"	29.00	7.57	14.79	14.61	N04°28'05"W
D	98°29'30"	16'34.08"	35.00	40.61	60.17	53.03	N36°32'23"W
E	15°33'49"	19'13.36"	298.00	40.72	80.95	80.70	N04°55'26"E
F	15°33'49"	19'13.36"	302.00	41.27	82.03	81.78	N04°55'26"E
G	06°06'18"	0'35.89"	1438.50	76.71	153.28	153.20	N09°51'13"E

* Additional Curve Data On Sheet No. 5 of 9

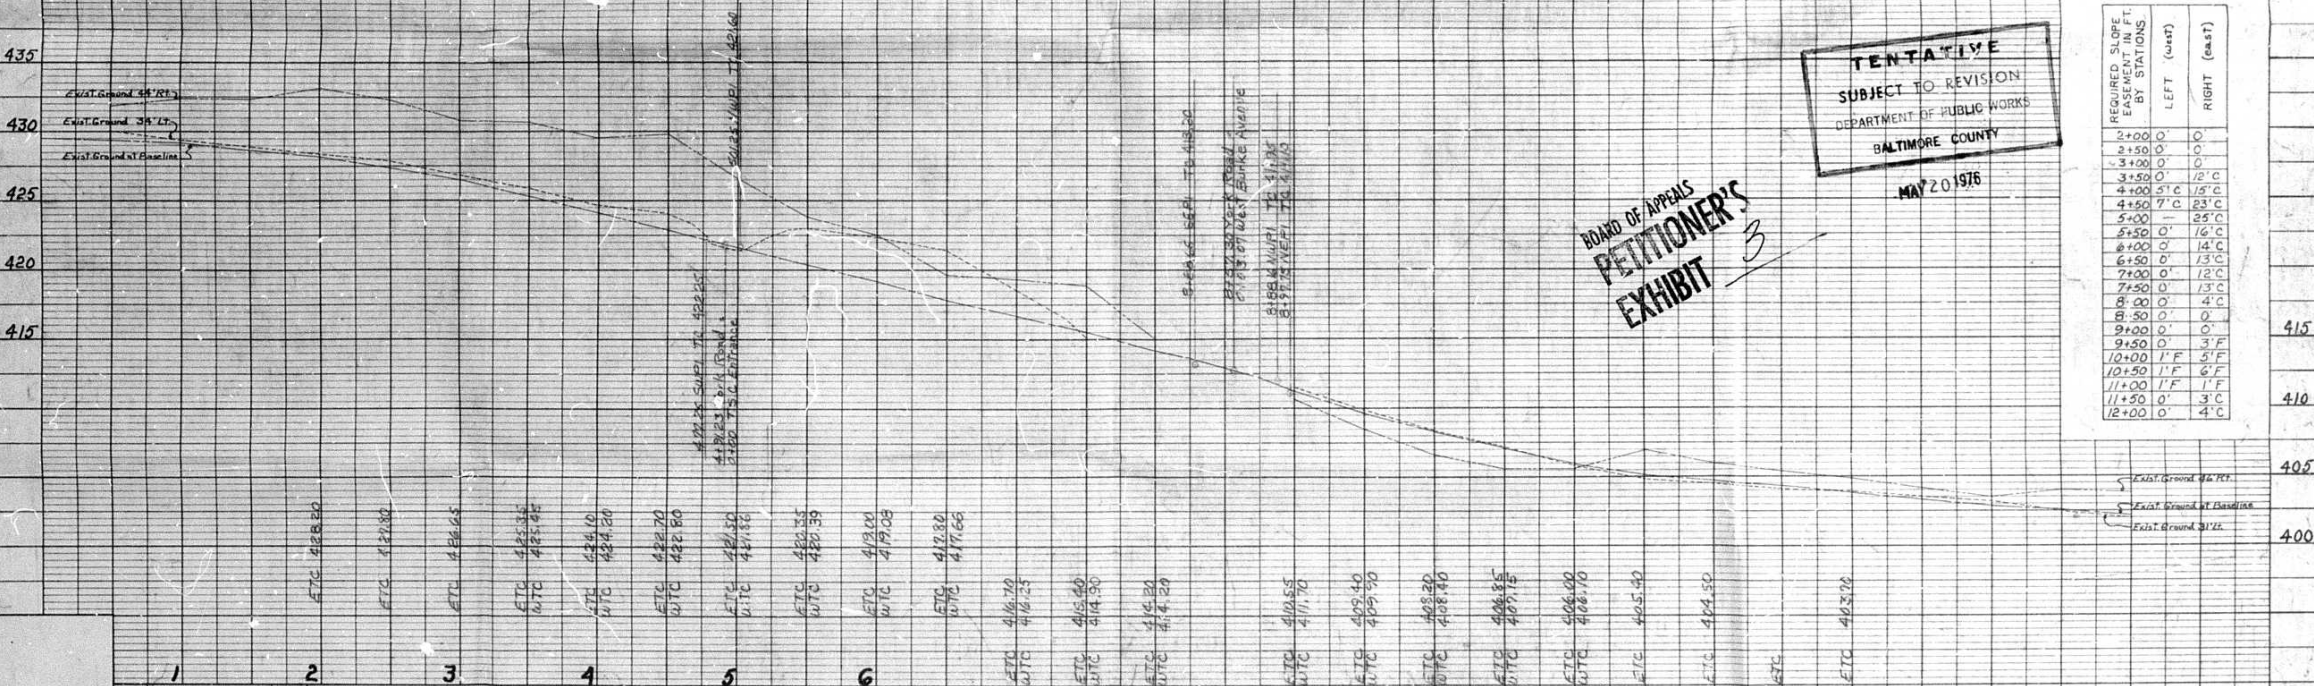


DATE	RIGHT OF WAY	REF.	ROAD PERMIT AND GRADES	P. W. A. DIR. NO.	CONTRACT NO.	REVISED AS PER RECORD PRINT
			PERMIT REQUESTED			J.O. DRAFTSMAN DATE
			PERMIT NUMBER			
			GRADE ESTABLISHED			
			PROFILE NUMBER			


DESIGNED BY	ENGINEER	REVIEWED	CHECKED	DATE	LIC. NO.

BUREAU OF ENGINEERING	DEPARTMENT OF PUBLIC WORKS	LEVEL BK.	KEY SHEET	SCALE
			NNW	1"=50'
			POSITION SHEET	
			36NE3	
APPROVED	APPROVED	DATE	REVISION	BY

BALTIMORE COUNTY	DEPARTMENT OF PUBLIC WORKS	BUREAU OF ENGINEERING
YORK ROAD & BURKE AVENUE		
EL. DISTRICT NO. 9		
BALTIMORE COUNTY TYPE NUMBER 3		

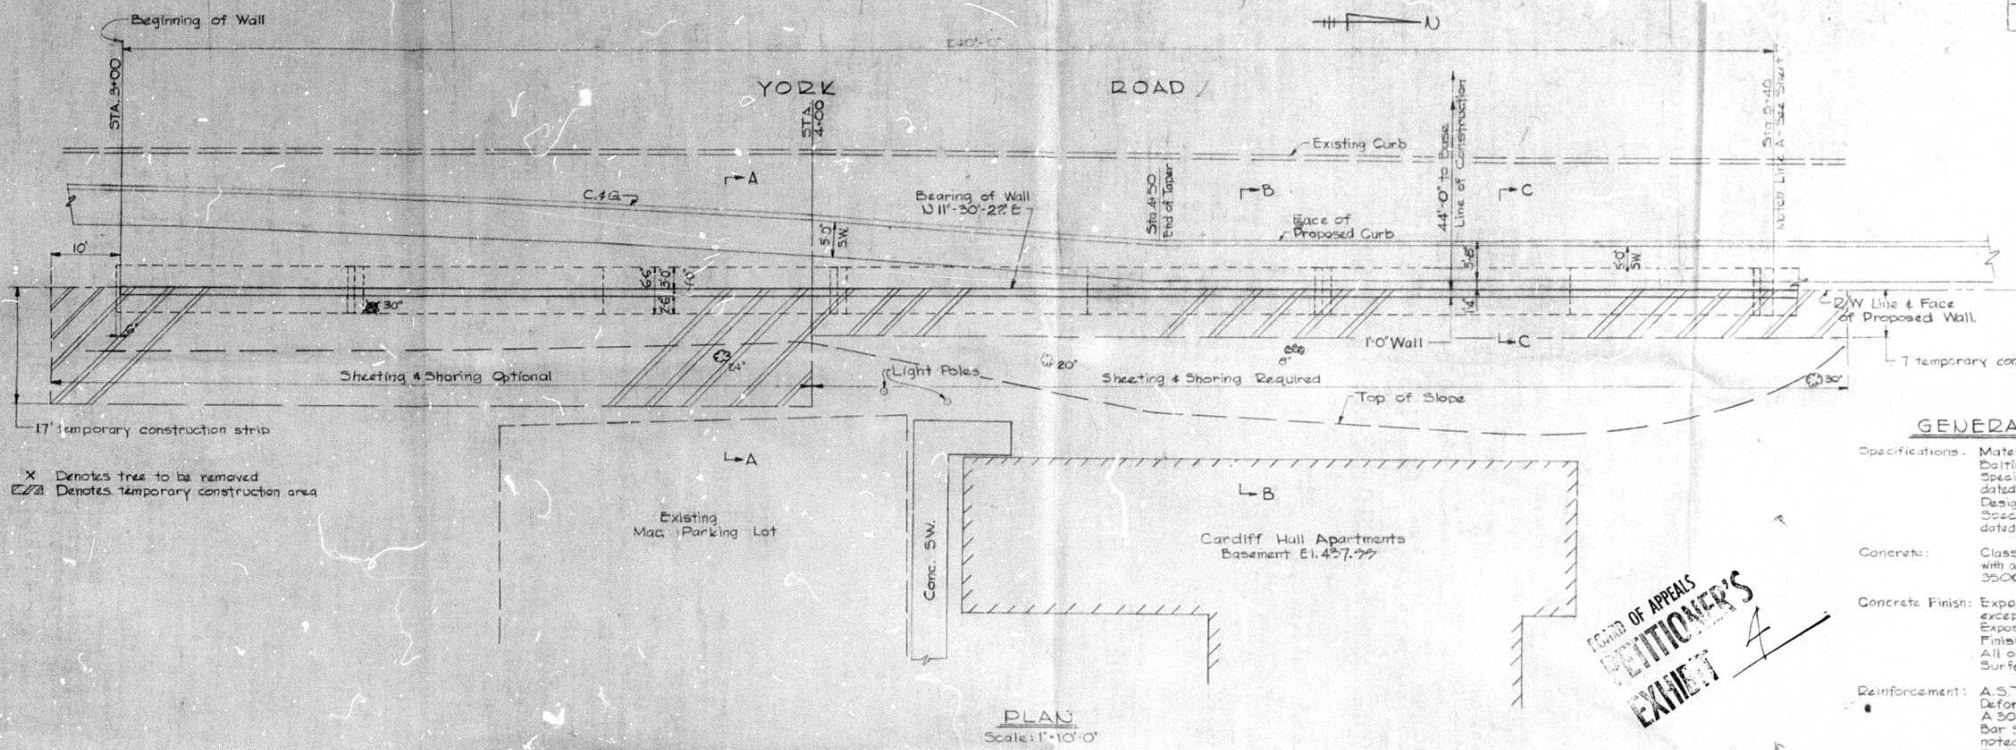

PLAN
Scale: 1"=10'-0"

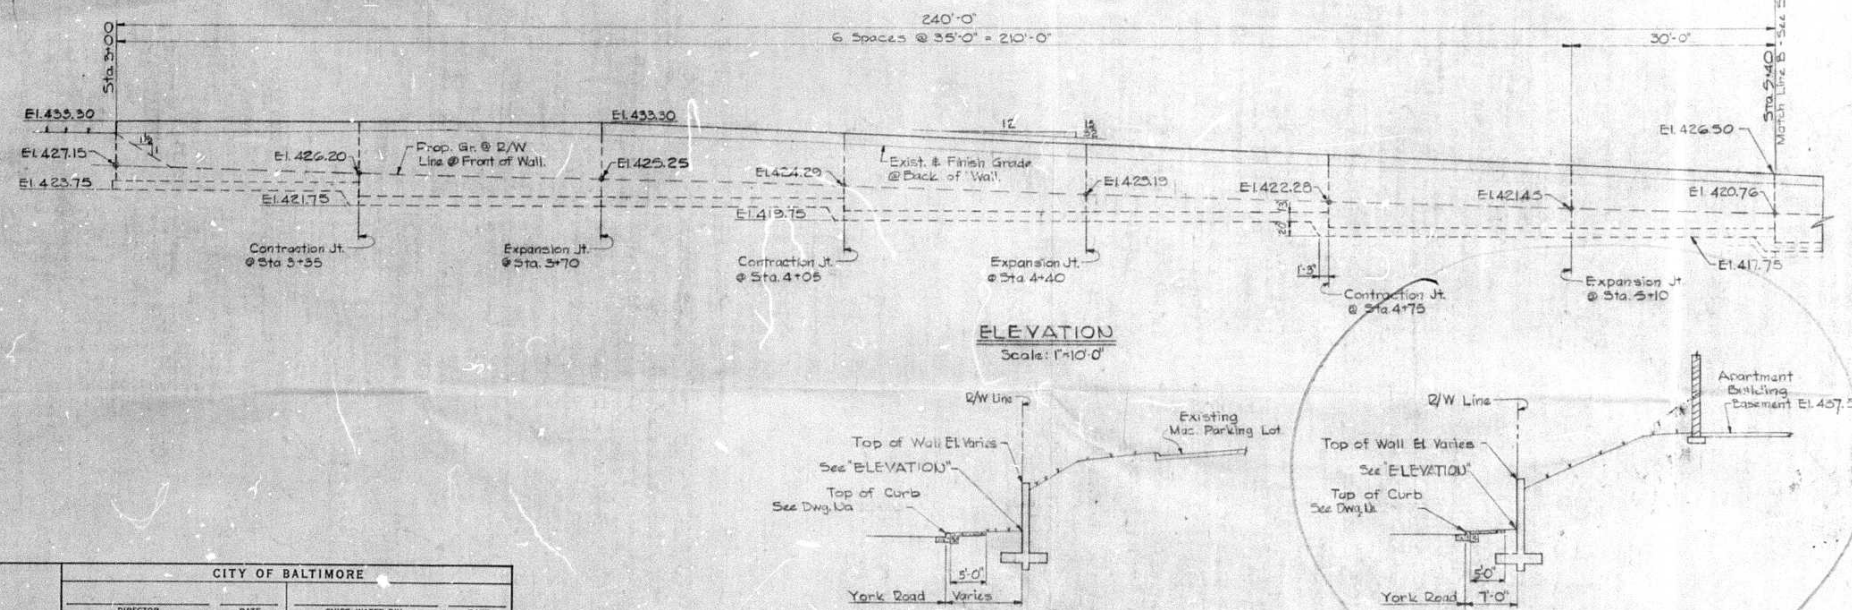

ELEVATION
Scale: 1"=10'-0"

SECTION A-A
STA 3+00 thru STA 4+50
Scale: 1"=10'-0"

SECTION B-B
STA 4+50 thru STA 7+03
Scale: 1"=10'-0"

TENTATIVE
SUBJECT TO REVISION
DEPARTMENT OF PUBLIC WORKS
BALTIMORE COUNTY

MAY 20 1976

CITY OF BALTIMORE																					
DESIGNED BY		DATE		CHIEF, WATER DIV.		DATE															
DIRECTOR		DEPT. OF PUBLIC WORKS		BUREAU OF ENGINEERING		CONTRACT NO.		REVISED AS PER RECORD PRINT													
DATE	RIGHT OF WAY	REF.	ROAD PERMIT AND GRADES	P. W. A. DIR. NO.	CONTRACT NO.	J.O.	DRAFTSMAN	DATE													
PERMITS REQUESTED			PERMIT NUMBER	GRADE ESTABLISHED		PROFILE NUMBER															
<table border="1"> <tr> <th>BUREAU OF ENGINEERING</th> <th>DEPARTMENT OF PUBLIC WORKS</th> <th>LEVEL BK.</th> <th>KEY SHEET</th> </tr> <tr> <td>APPROVED</td> <td>APPROVED</td> <td>10-11/1</td> <td>POSITION SHEET</td> </tr> <tr> <td>DATE</td> <td>DATE</td> <td>SCALE 3</td> <td>DATE</td> </tr> </table>										BUREAU OF ENGINEERING	DEPARTMENT OF PUBLIC WORKS	LEVEL BK.	KEY SHEET	APPROVED	APPROVED	10-11/1	POSITION SHEET	DATE	DATE	SCALE 3	DATE
BUREAU OF ENGINEERING	DEPARTMENT OF PUBLIC WORKS	LEVEL BK.	KEY SHEET																		
APPROVED	APPROVED	10-11/1	POSITION SHEET																		
DATE	DATE	SCALE 3	DATE																		

DESIGNED BY	ENGINEER	REVIEWED	DATE	LIC. NO.	DATE	APPROVED	CHIEF	APPROVED	DIRECTOR	DATE	REVISION	BT	PROFILE	VERT.	SCALE	BALTIMORE COUNTY DEPT. OF PUBLIC WORKS BUREAU OF ENGINEERING	JOB ORDER NO.	5-286-16	SHEET 7 OF 9	DWG. NO.	73-0097	FILE: 5
-------------	----------	----------	------	----------	------	----------	-------	----------	----------	------	----------	----	---------	-------	-------	--	---------------	----------	--------------	----------	---------	---------