



Pursuant to the advertisement, posting of property, and public hearing on the above petition and it appearing that by reason of the following finding of facts that strict compliance with the Baltimore County Zoning Regulations would result in practical difficulty and unreasonable hardship upon the Petitioner, the Variances should be had; and it further appearing that by reason of the granting of the Variances requested not adversely affecting the health, safety, and general welfare of the community, Variances to permit a front yard of 10 feet instead of the required 25 feet, a building 45 feet from the center line of a street (Joppa Road) instead of the required 50 feet, to permit and validate an existing side yard of 3 feet instead of the required 30 feet, a new motel addition with a side yard of zero feet instead of the required 30 feet, and to permit and validate an existing nonconforming front yard of 10 feet instead of the required 30.5 feet, based upon the setback averages of structures on adjoining properties, should be granted.

IT IS ORDERED by the Deputy Zoning Commissioner of Baltimore County, this 27th day of February, 1978, that the herein Petition for the aforementioned Variances should be and the same are GRANTED, from and after the date of this Order, subject to the approval of a site plan by the Department of Public Works and the Office of Planning and Zoning.

*[Signature]*  
Deputy Zoning Commissioner of  
Baltimore County

# BALTIMORE COUNTY ZONING PLANS ADVISORY COMMITTEE

COUNTY OFFICE BLDG.  
111 W. Chesapeake Ave.  
Towson, Maryland 21204

cc: Nicholas B. Commodari  
Chairman

MEMBERS  
Bureau of Engineering  
Department of Traffic Engineering  
Department of State Roads Commission  
Bureau of Fire Protection  
Health Department  
Project Planning  
Building Department  
Board of Education  
Bureau of Conservation  
Industrial Development

December 6, 1977

James D. Nolan, Esquire  
Nolan, Plunhoff & Williams  
204 West Pennsylvania Avenue  
Towson, Maryland 21204

RE: Variance Petition  
Item Number 70  
Petitioner - Towson Enterprises

Dear Mr. Nolan:

The Zoning Plans Advisory Committee has reviewed the plans submitted with the above referenced petition and has made an on site field inspection of the property. The following comments are a result of this review and the appropriateness of the zoning action requested, but to assure that all parties are made aware of plans or have a bearing on this case. The Director of Planning with recommendations as to the suitability of the requested zoning.

Located on the south side of Joppa Road, just east of Danway Road in the 9th Election District, this B.R. of the Towson East Hotel. Adjacent properties to the east and west consist of a tire store and gas station, respectively, while row homes exist immediately to the rear of this site. Because of your client's proposal to construct a four-room addition to the side of the line, this Variance is necessitated. As indicated in previous conversation with Mr. Williams, the non-conforming setbacks of the existing structure are also included with this request in order to "legalize" these setbacks.

James D. Nolan, Esquire  
Page 2  
Item Number 70  
December 6, 1977

I have been unable to schedule this petition for a hearing date because the required front setback cannot be determined until the setbacks of the tire store to the east and the canopy to the west are dimensioned to the front property line. I verbally indicated this to Mr. Williams earlier and for this reason I did not forward formal written comments. However, since the site plans were not revised, I have now decided to do so.

This petition is being withheld from a hearing date until such time as revised plans are received that reflect the comments above, and any comments from other departments as requested.

Very truly yours,

*Nicholas B. Commodari*  
NICHOLAS B. COMMODARI  
Chairman  
Zoning Plans Advisory Committee

NBC:rf

cc: MCA Engineering Corporation  
1020 Cromwell Bridge Road  
Baltimore, Maryland 21204

Baltimore County  
Department of Public Works  
TOWSON, MARYLAND 21204

THORNTON M. MAURING, P.E.  
DIRECTOR

November 30, 1977

Mr. S. Eric DiNenna  
Zoning Commissioner  
County Office Building  
Towson, Maryland 21204

Re: Item #70 (1977-1978)  
Property Owner: Towson Enterprises, Inc.  
S/S Joppa Rd. 510' W. Pleasant Plains Rd.  
Existing Zoning: Variance to permit a front setback of 10' and 45' from the center of Joppa Rd. in lieu of the required 25' and 50', respectively and side setbacks of 0' and 3' in lieu of the required 30' and a rear setback of 17' in lieu of the required 30'.  
Acres: 1.103 District: 9th

Dear Mr. DiNenna:

The following comments are furnished in regard to the plan submitted to this office for review by the Zoning Advisory Committee in connection with the subject item.

## General:

Baltimore County highway and utility improvements are not directly involved. The Petitioner must provide necessary drainage facilities (temporary or permanent) to prevent creating any nuisances or damages to adjacent properties, especially by the concentration of surface waters. Correction of any problem which may result, due to improper grading or improper installation of drainage facilities, would be the full responsibility of the Petitioner.

Additional fire hydrant protection is required in the vicinity.

Very truly yours,

*Ellsworth N. Dwyer, P.E.*  
ELLSWORTH N. DWYER, P.E.  
Chief, Bureau of Engineering

END-EAN:FWB:RS

cc: W. Munchel

H-W Key Sheet  
36 NE 9 Pos. Sheet  
NE 9 C Type  
70 Tax Map

November 1, 1977

Mr. Eric S. DiNenna, Zoning Commissioner  
Zoning Advisory Committee  
Office of Planning and Zoning  
Baltimore County Office Building  
Towson, Maryland 21204

Dear Mr. DiNenna:

Comments on Item #70, Zoning Advisory Committee Meeting, October 18, 1977, are as follows:

Property Owner: Towson Enterprises, Inc.  
Location: S/S Joppa Road 510' W Pleasant Plains Road  
Existing Zoning: B & L and B.R. - C.N.S.  
Proposed Zoning: Variance to permit a front setback of 10' and 45' from the center of Joppa Road in lieu of the required 25' and 50' respectively and side setbacks of 0' and 3' in lieu of the required 30' and a rear setback of 17' in lieu of the required 30'.  
Acres: 1.103  
District: 9th

This office has reviewed the subject petition and offers the following comments. These comments are not intended to indicate the appropriateness of the zoning in question, but are to assure that all parties are made aware of plans or problems with regard to development plans that may have a bearing on this petition.

This plan has been reviewed and there are no site-planning factors requiring comment.

Very truly yours,

*John L. Wimbley*  
John L. Wimbley  
Planner III  
Project and Development Planning

Baltimore County  
Department of Traffic Engineering  
TOWSON, MARYLAND 21204  
301-484-3900

STEPHEN E. COLLINS  
DIRECTOR

October 27, 1977

Mr. Eric S. DiNenna  
Zoning Commissioner  
1st Floor, County Office Building  
Towson, Maryland 21204

Re: Item 70 - ZAC - October 18, 1977  
Property Owner: Towson Enterprises, Inc.  
Location: S/S Joppa Rd. 510' W Pleasant Plains Rd.  
Existing Zoning: B.R. & B.R. - C.N.S.  
Proposed Zoning: Variance to permit a front setback of 10' and 45' from the center of Joppa Rd. in lieu of the required 25' and 50' respectively and side setbacks of 0' and 3' in lieu of the required 30' and a rear setback of 17' in lieu of the required 30'.  
Acres: 1.103  
District: 9th

Dear Mr. DiNenna:

No traffic problems are anticipated by the requested variance.

Very truly yours,

*C. Richard Moore*  
C. Richard Moore  
Assistant Traffic Engineer

CRM/cwm

Baltimore County  
Department of Health  
TOWSON, MARYLAND 21204  
301-484-3900

DONALD J. ROOP, M.D., M.P.H.  
DEPUTY STATE AND COUNTY HEALTH OFFICER

November 1, 1977

Mr. S. Eric DiNenna, Zoning Commissioner  
Office of Planning and Zoning  
County Office Building  
Towson, Maryland 21204

Dear Mr. DiNenna:

Comments on Item #70, Zoning Advisory Committee Meeting of October 18, 1977 are as follows:

Property Owner: Towson Enterprises, Inc.  
Location: S/S Joppa Road 510' W Pleasant Plains Road  
Existing Zoning: B.R. and B.R. - C.N.S.  
Proposed Zoning: Variance to permit a front setback of 10' and 45' from the center of Joppa Road in lieu of the required 25' and 50' respectively and side setbacks of 0' and 3' in lieu of the required 30' and a rear setback of 17' in lieu of the required 30'.  
Acres: 1.103  
District: 9th

Metropolitan water and sewer are available, therefore, no health hazards are anticipated.

Very truly yours,

*Thomas N. Devlin*  
Thomas N. Devlin, Director  
BUREAU OF ENVIRONMENTAL SERVICES

KS:jlr

Baltimore County  
Fire Department  
TOWSON, MARYLAND 21204  
301-484-3900

Paul H. Reincke  
Chief

Office of Planning and Zoning  
Baltimore County Office Building  
Towson, Maryland 21204

Attention: N. Commodari, Chairman  
Zoning Advisory Committee

Re: Property Owner: Towson Enterprises, Inc.

Location: S/S Joppa Rd. 510' W Pleasant Plains Rd.

Item No. 70 Zoning Agenda Meeting of 10/16/77

Comments:

Pursuant to your request, the referenced property has been surveyed by this Bureau and the comments below marked with an "M" are applicable and required to be corrected or incorporated into the final plans for the property.

1. Fire hydrants for the referenced property are required and shall be located at intervals of 100' along an approved road in accordance with Baltimore County Standards as published by the Department of Public Works.
2. A second means of vehicle access is required for the site.
3. The vehicle dead-end condition shown at \_\_\_\_\_
4. The site shall be made to comply with all applicable parts of the Fire Prevention Code prior to occupancy or beginning of operations.
5. The buildings and structures existing or proposed on the site shall comply with all applicable requirements of the National Fire Protection Association Standard No. 10 "Fire Safety Code", 1970 Edition prior to occupancy.
6. Site plans are approved as drawn.
7. The Fire Prevention Bureau has no comments at this time.

Noted and Approved: *[Signature]*  
Special Inspection Division Fire Prevention Bureau

October 11, 1977

Mr. S. Eric DiNenna, Zoning Commissioner  
Office of Planning and Zoning  
County Office Building  
Towson, Maryland 21204

Dear Mr. DiNenna:

Comments on Item # 70 Zoning Advisory Committee Meeting, October 18, 1977  
are as follows:

Property Owner: Towson Enterprises, Inc.  
Location: S/S Joppa Road - 510' W. Pleasant Plains Road  
Existing Zoning: B.R. & S.B. - C.N.S.  
Proposed Zoning: Variance to permit a front setback of 10' and 15' from the center of Joppa Rd. in lieu of the required 25' and 50' respectively and side setbacks of 0' and 3' in lieu of the required 30' and a rear setback of 17' in lieu of the required 30'.  
Acres: 1.103  
District: 9th

The items checked below are applicable:

- ☒ A. Structure shall conform to Baltimore County Building Code (B.O.C.A.) 1970 Edition and the 1971 Supplement and other applicable codes.
- ☒ B. A building permit shall be required before construction can begin.
- ☒ C. Three sets of construction drawings will be required to file an application for a building permit.
- ☒ D. Three sets of construction drawings with a registered Maryland Architect or Engineer's original seal will be required to file an application for a building permit.
- ☒ E. Wood frame walls are not permitted within 3'0" of a property line. Contact Building Department if distance is between 3'0" and 6'0" of property line.
- ☐ F. No comment.
- ☐ G. Requested setback variance conflicts with the Baltimore County Building Code. See Section \_\_\_\_\_.

Very truly yours,

*Charles E. Burbanck*  
Charles E. Burbanck  
Plans Review Chief  
CDB:rrj

January 18, 1978

Mr. S. Eric DiNenna, Zoning Commissioner  
Office of Planning and Zoning  
County Office Building  
Towson, Maryland 21204

Dear Mr. DiNenna:

Comments on Item # 70 Zoning Advisory Committee Meeting, January 10, 1978  
are as follows:

Property Owner: Towson Enterprises, Inc.  
Location: S/S Joppa Road - 510' W. Pleasant Plains Road  
Existing Zoning: B.R. & S.B. - C.N.S.  
Proposed Zoning: Variance to permit a front setback of 10' and 15' from the center of Joppa Rd. in lieu of the required 25' and 50' respectively and side setbacks of 0' and 3' in lieu of the required 30' and a rear setback of 17' in lieu of the required 30'.  
Acres: 1.103  
District: 9th

The items checked below are applicable:

- ☒ A. Structure shall conform to Baltimore County Building Code (B.O.C.A.) 1970 Edition and the 1971 Supplement and other applicable codes.
- ☒ B. A building permit shall be required before construction can begin.
- ☒ C. Three sets of construction drawings will be required to file an application for a building permit.
- ☒ D. Three sets of construction drawings with a registered Maryland Architect or Engineer's original seal will be required to file an application for a building permit.
- ☒ E. Wood frame walls are not permitted within 3'0" of a property line. Contact Building Department if distance is between 3'0" and 6'0" of property line.
- ☒ F. Height & area requirements and type of construction shall be documented by a registered architect before any further consideration by this department.
- ☐ G. Requested setback variance appears to conflict with the Baltimore County Building Code. See Section Table 6 Sect 206.0, 306.3

Very truly yours,

*Charles E. Burbanck*  
Charles E. Burbanck  
Plans Review Chief  
CDB:rrj

# BOARD OF EDUCATION OF BALTIMORE COUNTY

TOWSON, MARYLAND - 21204

Date: October 14, 1977

Mr. S. Eric DiNenna  
Zoning Commissioner  
Baltimore County Office Building  
Towson, Maryland 21204

Z.A.C. Meeting of: October 18, 1977

RE: Item No: 70  
Property Owner: Towson Enterprises, Inc.  
Location: S/S Joppa Rd. 510' W Pleasant Plains Rd.  
Present Zoning: B.R. & S.B.-C.N.S.  
Proposed Zoning: Variance to permit a front setback of 10' and 15' from the center of Joppa Rd. in lieu of the required 25' and 50' respectively and side setbacks of 0' and 3' in lieu of the required 30' and a rear setback of 17' in lieu of the required 30'.

District: 9th  
No. Acres: 1.103

Dear Mr. DiNenna:

No hearing on student population.

Very truly yours,


*W. Nick Petrovich*  
W. Nick Petrovich,  
Field Representative

WSP/bp

JOSEPH M. MCGOWAN, VICEPRES  
T. HAROLD WILLIAMS, JR., VICEPRESIDENT  
MARCOUS H. ROTUNDO

THOMAS M. RYDER  
MR. LOU BARRIE & CHURCH  
ROBERT W. HARTMAN

ALVIN LOURECK  
MR. MORTON M. SMITH, JR.  
RICHARD W. HARTY, JR.

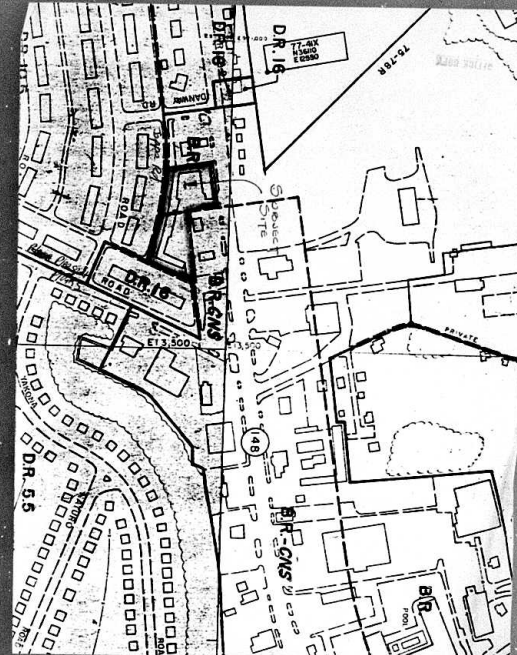

## CERTIFICATE OF PUBLICATION

TOWSON, MD. January 12, 1978.

THIS IS TO CERTIFY, that the annexed advertisement was published in THE JEFFERSONIAN, a weekly newspaper printed and published in Towson, Baltimore County, Md. newspaper OK 506 line successive weeks before the 30th day of January, 1978, the ANN publication appearing on the 12th day of January, 1978.

THE JEFFERSONIAN,

*Handwritten signature*  
Manager.

Cost of Advertisement, \$ \_\_\_\_\_



TOWSON, MD. 21204 January 12 1978

THIS IS TO CERTIFY, that the annexed advertisement of PETITION FOR VARIANCE - Towson Enterprises, Inc. was inserted in the following:

- ☐ Catonsville Times
- ☐ Dundalk Times
- ☐ Essex Times
- ☐ Suburban Times East
- ☒ Towson Times
- ☐ Arbutus Times
- ☐ Community Times
- ☐ Suburban Times West

weekly newspapers published in Baltimore County, Maryland, once a week for one successive weeks before the 12th day of January, 1978, that is to say, the same was inserted in the issues of January 12, 1978

STROMBERG PUBLICATIONS, INC.

BY *Handwritten signature*

## CERTIFICATE OF POSTING ZONING DEPARTMENT OF BALTIMORE COUNTY Towson, Maryland

#78-153-A

District: 9th Date of Posting: 1-12-78  
Posted for: Henry Massey, Jan. 30, 1978, 9:11 AM  
Petitioner: Towson Enterprises, Inc.  
Location of property: S/S Joppa Rd. 510' W. of Pleasant Plains Rd.  
Location of Sign: S. Joppa Rd. 510' W. of Pleasant Plains Rd.  
Remarks: S. Joppa Rd.  
Posted by: *Handwritten signature*  
Signature Date of return: 1-19-78

BALTIMORE COUNTY OFFICE OF PLANNING AND ZONING

County Office Building  
111 W. Chesapeake Avenue  
Towson, Maryland 21204

Your Petition has been received \* this 7th day of October 1977 Filing Fee \$ 25.00 Received ☒ Cash ☐ Other

*Handwritten signature*  
S. Eric DiNenna, Zoning Commissioner  
Petitioner: *Handwritten signature* Submitted by *Handwritten signature*  
Petitioner's Attorney: *Handwritten signature* Reviewed by *Handwritten signature*

\* This is not to be interpreted as acceptance of the Petition for assignment of a hearing date.

BALTIMORE COUNTY, MARYLAND  
OFFICE OF FINANCE, REVENUE DIVISION  
MISCELLANEOUS CASH RECEIPT

No. 65425

DATE Jan. 30, 1978 ACCOUNT 01-662

AMOUNT \$75.00

RECEIVED Messrs. Eolan, Plimhoff and Williams, 204 W. FURCA AVE., TOWSON, MD. 21204  
Advertising and posting of property for Towson Enterprises, Inc. #78-153-A

750 CNE

BALTIMORE COUNTY, MARYLAND  
OFFICE OF FINANCE, REVENUE DIVISION  
MISCELLANEOUS CASH RECEIPT


No. 57394

DATE JANUARY 5, 1978 ACCOUNT 01-662

AMOUNT \$25.00

RECEIVED Messrs. Eolan, Plimhoff and Williams, 204 W. FURCA AVE., TOWSON, MD. 21204  
FOR Petition for Variance for Towson Enterprises, Inc. #78-153-A

250 CNE


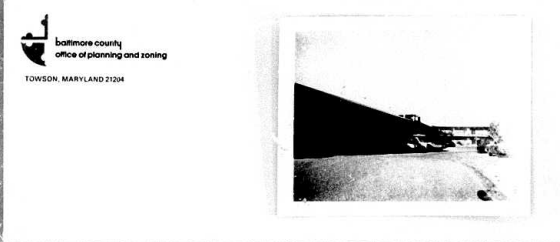




Scale 1"=200'

PET.  
EXHIBIT 2  
17-4 NW  
#2

4

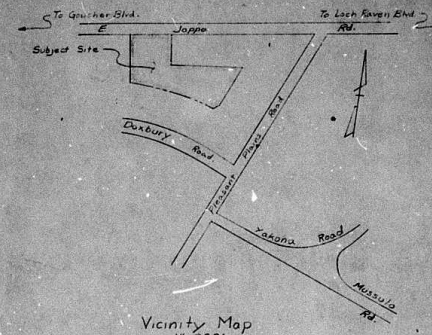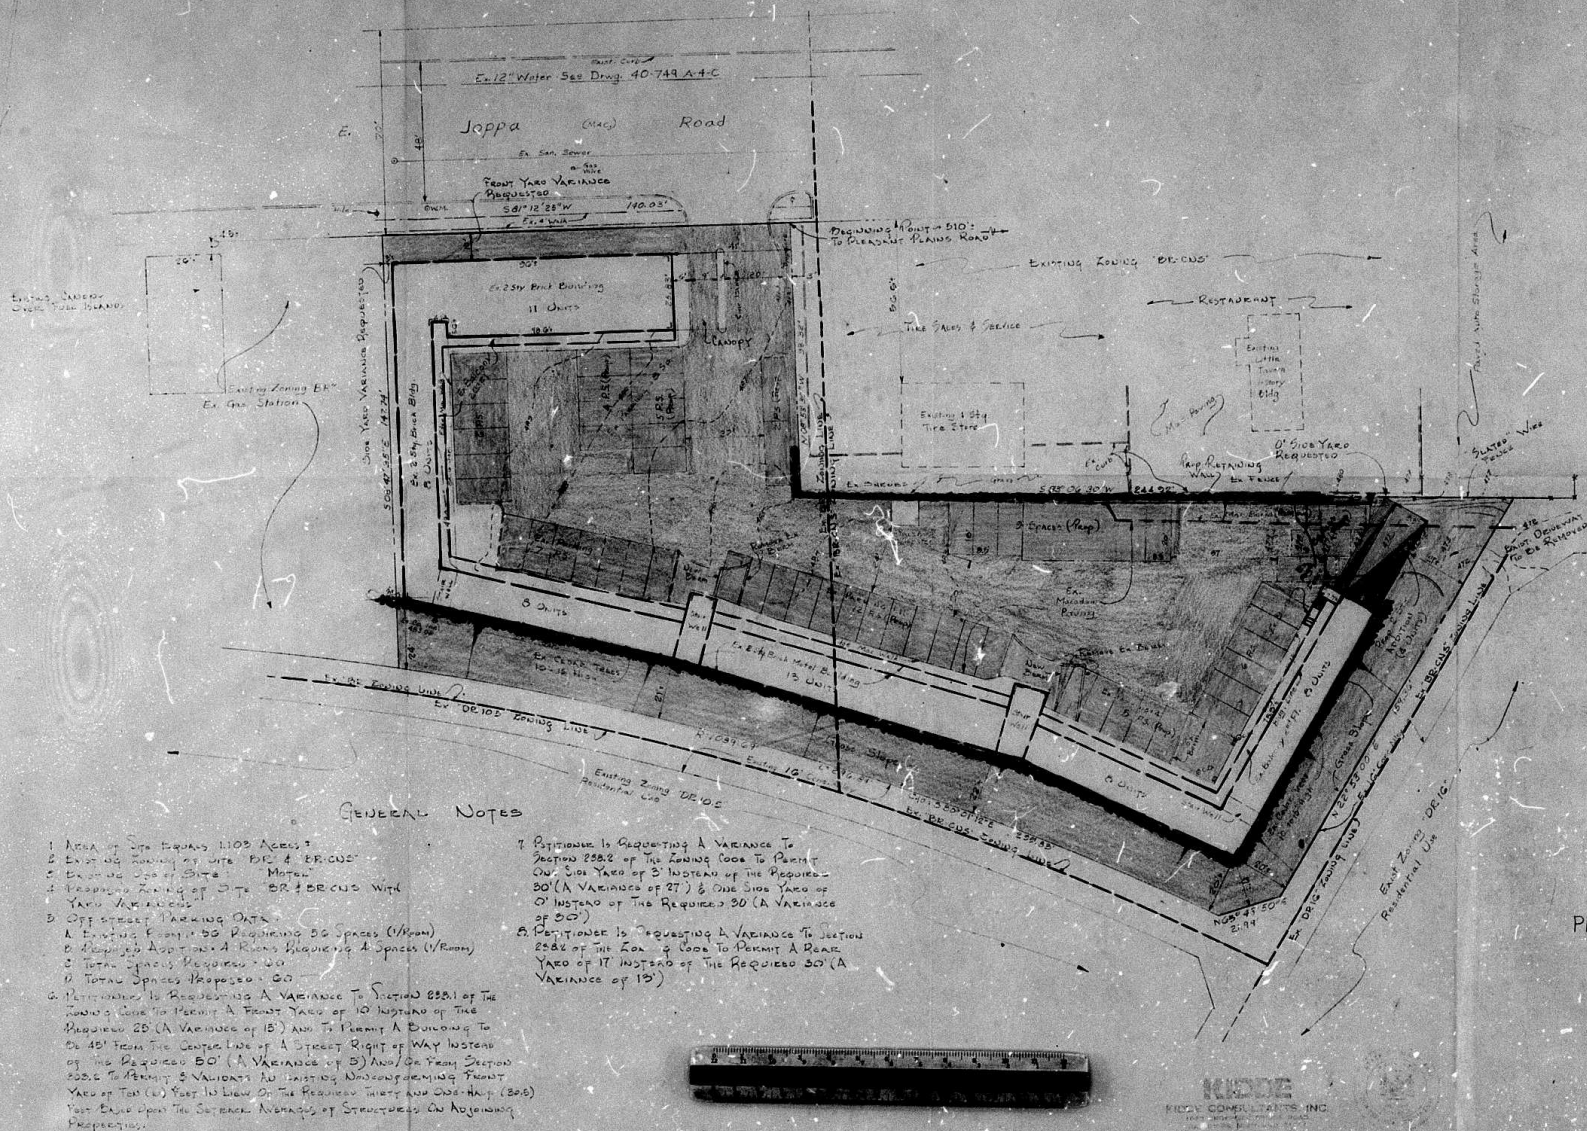

# GENERAL NOTES

1. AREA OF SITE APPROX. 1.103 ACRES
2. EXISTING BUILDING OF SITE DE-100 & DE-100
3. EXISTING USE OF SITE: MOTEL
4. PROPOSED BUILDING OF SITE: DE-100 & DE-100 WITH YARD VARIANCES
5. OFF STREET PARKING DATA:
  - A. EXISTING FRONT YD. REQUIRING 50 SPACES (1/1000)
  - B. PROPOSED ADDITION A REQUIRES REQUIRING 4 SPACES (1/1000)
  - C. TOTAL SPACES REQUIRED: 54
  - D. TOTAL SPACES PROPOSED: 50
6. PETITIONER IS REQUESTING A VARIANCE TO SECTION 258.2 OF THE ZONING CODE TO PERMIT A FRONT YARD OF 10' INSTEAD OF THE REQUIRED 20' (A VARIANCE OF 10') AND TO PERMIT A BUILDING TO BE 45' FROM THE CENTER LINE OF A STREET RIGHT OF WAY INSTEAD OF THE REQUIRED 50' (A VARIANCE OF 5') AND/OR FROM SECTION 258.2 TO PERMIT 3' VARIANCE IN EXISTING UNCONFINED FRONT YARD OF 10' YARD INSTEAD OF THE REQUIRED THIRTY AND ONE HUNDRED (301) YARD FROM THE CENTER LINE OF STRUCTURES ON ADJOINING PROPERTIES.

7. PETITIONER IS REQUESTING A VARIANCE TO SECTION 258.2 OF THE ZONING CODE TO PERMIT OUT LOT YARD OF 5' INSTEAD OF THE REQUIRED 30' (A VARIANCE OF 25') & ONE SIDE YARD OF 0' INSTEAD OF THE REQUIRED 30' (A VARIANCE OF 30')
8. PETITIONER IS REQUESTING A VARIANCE TO SECTION 258.2 OF THE ZONING CODE TO PERMIT A REAR YARD OF 17' INSTEAD OF THE REQUIRED 30' (A VARIANCE OF 13')



## PETITIONERS EXHIBIT #1

Plat To Accompany Petition

For  
Yard Variances  
At  
Townson East Motel

Election District 9 Baltimore County Md.  
Scale: 1"=20' Date: Sept. 1, 1977  
Revision: Dec. 21, 1977

EX. #1

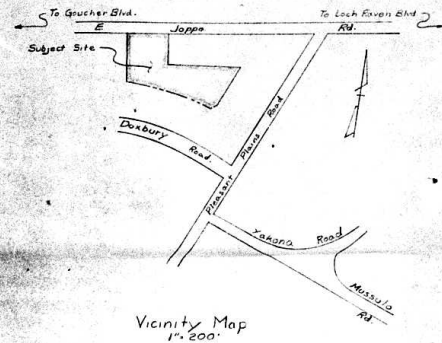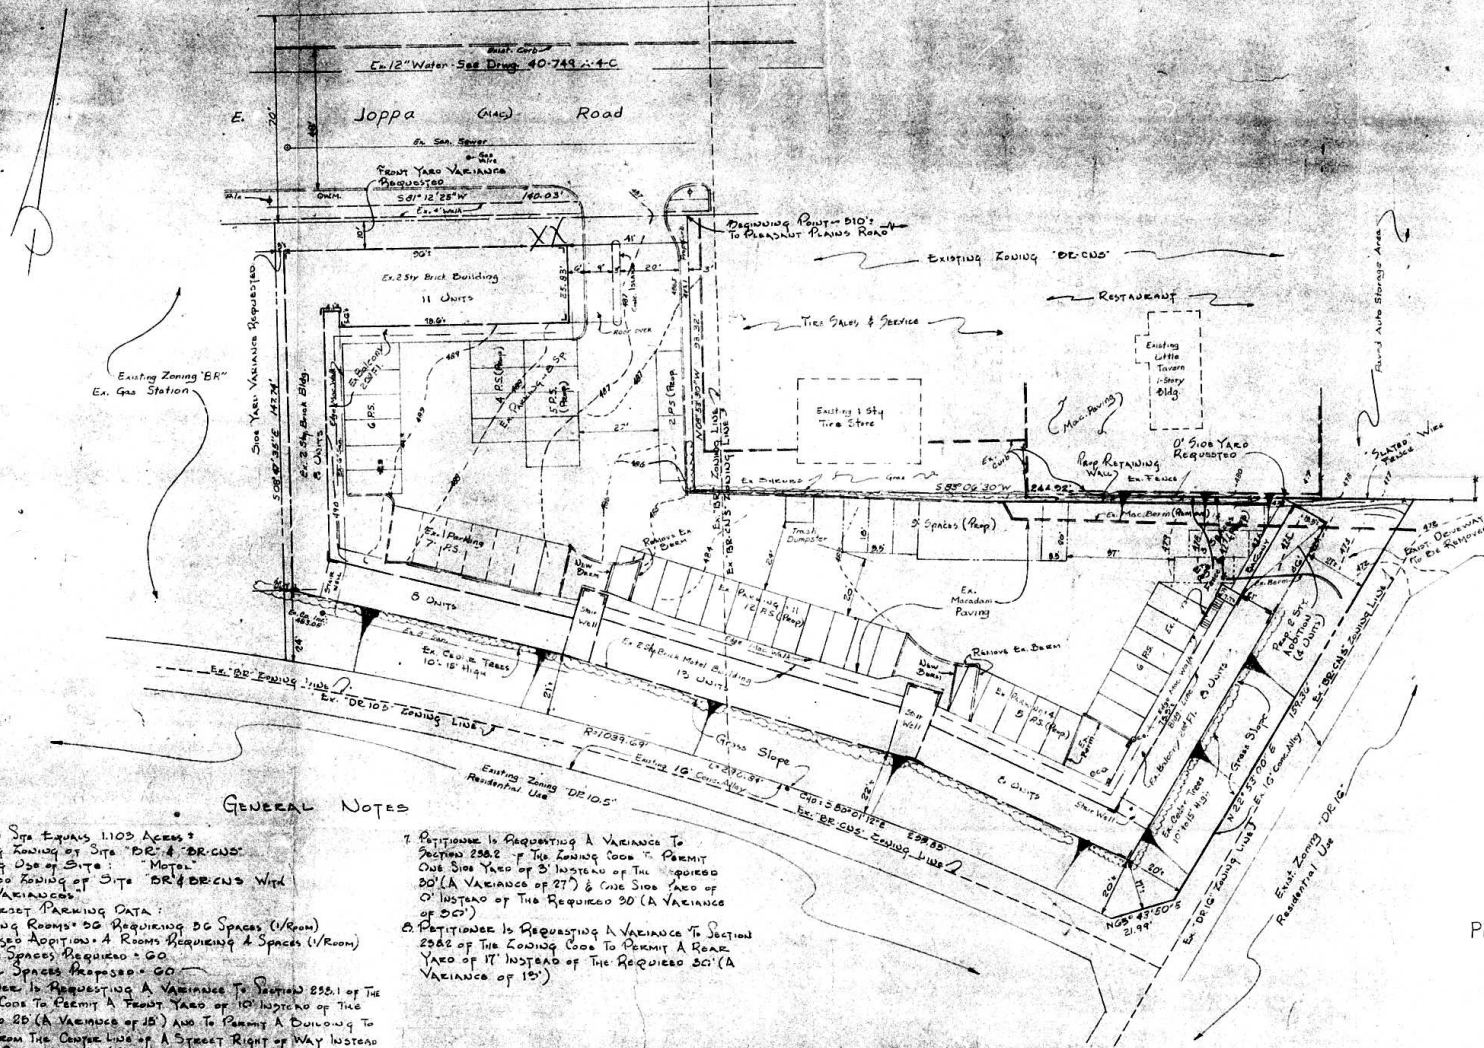


### GENERAL NOTES

1. Area of Site Equals 1.103 Acres.
2. Existing Zoning of Site: "DR-CUS".
3. Existing Use of Site: "Motel".
4. Proposed Zoning of Site: "DR-BR-DENS WITH YARD VARIANCES".
5. OFF-STREET PARKING DATA:
  - A. Existing Rooms: 20. Requiring 20 Spaces (1/Room).
  - B. Proposed Addition: 4 Rooms Requiring 4 Spaces (1/Room).
  - C. Total Spaces Required: 24.
  - D. Total Spaces Proposed: 24.
6. Petitioner is Requesting a Variance To Section 235.1 of The Zoning Code To Permit A Front Yard of 10' Instead of The Required 20' (A Variance of 10') AND To Permit A Building To Be 40' From The Center Line of A Street Right of Way Instead of The Required 50' (A Variance of 10').

7. Petitioner is Requesting a Variance To Section 235.2 of The Zoning Code To Permit One Side Yard of 5' Instead of The Required 20' (A Variance of 15') & One Side Yard of 0' Instead of The Required 20' (A Variance of 20').
8. Petitioner is Requesting a Variance To Section 235.3 of The Zoning Code To Permit A Rear Yard of 11' Instead of The Required 20' (A Variance of 9').


Plat To Accompany Petition  
For  
Yard Variances  
At  
Towson East Motel

Election District 4 Baltimore County, Md.  
Scale: 1" = 20' Date: April 11, 1977

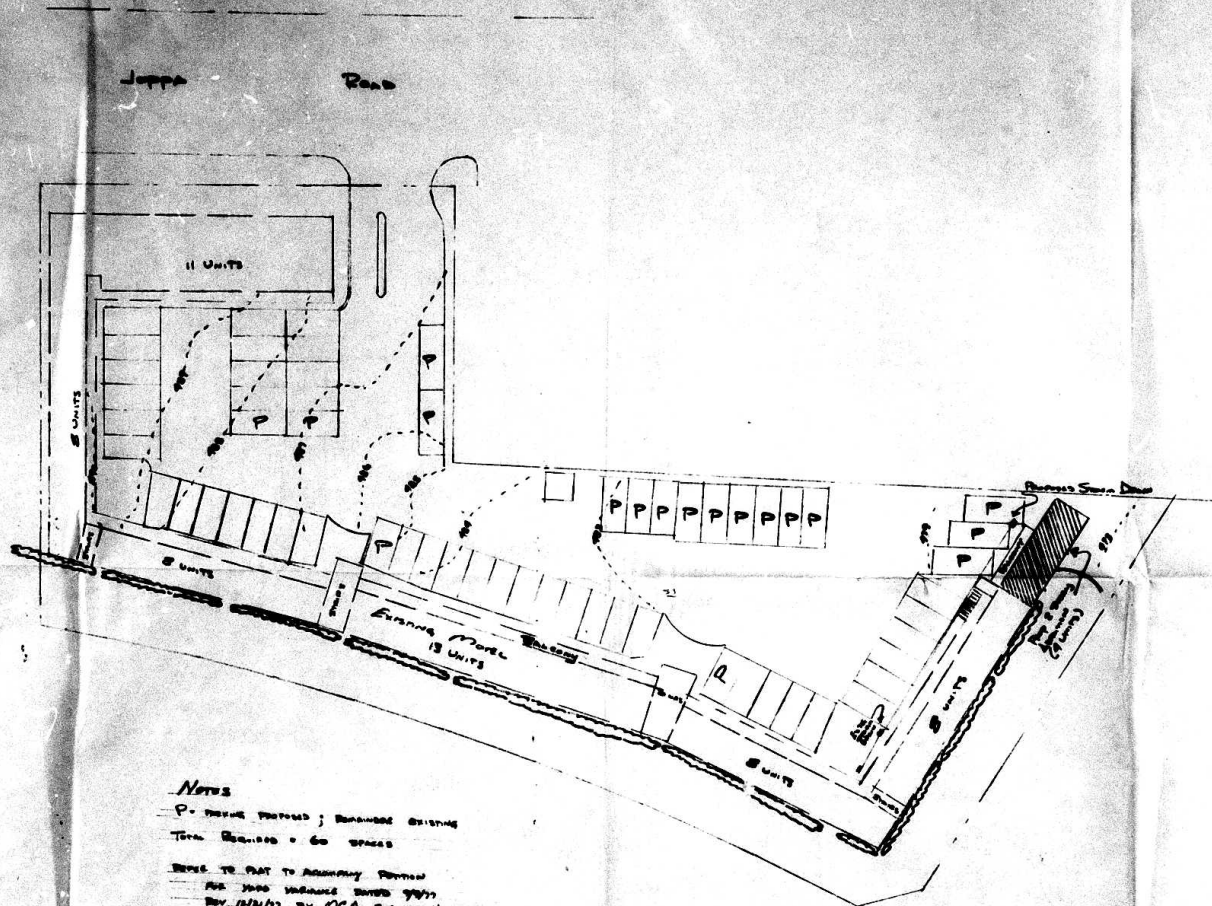

# Notes

- P - Parking Spaces; Dimensions Existing
- Total Occupancy = 60 spaces
- Refer to Plot to accompany Permit
- For more information contact 99777
- Rev 12/1/77 by MCA for 200' Detail

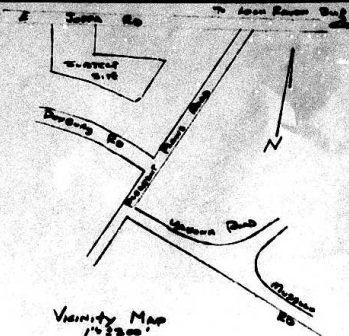


PLANS APPROVED  
OFFICE OF PLANNING & ZONING  
BY: *[Signature]*  
DATE: 7-12-77  
78-157-A

Planning Layout / S. Simon  
Town East Motel

Simon Builders, Inc.

Scale 1"=20'

7/14/78

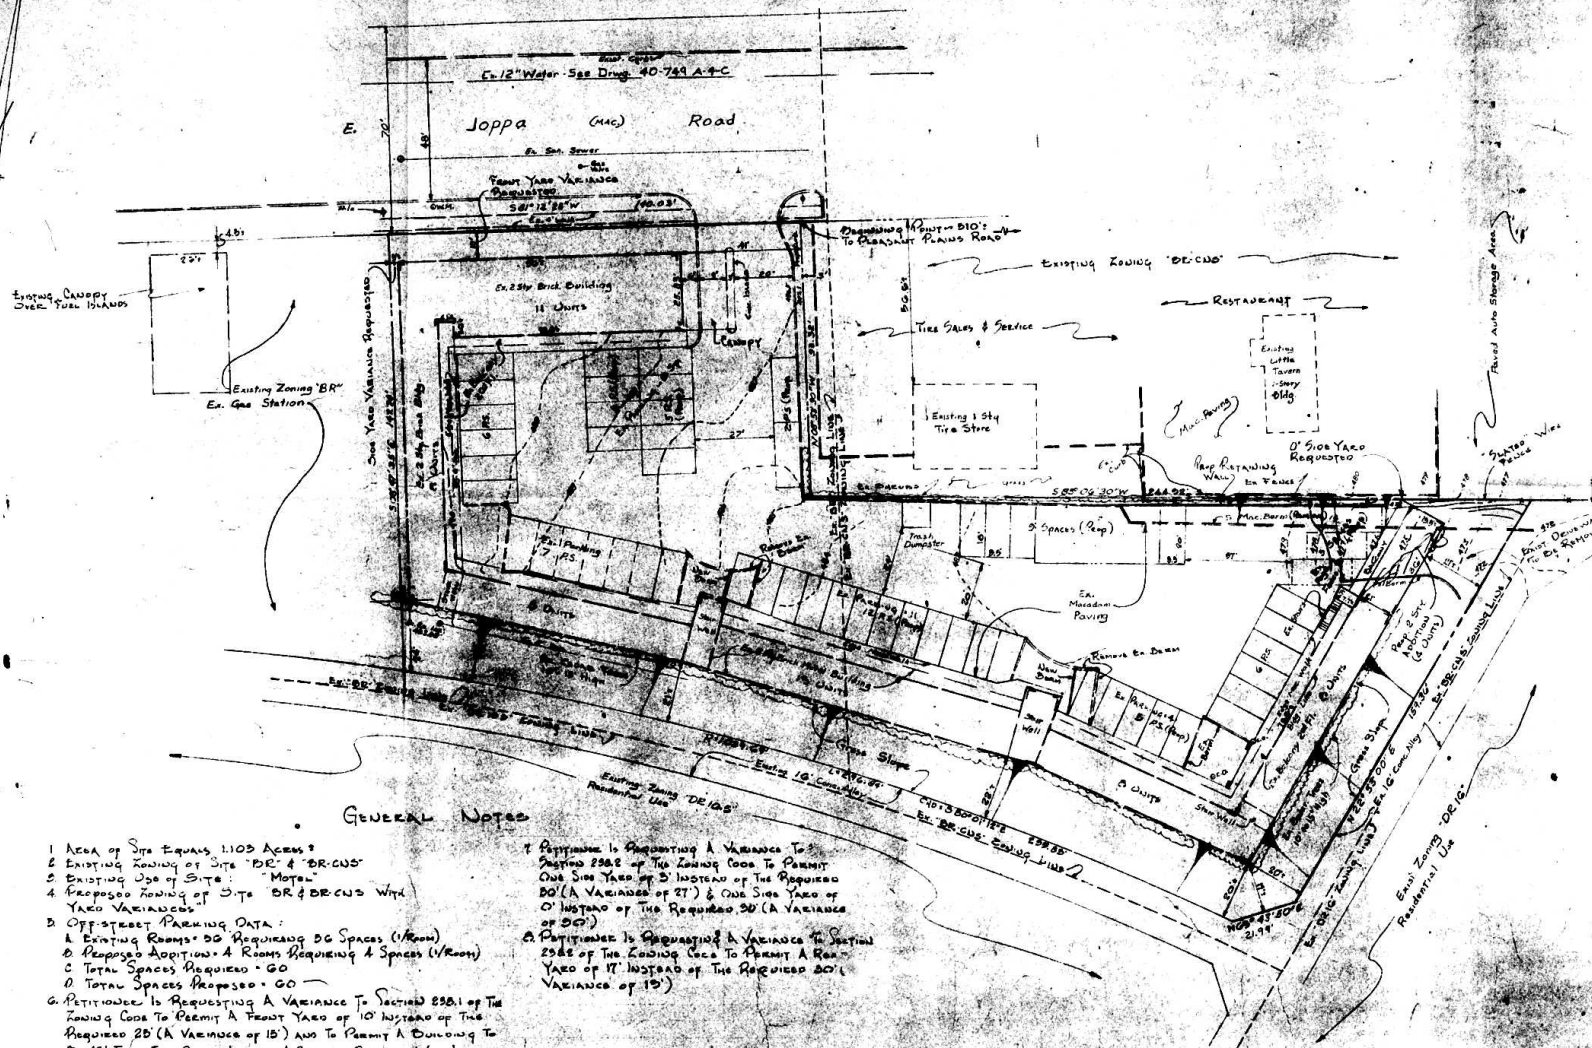

Vicinity Map  
1"=200'

# GENERAL NOTES

1. AREA OF SITE EQUALS 1.103 ACRES.
2. EXISTING ZONING OF SITE "DE-100" & "DE-105".
3. EXISTING USE OF SITE: "MOTEL".
4. PROPOSED ZONING OF SITE "DE-100" & "DE-105" WITH YARD VARIANCES.
5. OFF-STREET PARKING DATA:
  - A. EXISTING ROOMS: 50 REQUIRING 50 SPACES (1/ROOM).
  - B. PROPOSED ADDITIONS: 4 ROOMS REQUIRING 4 SPACES (1/ROOM).
  - C. TOTAL SPACES REQUIRED: 54.
  - D. TOTAL SPACES PROPOSED: 54.
6. PETITIONER IS REQUESTING A VARIANCE TO SECTION 250.1 OF THE ZONING CODE TO PERMIT A FRONT YARD OF 10' INSTEAD OF THE REQUIRED 20' (A VARIANCE OF 10') AND TO PERMIT A BUILDING TO BE 45' FROM THE CENTER LINE OF A STREET RIGHT OF WAY INSTEAD OF THE REQUIRED 50' (A VARIANCE OF 5') AND/OR FROM SECTION 250.2 TO PERMIT 6' VARIANCE NO EXISTING NONCONFORMING FRONT YARD OF TEN (10) FEET IN LIEU OF THE REQUIRED TWENTY AND ONE HALF (20.5) FEET BASED UPON THE SETBACK AVERAGES OF STRUCTURES ON ADJOINING PROPERTIES.

7. PETITIONER IS REQUESTING A VARIANCE TO SECTION 250.2 OF THE ZONING CODE TO PERMIT ONE SIDE YARD OF 5' INSTEAD OF THE REQUIRED 10' (A VARIANCE OF 5') & ONE SIDE YARD OF 0' INSTEAD OF THE REQUIRED 30' (A VARIANCE OF 30').
8. PETITIONER IS REQUESTING A VARIANCE TO SECTION 250.2 OF THE ZONING CODE TO PERMIT A REAR YARD OF 10' INSTEAD OF THE REQUIRED 30' (A VARIANCE OF 20').

PLANS APPROVED  
OFFICE OF PLANNING & ZONING  
BY: [Signature]  
DATE: 10-15-76  
10-155-A


Plat To Accompany Petition  
For  
Yard Variances  
At  
Towson East Motel

Election District 9 Baltimore County Md.  
Scale: 1"=20' Date: Sept. 4, 1977  
Relinqu: Dec. 21, 1977

KIDDE  
KIDDE CONSULTANTS, INC.  
1200 UNIVERSITY PARKWAY, SUITE 100  
BALTIMORE, MARYLAND 21201



sheet  
**A-1**  
of 1

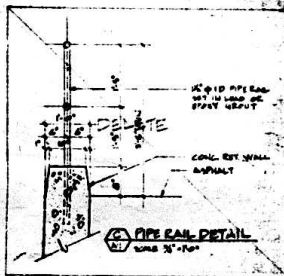


2. PETITIONER IS REQUESTING A VARIANCE TO SECTION 238.2 OF THE ZONING CODE TO PERMIT ONE SIDE YARD OF 3' INSTEAD OF THE REQUIRED 50' (A VARIANCE OF 27') & ONE SIDE YARD OF 0' INSTEAD OF THE REQUIRED 50' (A VARIANCE OF 50')

3. PETITIONER IS REQUESTING A VARIANCE TO SECTION 238.2 OF THE ZONING CODE TO PERMIT A REAR YARD OF 17' INSTEAD OF THE REQUIRED 30' (A VARIANCE OF 13')

Towson East Motel

Electon District 9 Baltimore County Md.  
Scale: 1"=20' Date: Sept. 1, 1977  
Revised: Dec 21, 1977  
Revised: July 14, 1978  
REVISED: AUGUST 2, 1977 - R. G. T. Co.

ENGINEERING & INFORMATION  
SUPPLIED BY:  
**KIDDE**  
KIDDE CONSULTANTS INC.  
1020 CHERRY HILL DRIVE N.W.  
NORTHDALE FLORIDA 33507

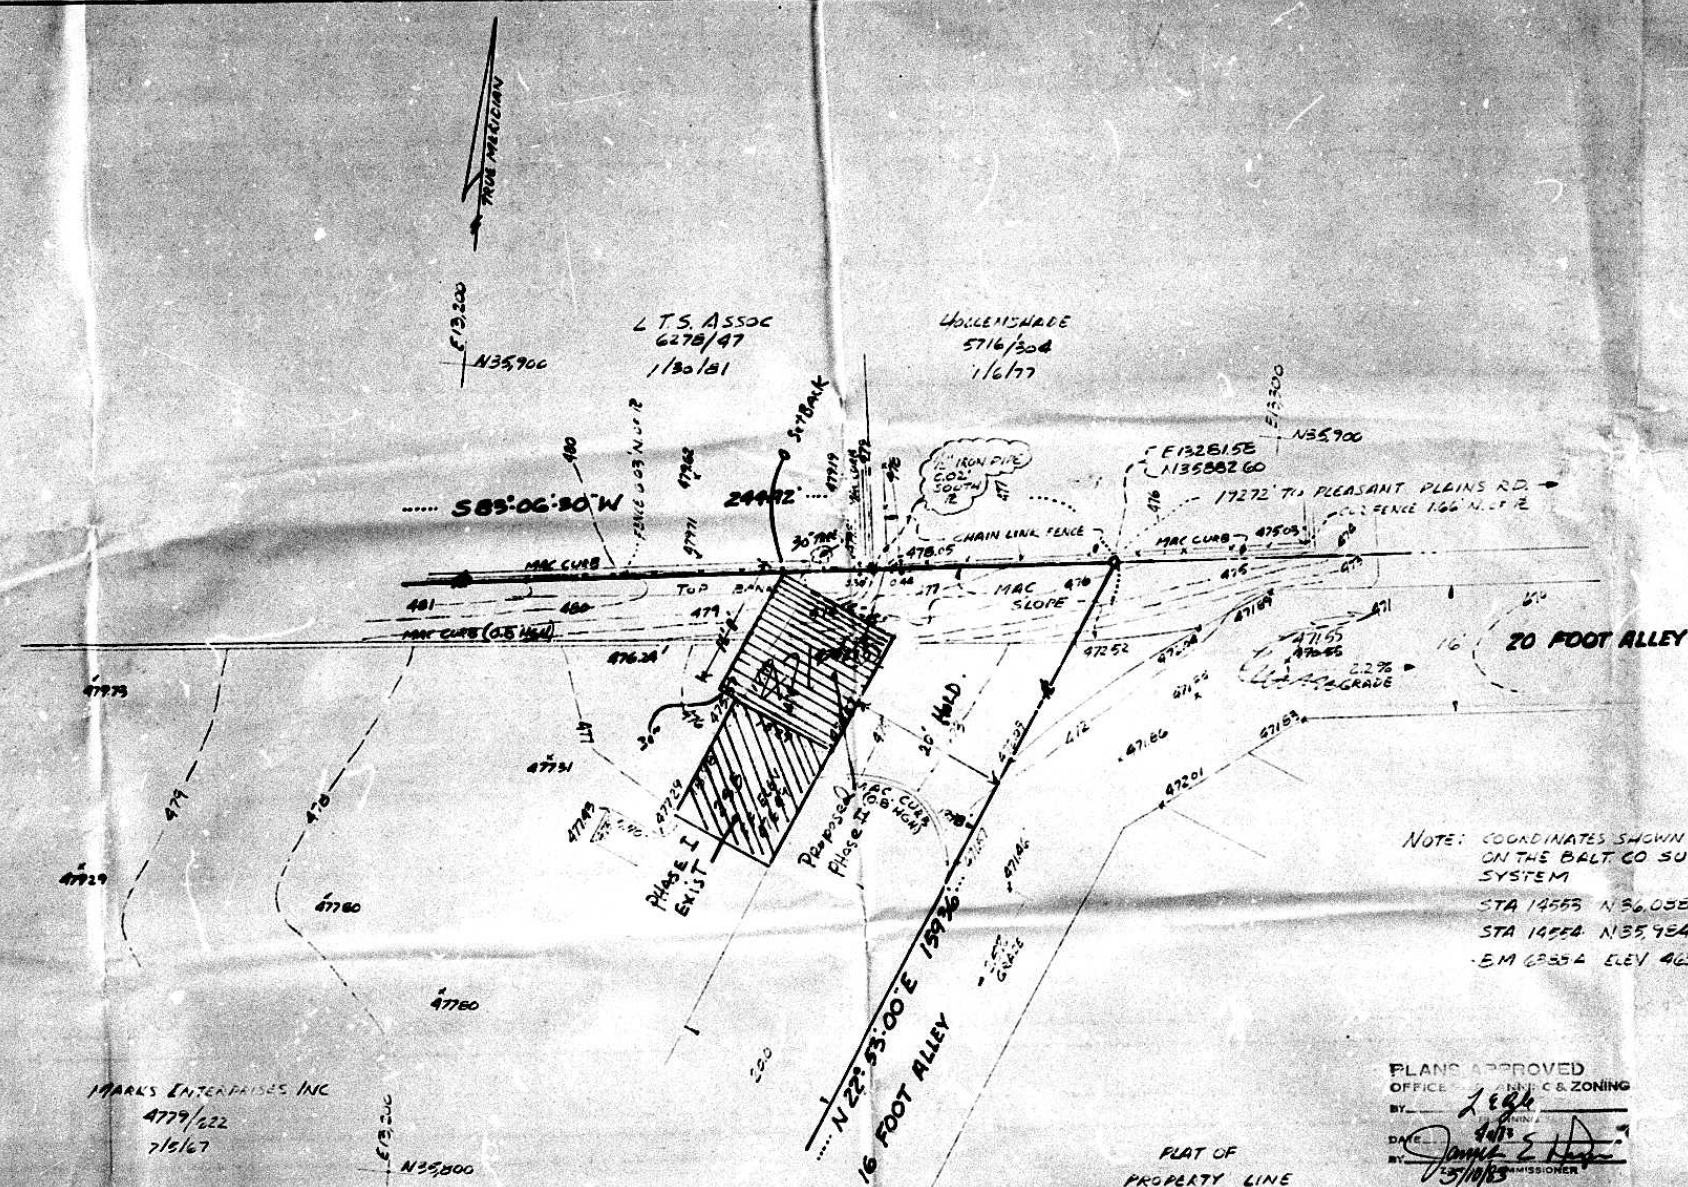

NOTE: COORDINATES SHOWN HEREON ARE BASED  
ON THE BALT. CO SURVEY CONTROL  
SYSTEM  
STA 14553 N36.058 61 E 13.522.88  
STA 14554 N35.954 68 E 12.539.93  
+EM 62354 ELEV 463.54

PLANS APPROVED  
OFFICE OF PLANNING & ZONING  
BY: *[Signature]*  
DATE: *[Signature]*  
DATE: 70-153-A  
C-411-13

PLAT OF  
PROPERTY LINE  
&  
TOPOGRAPHICAL  
SURVEY  
PROPERTY OF  
TOWSON EAST MOTEL  
SCALE 1"=10' MAY 17, 1952

PREPARED BY  
T.M. HOFFMAN & ASSOC. INC.  
LAND SURVEYORS  
5502 STONINGTON AVE.  
BALT MD 21207

*[Signature]*  
THOMAS M. HOFFMAN LS 6138

