

PETITION FOR ZONING VARIANCE

TO THE ZONING COMMISSIONER OF BALTIMORE COUNTY:

The undersigned, legal owner(s) of the property situate in Baltimore County and which is described in the description and plat attached hereto and made a part hereof, hereby petition for a Variance from Section 1A04.3.B.3 to permit side setbacks of 40' in lieu of the required 50'.

of the Zoning Regulations of Baltimore County, to the Zoning Law of Baltimore County; for the following reasons: (indicate hardship or practical difficulty)
My practical difficulty is that my lot is only 130' wide and with a RC-5 zoning a required 50' setback only gives me 30' width for my home. The lot is in a older neighborhood and the homes there are not within these zoning requirements.

Property is to be posted and advertised as prescribed by Zoning Regulations.

I, or we, agree to pay expenses of above Variance advertising, posting, etc., upon filing of this petition, and further agree to and are to be bound by the zoning regulations and restrictions of Baltimore County adopted pursuant to the Zoning Law For Baltimore County.

I/We do solemnly declare and affirm that we are the legal owner(s) of the property which is the subject of this Petition.

Contract Purchaser: _____
(Type or Print Name)
Signature _____
Address _____
City and State _____
Name, address and phone number of legal owner, contract purchaser or representative to be contacted _____
City and State _____
Attorney's Telephone No.: _____

Legal Owner(s): _____
(Type or Print Name)
Signature _____
Address _____
City and State _____
Name, address and phone number of legal owner, contract purchaser or representative to be contacted _____
City and State _____
Attorney's Telephone No.: _____

ORDERED By The Zoning Commissioner of Baltimore County, this 10th day of February, 1981, that the subject matter of this petition be advertised, as required by the Zoning Law of Baltimore County, in two newspapers of general circulation throughout Baltimore County, that property be posted, and that the public hearing be held before the Zoning Commissioner of Baltimore County in Room 105, County Office Building in Towson, Baltimore County, on the 30th day of April, 1981, at 9:30 o'clock A.M.

(over)

BALTIMORE COUNTY ZONING PLANS ADVISORY COMMITTEE

April 17, 1981

COUNTY OFFICE BLDG.
171 W. Chesapeake Ave.
Towson, Maryland 21204

Chairman
Nicholas B. Commodari

MEMBERS
Bureau of Engineering
Department of Traffic Engineering
State Roads Commission
Bureau of Fire Prevention
Health Department
Project Planning
Building Department
Board of Education
Zoning Administration
Industrial Development

Mr. Wallace S. Erdman
311 Limestone Valley Drive
Apt. G
Baltimore, Maryland 21206

RE: Item No. 144
Petitioner - Wallace S. Erdman
Variance Petition

Dear Mr. Erdman:

The Zoning Plans Advisory Committee has reviewed the plans submitted with the above referenced petition. The following comments are not intended to indicate the appropriateness of the zoning action requested, but to assure that all parties are made aware of plans or problems with regard to the development plans that may have a bearing on this case. The Director of Planning may file a written report with the Zoning Commissioner with recommendations as to the suitability of the requested zoning.

Enclosed are all comments submitted to this office from the committee members at this time. The remaining members felt that no comment was warranted. This petition was accepted for filing on the date of the enclosed certificate and a hearing scheduled accordingly.

Very truly yours,

NICHOLAS B. COMMODARI
Chairman
Zoning Plans Advisory Committee

NBC:bac

Enclosures



BALTIMORE COUNTY
DEPARTMENT OF PUBLIC WORKS
TOWSON, MARYLAND 21204

HARRY J. PISTEL, P.E.
DIRECTOR

March 11, 1981

Mr. William E. Hammond
Zoning Commissioner
County Office Building
Towson, Maryland 21204

Re: Item #144 (1980-1981)
Property Owner: Wallace S. Erdman
W/S Cameron Mill Road 1740' S. of Bentley Road
Acres: 117 0/130 5 X 326/356 6 District: 7th

Dear Mr. Hammond:

The following comments are furnished in regard to the plat submitted to this office for review by the Zoning Advisory Committee in connection with the subject item.

Highways:

Cameron Mill Road, an existing public road is proposed to be improved in the future on a 60-foot right-of-way. Further information may be obtained from the Baltimore County Bureau of Engineering, Highway Design and Approval Section.

Sediment Control:

Development of this property through stripping, grading and stabilization could result in a sedimentation problem, damaging private and public holdings downstream of the property. A grading permit is, therefore, necessary for all grading, including the stripping of top soil.

Storm Drains:

The Petitioner must provide necessary drainage facilities (temporary or permanent) to prevent creating any nuisances or damages to adjacent properties, especially by the concentration of surface waters. Correction of any problem which may result, due to improper grading or improper installation of drainage facilities, would be the full responsibility of the Petitioner.

Water and Sanitary Sewer:


Public water supply and sanitary sewerage are not available to serve this property, which is beyond the Baltimore County Metropolitan District and the Urban-Rural Demarcation Line. Baltimore County Water and Sewerage Plans W and S-4B, as amended, indicate "No Planned Service" in the area.

Very truly yours,

ROBERT A. MORTON, P.E., Chief
Bureau of Public Services

RAM:EAM:FWR:ss

KK-NE Key Sheet - 138 MW 9 Pos. Sheet
NW 35 C Topo - 12 Tax Map

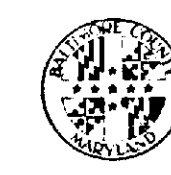

BALTIMORE COUNTY
OFFICE OF PLANNING AND ZONING
TOWSON, MARYLAND 21204
494-3211

NORMAN E. GERDER
DIRECTOR

March 11, 1981

Mr. William Hammond, Zoning Commissioner
Zoning Advisory Committee
Office of Planning and Zoning
Baltimore County Office Building
Towson, Maryland 21204

Dear Mr. Hammond:

Comments on Item #144, Zoning Advisory Committee Meeting, February 10, 1981, are as follows:

Property Owner: Wallace S. Erdman
Location: W/S Cameron Mill Road 1740' S. of Bentley Road
Acres: 117 0/130 5 X 326/356 6
District: 7th

This office has reviewed the subject petition and offers the following comments. These comments are not intended to indicate the appropriateness of the zoning in question, but are to assure that all parties are made aware of plans or problems with regard to development plans that may have a bearing on this petition.

This petition meets the requirements of the Division of Current Planning and Development.

Very truly yours,

John L. Wimbley
John L. Wimbley
Planner III
Current Planning and Development



BALTIMORE COUNTY
DEPARTMENT OF TRAFFIC ENGINEERING
TOWSON, MARYLAND 21204
(410) 494-3523

STEPHEN E. COLLINS
DIRECTOR

March 16, 1981

Mr. William Hammond
Zoning Commissioner
County Office Building
Towson, Maryland 21204

Dear Mr. Hammond:

With regard to ZAC meeting of February 10, 1981, this department has no comment on items #137 thru 141 as well as item #143 and #144.

Very truly yours,

Michael S. Flanigan
Engineer Associate II

MSF/bza



BALTIMORE COUNTY
DEPARTMENT OF HEALTH
TOWSON, MARYLAND 21204

DONALD J. ROOP, M.D., M.P.H.
DEPUTY STATE & COUNTY HEALTH OFFICER

March 19, 1981

Mr. William E. Hammond
Zoning Commissioner
Office of Planning and Zoning
County Office Building
Towson, Maryland 21204

Dear Mr. Hammond:

Comments on Item 144, Zoning Advisory Committee Meeting of February 10, 1981, are as follows:


Property Owner: Wallace S. Erdman
Location: W/S Cameron Mill Road 1740' S. of Bentley Road
Existing Zoning: R.C. 5
Proposed Zoning: Variance to permit a side setback of 40' in lieu of the required 50'.
Acres: 117 0/130 5 X 326/356 6
District: 7th

The dwelling will be served by an existing water well and proposed sewage disposal system. Soil percolation tests have been conducted, the results of which will be valid until October 7, 1983. The proposed dwelling location will not interfere with the location of the well or septic system, therefore no health hazards are anticipated.

Very truly yours,

IAN J. FORMATT, Director
BUREAU OF ENVIRONMENTAL SERVICES

IJF/kc

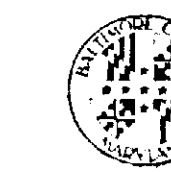

BALTIMORE COUNTY
FIRE DEPARTMENT
TOWSON, MARYLAND 21204
825-7310

PAUL H. REINCKE
CHIEF

March 6, 1981

Mr. William Hammond
Zoning Commissioner
Office of Planning and Zoning
Baltimore County Office Building
Towson, Maryland 21204

Attention: Vick Commodari, Chairman
Zoning Plans Advisory Committee

RE: Property Owner: Wallace S. Erdman

Location: W/S Cameron Mill Road 1740' South of Bentley Road

Item No.: 144 Zoning Agenda: Meeting of Feb. 10, 1981

Gentlemen:

Pursuant to your request, the referenced property has been surveyed by this Bureau and the comments below marked with an "X" are applicable and required to be corrected or incorporated into the final plans for the property.

1. Fire hydrants for the referenced property are required and shall be located at intervals or _____ in accordance with Baltimore County Standards as published by the Department of Public Works.
2. A second means of vehicle access is required for the site.
3. The vehicle dead end condition shown at _____ EXCEEDS the maximum allowed by the Fire Department.

4. The site shall be made to comply with all applicable parts of the Fire Prevention Code prior to occupancy or beginning of operation.

5. The buildings and structures existing or proposed on the site shall comply with all applicable requirements of the National Fire Protection Association Standard No. 101 "Life Safety Code", 1976 Edition prior to occupancy.

6. Site plans are approved, as drawn.

7. The Fire Prevention Bureau has no comments, at this time.

REVIEWED: [Signature] Noted and Approved: [Signature]
Planning Div. Fire Prevention Bureau
Special Inspection Division

/mb

Mr. Wallace S. Erdman
311 Limestone Valley Drive
Apt. G
Baltimore, Maryland 21206

BALTIMORE COUNTY OFFICE OF PLANNING & ZONING

County Office Building
111 W. Chesapeake Avenue
Towson, Maryland 21204

Your Petition has been received and accepted for filing this 10th day of February, 1981.

WILLIAM E. HAMMOND
Zoning Commissioner

Petitioner: Wallace S. Erdman

Petitioner's Attorney

Reviewed by: [Signature]
Nicholas B. Commodari
Chairman, Zoning Plans
Advisory Committee

ORDER RECEIVED FOR FILING

Pursuant to the advertisement, posting of property, and public hearing on the Petition and it appearing that strict compliance with the Baltimore County Zoning Regulations would result in practical difficulty and unreasonable hardship upon the Petitioner(s) and the granting of the variance(s) requested will not adversely affect the health, safety, and general welfare of the community, the variance(s) should be granted.

Therefore, IT IS ORDERED by the Zoning Commissioner of Baltimore County, this 5th day of May, 1981, that the herein Petition for Variance(s) to permit side yard setbacks of 40 feet in lieu of the required 50 feet, in accordance with the site plan filed herein, dated December 16, 1980, should be and the same is GRANTED, from and after the date of this Order, subject, however, to the approval of a site plan by the Department of Public Works and the Office of Planning and Zoning.

Jean M. H. Jung
Deputy Zoning Commissioner of Baltimore County

BALTIMORE COUNTY, MARYLAND
INTER-OFFICE CORRESPONDENCE

TO: Nick Commodari Date: February 20, 1981
FROM: Charles E. (Ted) Burnham
Zoning Advisory Committee
SUBJECT: Meeting February 19, 1981

- ITEM NO. 137 See Comments
- ITEM NO. 138 This item has been discussed 2-12-81 with Mr. Walker and a letter shall be forth coming resolving the problem.
- ITEM NO. 139 See Comments
- ITEM NO. 140 Standard Comments
- ITEM NO. 141 See Comments
- ITEM NO. 142 See Comments
- ITEM NO. 143 See Comments
- ITEM NO. 144 Standard Comments

Charles E. Burnham
Charles E. (Ted) Burnham
Plans Review Supervisor

CEB:rrj

BALTIMORE COUNTY PUBLIC SCHOOLS

Robert V. Dubel, Superintendent Towson, Maryland - 21204
Date: February 9, 1981

Mr. William E. Hammond
Zoning Commissioner
Baltimore County Office Building
111 West Chesapeake Avenue
Towson, Maryland 21204

Z.A.C. Meeting of: February 10, 1981

Re: Item No: 137, 138, 139, 140, 141, 142, 143, 144
Property Owner:
Location:
Present Zoning:
Proposed Zoning:

District:
No. Acres:

Dear Mr. Hammond:

All of the above have no bearing on student population.

Very truly yours,
Wm. Nick Petrovich
Wm. Nick Petrovich, Assistant
Department of Planning

WNP/bp

PETITION FOR VARIANCE
7th District

ZONING: Petition for Variance for side yard setbacks
LOCATION: West side of Cameron Mill Road, 1740 feet South of Bentley Road
DATE & TIME: Thursday, April 30, 1981 at 9:30 A.M.
PUBLIC HEARING: Room 106, County Office Building, 111 W. Chesapeake Avenue, Towson, Maryland

The Zoning Commissioner of Baltimore County, by authority of the Zoning Act and Regulations of Baltimore County, will hold a public hearing:

Petition for Variance to permit side yard setbacks of 40 feet in lieu of the required 50 feet

The Zoning Regulation to be excepted as follows:

Section 1A04.3.B.3 - side yard setbacks

All that parcel of land in the Seventh District of Baltimore County

Being the property of Wallace S. Erdman, as shown on plat plan filed with the Zoning Department
Hearing Date: Thursday, April 30, 1981 at 9:30 A.M.
Public Hearing: Room 106, County Office Building, 111 W. Chesapeake Avenue, Towson, Maryland

BY ORDER OF
WILLIAM E. HAMMOND
ZONING COMMISSIONER
OF BALTIMORE COUNTY

BALTIMORE COUNTY
OFFICE OF PLANNING & ZONING
TOWSON, MARYLAND 21204
494-3353
WILLIAM E. HAMMOND
ZONING COMMISSIONER

April 14, 1981

Mr. Wallace S. Erdman
311 Limestone Valley Drive, Apt. G
Baltimore, Maryland 21206

RE: Petition for Variance
W/S of Cameron Mill Road 1740' S.
of Bentley Road
Case No. 81-187 A

This is to advise you that \$44.50 is due for advertising and posting of the above-property.

Please make check payable to Baltimore County, Maryland and remit to Sondra Jones, Room 113, County Office Building, Towson, Maryland 21204, before the hearing.

Very truly yours,
William E. Hammond
WILLIAM E. HAMMOND
Zoning Commissioner

WEH:sj

BALTIMORE COUNTY, MARYLAND
INTER-OFFICE CORRESPONDENCE

TO: Mr. W. E. Hammond Date: April 9, 1981
FROM: Norman E. Gerber, Director
Office of Planning and Zoning
SUBJECT: Petition No. 81-187-A Item 144

Petition for Variance for side yard setbacks
West side of Cameron Mill Road, 1740 feet South of Bentley Road
Petitioner- Wallace S. Erdman

Seventh District

HEARING: Thunday, April 30, 1981 (9:30 A.M.)

There are no comprehensive planning factors requiring comment on this petition.

Norman E. Gerber
Norman E. Gerber, Director
Office of Planning and Zoning

NEG:JGH:ab

RE: PETITION FOR VARIANCE : BEFORE THE ZONING COMMISSIONER
W/S of Cameron Mill Rd., 1740' : OF BALTIMORE COUNTY
S of Bentley Rd., 7th District
WALLACE S. ERDMAN, Petitioner : Case No. 81-187-A

ORDER TO ENTER APPEARANCE

Mr. Commissioner:

Pursuant to the authority contained in Section 524.1 of the Baltimore County Charter, I hereby enter my appearance in this proceeding. You are requested to notify me of any hearing date or dates which may be now or hereafter designated therefore, and of the passage of any preliminary or final Order in connection therewith.

Peter Max Zimmerman
Peter Max Zimmerman
Deputy People's Counsel

John W. Hessian, III
John W. Hessian, III
People's Counsel for Baltimore County
Rm. 223, Court House
Towson, Maryland 21204
494-2188

I HEREBY CERTIFY that on this 25th day of March, 1981, a copy of the foregoing Order was mailed to Mr. Wallace Erdman, Petitioner, 311 Limestone Valley Drive, Apt. G, Baltimore, Maryland 21206.

John W. Hessian, III
John W. Hessian, III

BALTIMORE COUNTY
OFFICE OF PLANNING & ZONING
TOWSON, MARYLAND 21204
494-3353
WILLIAM E. HAMMOND
ZONING COMMISSIONER
May 5, 1981

Mr. Wallace S. Erdman
311 Limestone Valley Drive
Apartment G
Baltimore, Maryland 21206

RE: Petition for Variances
W/S of Cameron Mill Rd., 1740' S of Bentley Rd. - 7th Election District
Wallace S. Erdman - Petitioner
NO. 81-187-A (Item No. 144)

Dear Mr. Erdman:

I have this date passed my Order in the above captioned matter in accordance with the attached.

Very truly yours,
Jean M. H. Jung
JEAN M. H. JUNG
Deputy Zoning Commissioner

JMHJ/mc

Attachments

cc: John W. Hessian, III, Esquire
People's Counsel

PETITION FOR VARIANCE FOR WALLACE S. ERDMAN

Surveyor's Description - Cameron Mill Road

Beginning at a point on the west side of Cameron Mill Road, 1,740' south of Bentley Road, thence running north 76 degrees, west 326'; thence south 20 degrees, west 130.5'; thence south 77 1/2 degrees, east 344'; thence north 43 1/2 degrees east 25'; thence north 6 degrees, east 104.5'; to the beginning point.

Mr. Wallace S. Erdman
311 Limestone Valley Drive
Apt. G
Baltimore, Maryland 21206

BALTIMORE COUNTY OFFICE OF PLANNING & ZONING

County Office Building
111 W. Chesapeake Avenue
Towson, Maryland 21204

Your Petition has been received and accepted for filing this 10th day of February 1981.


WILLIAM E. HAMMOND
Zoning Commissioner

Petitioner: Wallace S. Erdman

Petitioner's Attorney

Reviewed by: Nicholas S. Commodari
Chairman, Zoning Plans
Advisory Committee

OFFICE COPY

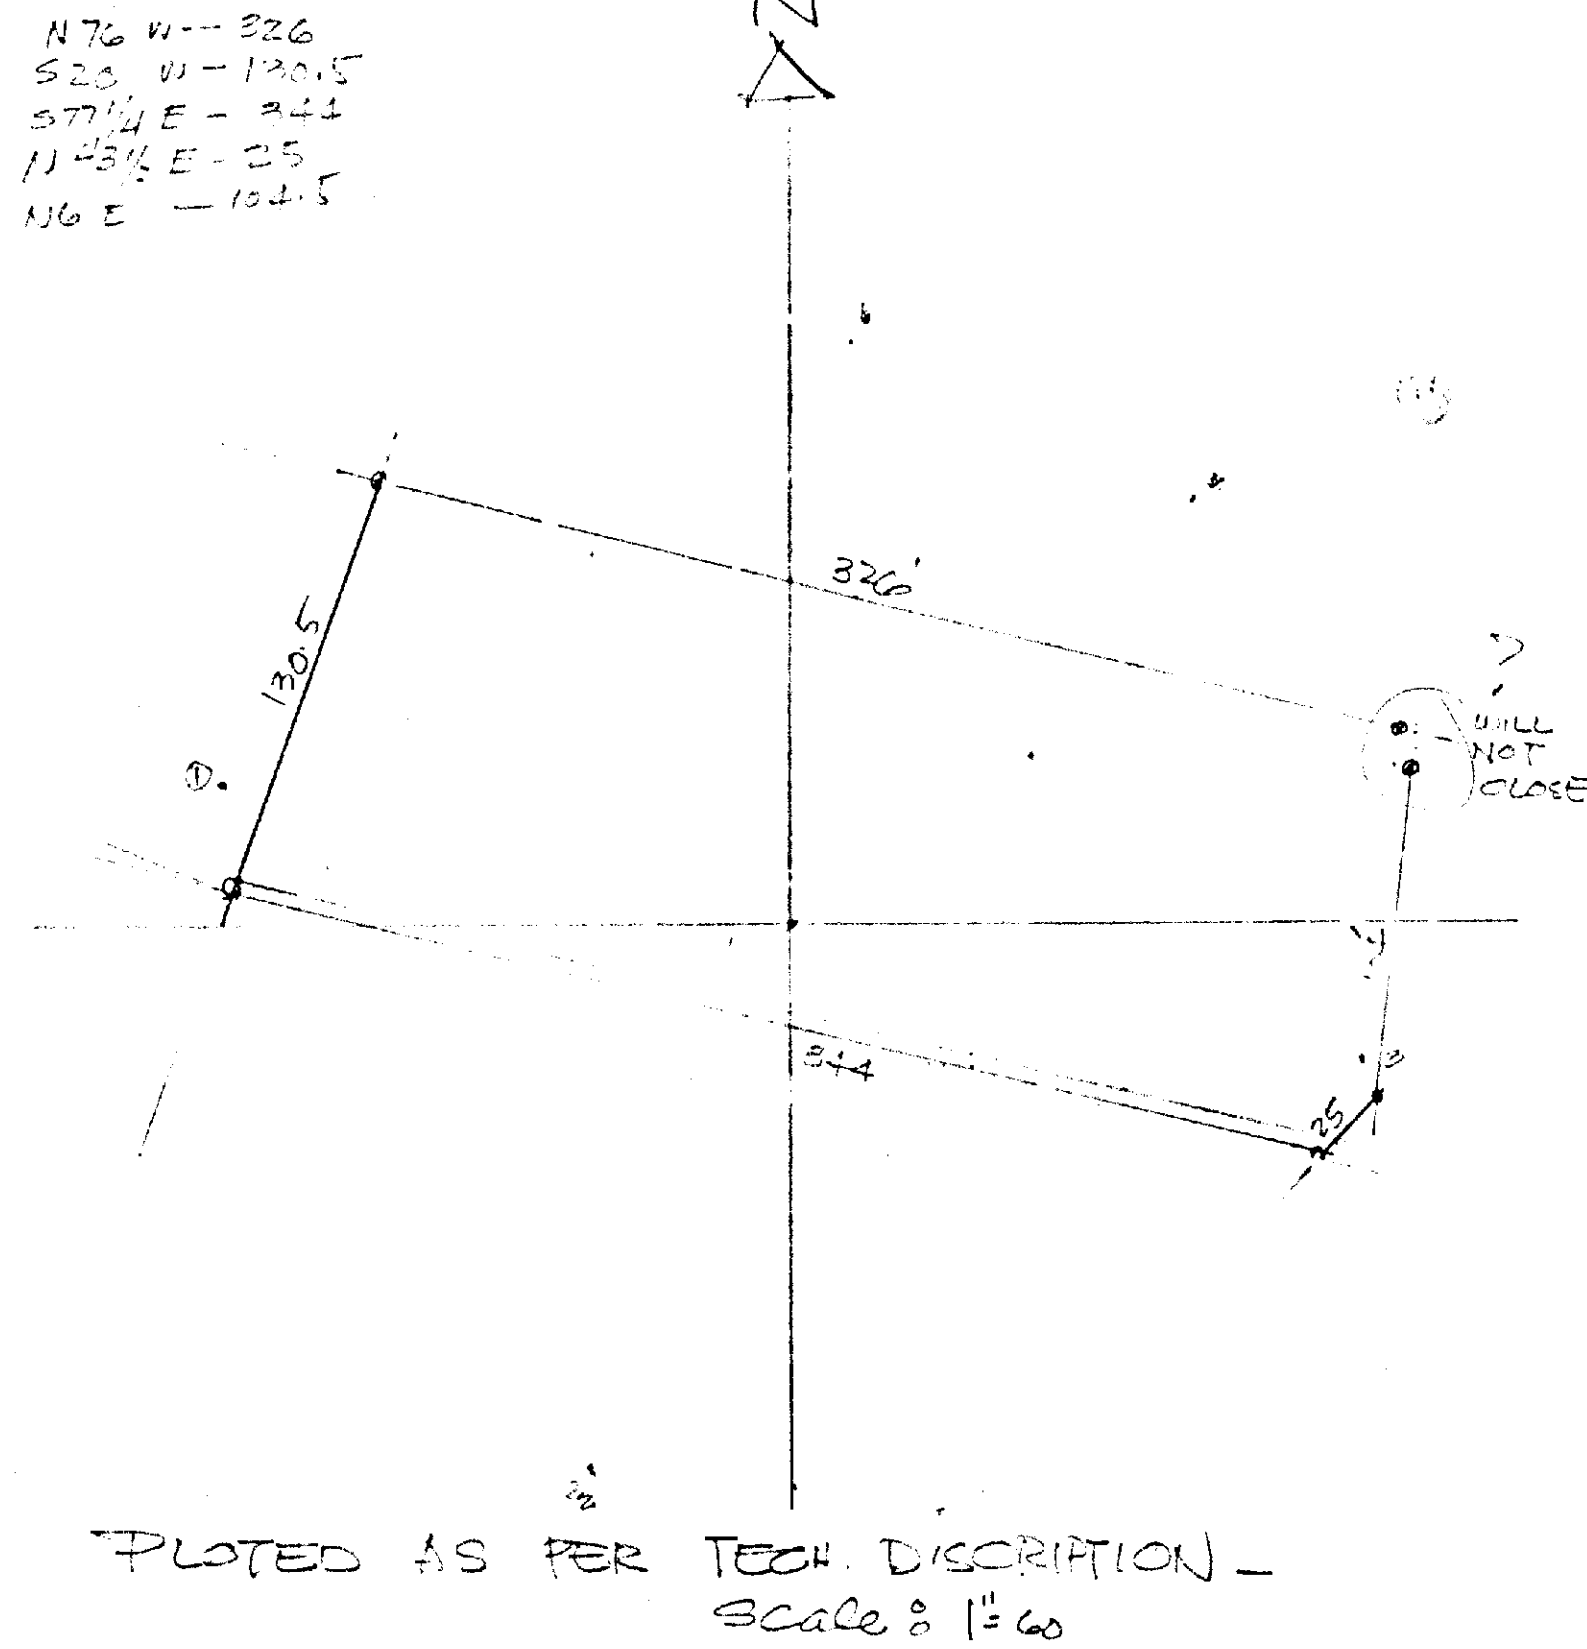

BALTIMORE COUNTY, MARYLAND

INTER-OFFICE CORRESPONDENCE

Mr. W. E. Hammond
Zoning Commissioner
TO: Norman E. Gerber, Director
FROM: Office of Planning and Zoning
SUBJECT: Petition No. 81-137-A Item 144
Date: April 9, 1981

Petition for Variance for side yard setbacks
West side of Cameron Mill Road, 1740 feet South of Bentley Road
Petitioner- Wallace S. Erdman

Seventh District

HEARING: Thursday, April 30, 1981 (9:30 A.M.)

There are no comprehensive planning factors requiring comment on this petition.

NEG:JCH:ab

CERTIFICATE OF POSTING ZONING DEPARTMENT OF BALTIMORE COUNTY Towson, Maryland

District: 7th Date of Posting: April 12, 1981
Posted for: Variance
Petitioner: Wallace S. Erdman
Location of property: W/S Cameron Mill Road 1740 S of Bentley Rd.
Location of Signs: W/S of Cameron Mill Rd. Approx. 1800' S of Bentley Road.
Remarks:
Posted by: Stephen J. O'Neil
Number of Signs: 1
Date of return: April 24, 1981

CERTIFICATE OF PUBLICATION

TOWSON, MD., April 2, 1981
THIS IS TO CERTIFY, that the annexed advertisement was published in THE JEFFERSONIAN, a weekly newspaper printed and published in Towson, Baltimore County, Md., on one time before the 30th day of April, 1981, the first publication appearing on the 2nd day of April, 1981.

L. Frank Sullivan
Manager

Cost of Advertisement, \$

PETITION FOR VARIANCE
7th District
ZONING: Petition for Variance for side yard setbacks
LOCATION: West side of Cameron Mill Road, 1740 feet South of Bentley Road
DATE & TIME: Thursday, April 30, 1981 at 9:30 A.M.
PUBLIC HEARING: Room 106, County Office Building, 111 W. Chesapeake Avenue, Towson, Maryland
The Zoning Commissioner of Baltimore County, by authority of the Zoning Act and Regulations of Baltimore County, will hold a public hearing on the petition for variance for side yard setbacks of 40 feet in lieu of the required 50 feet.
The Zoning Regulation to be excepted as follows:
Section 1A04.3.B.3 - side yard setbacks
All that parcel of land in the Seventh District of Baltimore County and beginning at a point on the west side of Cameron Mill Road, 1740 feet South of Bentley Road, thence running north 76 degrees, west 326'; thence south 20 degrees, west 130.5'; thence south 77 1/2 degrees, east 344'; thence north 43 1/2 degrees east 25'; thence north 6 degrees, east 104.5'; to the beginning point.
Being the property of Wallace S. Erdman, as shown on plat plan filed with the Zoning Department on April 9, 1981 at 9:30 A.M.
Public Hearing: Thursday, April 30, 1981 at 9:30 A.M.
Office Building, 111 W. Chesapeake Avenue, Towson, Maryland
BY ORDER OF
WILLIAM E. HAMMOND,
Zoning Commissioner
of Baltimore County
Apr. 2, 1981

PETITION FOR VARIANCE

7th District

ZONING: Petition for Variance for side yard setbacks

LOCATION: West side of Cameron Mill Road, 1740 feet South of Bentley Road

DATE & TIME: Thursday, April 30, 1981 at 9:30 A.M.

PUBLIC HEARING: Room 106, County Office Building, 111 W. Chesapeake Avenue, Towson, Maryland

The Zoning Commissioner of Baltimore County, by authority of the Zoning Act and Regulations of Baltimore County, will hold a public hearing:

Petition for Variance to permit side yard setbacks of 40 feet in lieu of the required 50 feet

The Zoning Regulation to be excepted as follows:

Section 1A04.3.B.3 - side yard setbacks

All that parcel of land in the Seventh District of Baltimore County

Being the property of Wallace S. Erdman, as shown on plat plan filed with the Zoning Department

Hearing Date: Thursday, April 30, 1981 at 9:30 A.M.

Public Hearing: Room 106, County Office Building, 111 W. Chesapeake Avenue, Towson, Maryland

BY ORDER OF
WILLIAM E. HAMMOND
ZONING COMMISSIONER
OF BALTIMORE COUNTY

March 16, 1981

Mr. Wallace S. Erdman
311 Limestone Valley Drive, Apt. G
Baltimore, Maryland 21206

NOTICE OF HEARING

RE: Petition for Variance - W/S Cameron Mill Road, 1740' S of Bentley Road - Case No. 81-137-A

TIME: 9:30 A.M.

DATE: Thursday, April 30, 1981

PLACE: ROOM 106 COUNTY OFFICE BUILDING, 111 W. CHESAPEAKE AVENUE,

TOWSON, MARYLAND

WILLIAM E. HAMMOND
ZONING COMMISSIONER OF
BALTIMORE COUNTY

PETITION MAPPING PROGRESS SHEET

FUNCTION	Wall Map		Original		Duplicate		Tracing		200 Sheet	
	date	by	date	by	date	by	date	by	date	by
Descriptions checked and outline plotted on map										
Petition number added to outline										
Denied										
Granted by ZC, RA, CC, CA										
Reviewed by: WCR										
Previous case:										

Revised Plans:
Change in outline or description Yes
Map # 3F (NW 35C) No

OFFICE COPY

Item # 144

Petition
For Variance
7th District
Zoning: Petition for Variance for side yard setbacks
Location: West side of Cameron Mill Road, 1740 feet South of Bentley Road
Date & Time: Thursday, April 30, 1981 at 9:30 A.M.
Public Hearing: Room 106, County Office Building, 111 W. Chesapeake Avenue, Towson, Maryland
The Zoning Commissioner of Baltimore County, by authority of the Zoning Act and Regulations of Baltimore County, will hold a public hearing on the petition for variance for side yard setbacks of 40 feet in lieu of the required 50 feet.
The Zoning Regulation to be excepted as follows:
Section 1A04.3.B.3 - side yard setbacks
All that parcel of land in the Seventh District of Baltimore County and beginning at a point on the west side of Cameron Mill Road, 1740 feet South of Bentley Road, thence running north 76 degrees, west 326'; thence south 20 degrees, west 130.5'; thence south 77 1/2 degrees, east 344'; thence north 43 1/2 degrees east 25'; thence north 6 degrees, east 104.5'; to the beginning point.
Being the property of Wallace S. Erdman, as shown on plat plan filed with the Zoning Department on April 9, 1981 at 9:30 A.M.
Public Hearing: Thursday, April 30, 1981 at 9:30 A.M.
Office Building, 111 W. Chesapeake Avenue, Towson, Maryland
BY ORDER OF
WILLIAM E. HAMMOND,
Zoning Commissioner
of Baltimore County
Apr. 2, 1981

The Essex Times

Essex, Md., April 9, 1981

This is to Certify, That the annexed

was inserted in The Essex Times, a newspaper printed and published in Baltimore County, once in each of one successive weeks before the 9th day of April, 1981.
Publisher.

BALTIMORE COUNTY OFFICE OF PLANNING & ZONING

County Office Building
111 W. Chesapeake Avenue
Towson, Maryland 21204Your Petition has been received this 3 ds of Feb, 1981.Filing Fee \$ 25.00 Received: ☐ Check
☐ Cash
☐ Other

Item # 147

BALTIMORE COUNTY, MARYLAND
OFFICE OF FINANCE - REVENUE DIVISION
MISCELLANEOUS CASH RECEIPT

No. 097208

DATE March 16, 1981 ACCOUNT 01-662AMOUNT \$25.00RECEIVED FROM Wallace S. Erdman
FOR Filing Fee for Case No. 81-187-A

33324117

250000

VALIDATION OR SIGNATURE OF CASHIER

E. Hammond, Zoning Commissioner

d by SameReviewed by UCR

the Petition for assignment of a

PETITION MAPPING PROGRESS SHEET

FUNCTION	Wall Map		Original		Duplicate		Tracing		200 Sheet	
	date	by	date	by	date	by	date	by	date	by
Descriptions checked and outline plotted on map										
Petition number added to outline										
Denied										
Granted by ZC, BA, CC, CA										
Reviewed by: <u>UCR</u>	Revised Plans: Change in outline or description ☐ Yes ☒ No									
Previous case: _____	Map # <u>3F (N435C)</u>									

Item # 144

BALTIMORE COUNTY, MARYLAND
OFFICE OF FINANCE - REVENUE DIVISION
MISCELLANEOUS CASH RECEIPT

No. 097250

DATE 4/30/81 ACCOUNT 01-662AMOUNT \$44.50RECEIVED FROM Wallace S. Erdman
FOR Variance Petition Case No. 81-187-A

31614420

445000

VALIDATION OR SIGNATURE OF CASHIER

