



BALTIMORE COUNTY
DEPARTMENT OF PERMITS, APPROVALS & INSPECTIONS
111 WEST CHESAPEAKE AVENUE
TOWSON, MD 21204
410-887-3391

SIGN USE PERMIT

Permit Fees are Non-Refundable; Make Check Payable to "Baltimore County, Maryland"

PROPERTY ADDRESS 8803 Pulaski Hwy. ZIP CODE 21237
BUSINESS NAME AT&T ZONING BR
OWNER'S NAME Katy Arthur H. PHONE NO. _____ HISTORIC DISTRICT ☐ Yes ☒ No
MAILING ADDRESS 8801 Pulaski Hwy. Rosedale, MD. 21237
APPLICANT/OWNER'S AGENT Wayne Zinn PHONE NO. 410-789-1640
SIGN COMPANY NAME H&M Signs Inc. PHONE NO. 410-789-1640
TYPE OF SIGN: ☐ Window Sign TAX ACCOUNT NO. 18 / 00 1003202

☐ Temporary- Including Real Estate/Construction/Event Temporary Signs in the Last Year: ☐ Yes ☐ No

☒ Permanent ☐ Changeable Copy ☒ Wall ☒ Face Change Only ☐ Non-Illuminated

☒ Freestanding ☐ Pylon ☐ Monument ☒ Illuminated (separate electrical permit required)

Size: 4 feet x 10 feet = 40 square feet Reface Height: 25 feet (freestanding signs)

Property Line/Street Right-of-Way Setbacks: front 15', sides 65 and 190, and rear 480.

NOTE: A construction plan, drawn to scale and clearly showing that all requirements have been met, must be attached; a site plan also must be attached for freestanding signs.

Table of Sign Regulations: 450.4. Attachment 1, 1.- An Electronic Changeable Copy Sign may only have a maximum Frequency of one instantaneous message change per 15 second cycle.

450.6.B.3 Changeable copy signs must operate at a constant intensity and not give the appearance of movement by flashing, blinking, strobing, scrolling, oscillating, or alternating lights.

PROHIBITIONS: including roof signs (Sections 450.5.B.7 and 450.6.A, Baltimore County Zoning Regulations):

1. Signs cannot impair motorist's clear view of traffic or government signs. All signs are subject to Section 102.5, BCZR.
2. Signs cannot imitate or resemble government signs, except for private traffic control and notice signs.
3. Signs cannot be placed in or project into or above street right of way or governmental property.
4. Sign or framework cannot obstruct window or opening for light and air or access to building, fire hydrant, or stand pipe.
5. Vehicle cannot be parked for the purpose of displaying an attached sign.
6. Except for flags exempted, flags, pennants, ribbons, streamers, tethered balloons, laser projections, and similar objects are prohibited.
7. Portable signs are prohibited, except for A-frame and sandwich board signs issued a use permit in B.M. - C.T. zones.
8. There can be no display or simulation of moving parts or message, except for an outdoor advertising sign with tri-vision, a changeable copy sign, or a thermometer, barometer, weather vane, barber pole, or clock.
9. No sign may emit sound

Work Description (including number of signs, special conditions, materials, locations and size):

- ① Reface existing freestanding sign.
- ② Install illuminated 4'x12' sign on left elevation
- ③ Install illuminated 4'x12' sign on right elevation

CORNER LOT ☒

OWNER/AGENT CERTIFICATION

I solemnly affirm under the penalties of perjury and upon personal knowledge that the contents of the above are true and further agree to locate the proposed sign such that it will not violate Baltimore County laws and regulations.

Signature Wayne Zinn Date 4/25/17 Print/Type Name Wayne Zinn

☐ Require Planning Signature _____ Date _____

Copies: White-Office; Yellow- Applicant (keep this Copy for your permanent records)


REV 10/14

Authority under Section 500.4, BCZR **PAI Approval (SIGN ONLY)**
Signature Wayne Zinn Initials WZ Date 4/25/17



AT&T Authorized
Retailer

SITE PLAN

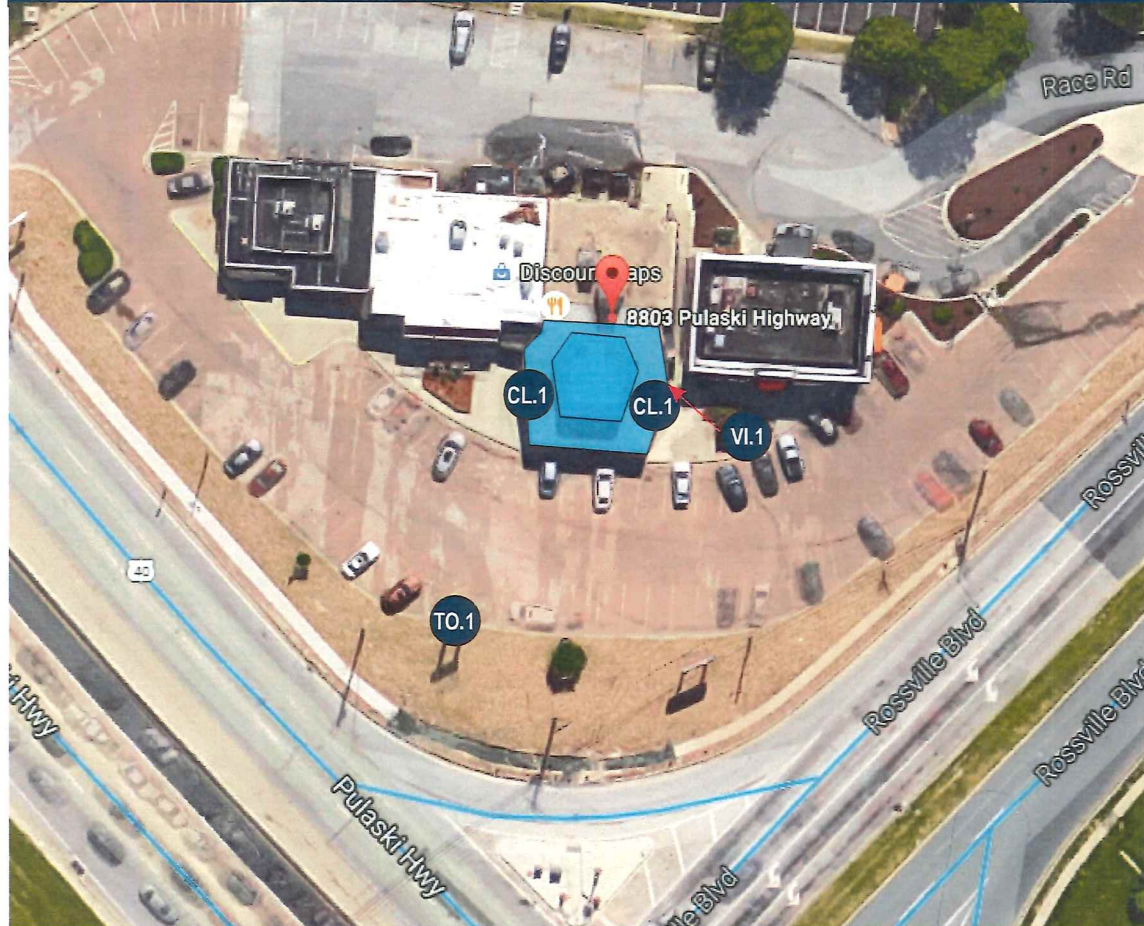

SCOPE OF WORK

- SP.1 ATTD-SP-48X144-G-V STAGING PANEL**
VERTICAL LOCKUPS | STAGING PANEL /3" DEEP
ALUM STAGING PANEL 4'X12' | GRAY (QTY 2)
- CL.1 ATTD-IL-44-BG**
44" ILLUMINATED BLUE GLOBE, DROP IN FACE (QTY. 2)
ATTD-IL-26-W-ML
26" ILLUMINATED WHITE MONIKER LETTERS, DROP IN FACE (QTY. 2)
- TO.1 ATTD-TS-40-H-G**
LEXAN TENANT SIGN, WITH DIGITALLY PRINTED
GRAPHICS - GRAY BACKGROUND (QTY 2)
- VI.1 ATTD-V-DOOR VINYL-R1 (QTY 1)**

JONES SIGN

Your Vision Accomplished

GREEN BAY • PHILADELPHIA
SAN DIEGO • LAS VEGAS

www.jonessign.com

JOB #: 220086-R7

DATE: 12.01.16

DESIGNER: H. MOLES

SALES REP:

PROJ MGR: D. TREXLER

REV.	DATE	BY	DESCRIPTION
1	12.09.16	HM	REMOVED AIR AND REPLACED DOOR VINYL
2	01.17.17	HM	REPLACED FLEX FACE CABINET WITH WALL
3	02.16.17	HM	ADDED BUILDING DIMENSIONS
4	00.00.00	XX	BANNER DRAWING
5	03.23.17	RM	REMOVE FRONT ELEVATION LOWER SIGNS. REDUCE SIZE
6	04.03.17	HM	CHANGES PER MARK UP
7	04.06.17	HM	CHANGED BACK TO HORIZ LAYOUT/RESIZED

CLIENT APPROVAL	DATE
LANDLORD APPROVAL	DATE
QC	

AT&T-DEALER -#9043
8803 Pulaski Highway
Rosedale, MD 21237

DESIGN PHASE: CONCEPTUAL

SHEET NUMBER

0.1

This is an original, unpublished drawing by Jones Sign Co., Inc. It is for your personal use in conjunction with a project being planned for you by JONES SIGN. It is not to be shown to anyone outside of your organization, nor is it to be used, reproduced, copied or exhibited in any fashion. Use of this design or the salient elements of this design in any sign done by any other company, without the express written permission of JONES SIGN, is forbidden by law and carries a civil forfeiture of up to 25% of the purchase price of the sign. JONES SIGN will endeavor to closely match colors, including PMS, where specified. We cannot guarantee exact matches due to varying compatibility of surface materials and paints used. All sizes and dimensions are illustrated for client's conception of project and are not to be understood as being exact size or exact scale.



max. 3' above
fascia band



TO.1 ATTD-TS-40-H-G LEXAN TENANT SIGN, WITH DIGITALLY PRINTED GRAPHICS - GRAY BACKGROUND (QTY 2)

SQUARE FOOTAGE: 39.42




EXISTING ELEVATION

N.T.S.




PROPOSED ELEVATION

N.T.S.

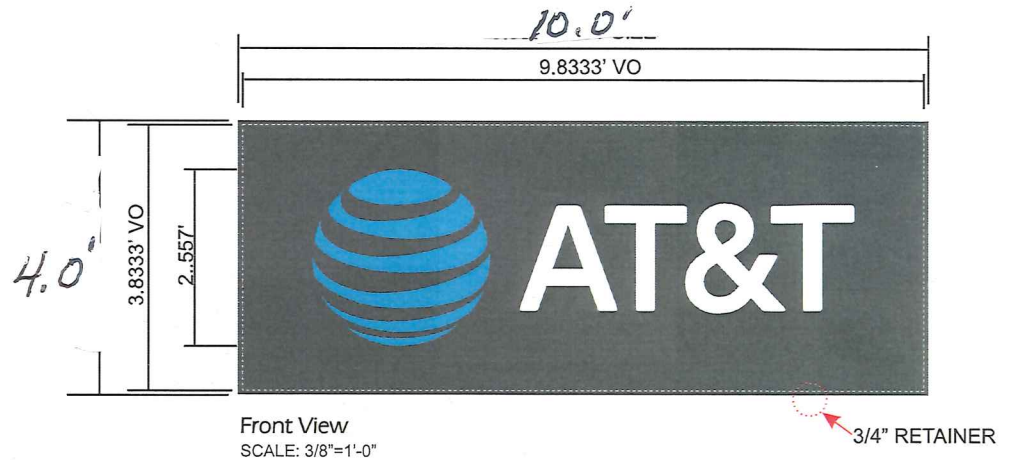

Front View
SCALE: 3/8"=1'-0"

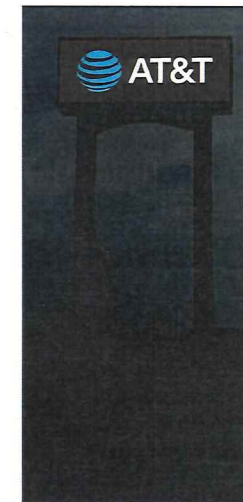

Evening View
SCALE: N.T.S.

SPECIFICATIONS:

1. WHITE LEXAN WITH FIRST SURFACE APPLIED VINYL LOGO GRAPHICS V-1 V-2

COLORS/FINISHES:

- | | | |
|---|-----|---|
|  | L-1 | WHITE LEXAN |
|  | V-1 | 3M #7725-41 DARK GRAY
LAMINATED TO 3M #3635-20B WHITE BLOCKOUT |
|  | V-2 | TO MATCH 3M #3630-7775 BLUE |

JONES SIGN
Your Vision Accomplished
GREEN BAY • PHILADELPHIA
SAN DIEGO • LAS VEGAS
www.jonessign.com

JOB #: 220086-R7
DATE: 12.01.16
DESIGNER: H. MOLES
SALES REP:
PROJ MGR: D. TREXLER

REV.	DATE	BY	DESCRIPTION
1	12.09.16	HM	REMOVED AR AND REPLACED DOOR VINYL
2	01.17.17	HM	REFLUXED FLEX FACE CABINET WITH WALL
3	02.16.17	HM	ADDED BUILDING DIMENSIONS
4	00.00.00	XX	BANNER DRAWING
5	03.23.17	RM	REMOVE FRONT ELEVATION LOWER SIGNS, REDUCE SIZE
6	04.03.17	HM	CHANGES PER MARK UP
7	04.06.17	HM	CHANGED BACK TO HORIZ LAYOUT/RESIZED

CLIENT APPROVAL	DATE
LANDLORD APPROVAL	DATE
QC	QC APPROVED By history at 12:25 pm, Apr 0

AT&T-DEALER #9043
8803 Pulaski Highway
Rosedale, MD 21237
DESIGN PHASE: CONCEPTUAL

SHEET NUMBER
2.0

This is an original, unpublished drawing by Jones Sign Co., Inc. It is for your personal use in conjunction with a project being planned for you by JONES SIGN. It is not to be shown to anyone outside of your organization, nor is it to be used, reproduced, copied or exhibited in any fashion. Use of this design or the salient elements of this design in any sign done by any other company, without the express written permission of JONES SIGN, is forbidden by law and carries a civil forfeiture of up to 25% of the purchase price of the sign. JONES SIGN will endeavor to closely match colors, including PMS, where specified. We cannot guarantee exact matches due to varying compatibility of surface materials and paints used. All sizes and dimensions are illustrated for client's conception of project and are not to be understood as being exact size or exact scale.

SP.1/CL.1 ATTD-SP-48X144-G-V STAGING PANEL VERTICAL LOCKUPS | STAGING PANEL /3" DEEP ALUM STAGING PANEL 4'X12' | GRAY (QTY 2)
ATTD-IL-44-BG 44" ILLUMINATED BLUE GLOBE, DROP IN FACE (QTY. 2) **ATTD-IL-26-W-ML** 26" ILLUMINATED WHITE MONIKER LETTERS, DROP IN FACE (QTY. 2)
 SQUARE FOOTAGE: 48.0



EXISTING ELEVATION
 SCALE: 1/16"=1'-0"



EXISTING ELEVATION
 SCALE: 1/16"=1'-0"


SPECIFICATIONS: GLOBE

1. FABRICATED GLOBE LOGO WITH CLEAR 1/2" MODIFIED FACE.
 3M 3630-7775 BLUE APPLIED FIRST SURFACE **V-1**
 AND 3M 3635-70 DIFFUSER APPLIED 2ND SURFACE **V-2**
2. RETURNS FINISHED MP77101 BLUE, SATIN FINISH. **P-1**
3. 3" STAGING PANEL USED FOR WIREWAY WILL BE FINISHED TO MATCH **P-3**


SPECIFICATIONS: LETTERS

1. 1/2" CLEAR MODIFIED ACRYLIC WITH
 WHITE DIFFUSER APPLIED SECOND SURFACE **V-2**
2. RETURNS PAINTED MP 65457 WHITE, SATIN FINISH **P-2**
3. 3" STAGING PANEL USED FOR WIREWAY WILL BE FINISHED TO MATCH **P-3**

NOTE: Mounting to fascia band must be field verified

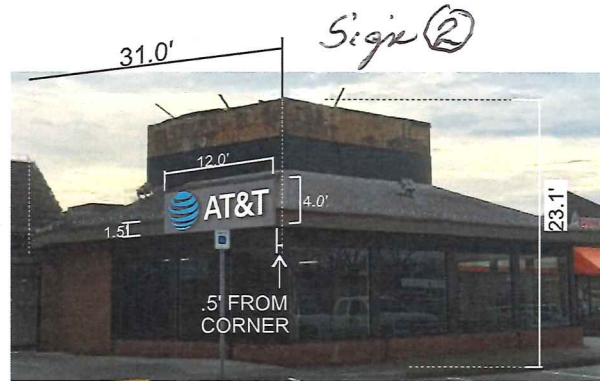


PROPOSED ELEVATION
 SCALE: 1/16"=1'-0"

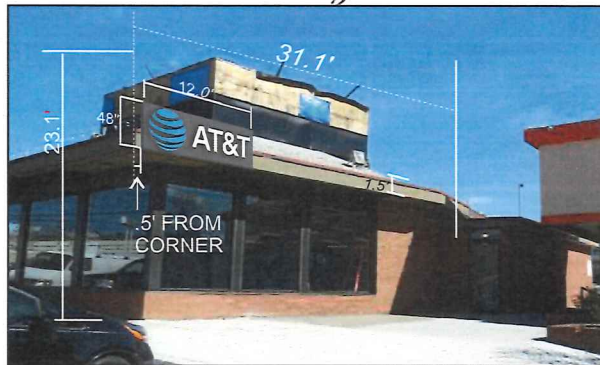

PROPOSED ELEVATION
 SCALE: 1/16"=1'-0"

COLORS/FINISHES

- GLOBE**
- V-1** 3M 3630-7775 BLUE
 - V-2** 3M 3635-70 DIFFUSER
 - P-1** MP77101 BLUE, SATIN FINISH (TO MATCH 299C)
- LETTERS**
- P-2** MP 65457 WHITE, SATIN FINISH
- STAGING PANEL**
- P-3** MP36465 SATIN FINISH

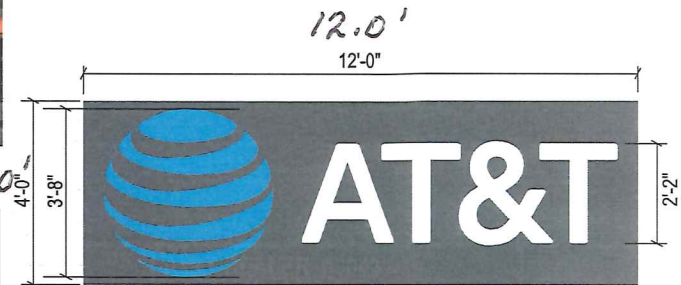

FRONT VIEW
 SCALE: 1/4"=1'-0"

JONES SIGN

Your Vision Accomplished

GREEN BAY • PHILADELPHIA
 SAN DIEGO • LAS VEGAS

www.jonessign.com

JOB #: 220086-R7

DATE: 12.01.16

DESIGNER: H. MOLES

SALES REP:

PROJ MGR: D. TREXLER

REV.	DATE	BY	DESCRIPTION
1	12.09.16	HM	REMOVED AR AND REPLACED DOOR VINYL
2	01.17.17	HM	REPLACED FLEX FACE CABINET WITH WALL
3	02.16.17	HM	ADDED BUILDING DIMENSIONS
4	06.00.00	XX	BANNER DRAWING
5	03.23.17	RM	REMOVE FRONT ELEVATION LOWER SIGNS, REDUCE SIZE
6	04.03.17	HM	CHANGES PER MARK UP
7	04.06.17	HM	CHANGED BACK TO HORIZ LAYOUT/RESIZED

CLIENT APPROVAL

DATE

LANDLORD APPROVAL

DATE

QC APPROVED
 By notary at 12:25 pm, Apr 0

AT&T-DEALER #9043

8803 Pulaski Highway
 Rosedale, MD 21237

DESIGN PHASE: CONCEPTUAL

SHEET NUMBER

1.0

This is an original, unpublished drawing by Jones Sign Co., Inc. It is for your personal use in conjunction with a project being planned for you by JONES SIGN. It is not to be shown to anyone outside of your organization, nor is it to be used, reproduced, copied or exhibited in any fashion. Use of this design or the salient elements of this design in any sign done by any other company, without the express written permission of JONES SIGN, is forbidden by law and carries a civil forfeiture of up to 25% of the purchase price of the sign. JONES SIGN will endeavor to closely match colors, including PMS, where specified. We cannot guarantee exact matches due to varying compatibility of surface materials and paints used. All sizes and dimensions are illustrated for client's conception of project and are not to be understood as being exact size or exact scale.