



BALTIMORE COUNTY
DEPARTMENT OF PERMITS, APPROVALS & INSPECTIONS
111 WEST CHESAPEAKE AVENUE
TOWSON, MD 21204
410-887-3391

SIGN USE PERMIT

Permit Fees are Non-Refundable; Make Check Payable to "Baltimore County, Maryland"

PROPERTY ADDRESS 10201 Reisterstown Rd ZIP CODE 21117
BUSINESS NAME CVS Pharmacy ZONING Bm
OWNER'S NAME CDN Holdings LLC PHONE NO. 717-261-7801 HISTORIC DISTRICT ☐ Yes ☒ No
MAILING ADDRESS Po Box 4833 Luthersville MD 21094
APPLICANT/OWNER'S AGENT Rick Pepper / Betsy Marino PHONE NO. 703-408-8214
SIGN COMPANY NAME Service Neon Signs PHONE NO. 703-354-3000
TYPE OF SIGN: ☐ Window Sign TAX ACCOUNT NO. 16 1000 04499

☐ Temporary- Including Real Estate/Construction/Event Temporary Signs in the Last Year: ☐ Yes ☐ No
☒ Permanent ☐ Changeable Copy ☐ Wall ☐ Face Change Only ☐ Non-Illuminated
☒ Freestanding ☒ Pylon ☐ Monument ☒ Illuminated (separate electrical permit required)
Size: 7.00 feet x 10.50 feet = 73.50 square feet Height: 24 feet (freestanding signs)

Property Line/Street Right-of-Way Setbacks: front 39, sides 40 and _____, and rear _____.

NOTE: A construction plan, drawn to scale and clearly showing that all requirements have been met, must be attached; a site plan also must be attached for freestanding signs.

Table of Sign Regulations: 450.4. Attachment 1, 1.- An Electronic Changeable Copy Sign may only have a maximum Frequency of one instantaneous message change per 15 second cycle.

450.6.B.3 Changeable copy signs must operate at a constant intensity and not give the appearance of movement by flashing, blinking, strobing, scrolling, oscillating, or alternating lights.

PROHIBITIONS: including roof signs (Sections 450.5.B.7 and 450.6.A, Baltimore County Zoning Regulations):

1. Signs cannot impair motorist's clear view of traffic or government signs. All signs are subject to Section 102.5, BCZR.
2. Signs cannot imitate or resemble government signs, except for private traffic control and notice signs.
3. Signs cannot be placed in or project into or above street right of way or governmental property.
4. Sign or framework cannot obstruct window or opening for light and air or access to building, fire hydrant, or stand pipe.
5. Vehicle cannot be parked for the purpose of displaying an attached sign.
6. Except for flags exempted, flags, pennants, ribbons, streamers, tethered balloons, laser projections, and similar objects are prohibited.
7. Portable signs are prohibited, except for A-frame and sandwich board signs issued a use permit in B.M. - C.T. zones.
8. There can be no display or simulation of moving parts or message, except for an outdoor advertising sign with tri-vision, a changeable copy sign, or a thermometer, barometer, weather vane, barber pole, or clock.
9. No sign may emit sound

Work Description (including number of signs, special conditions, materials, locations and size):

Install 1 - 7.00 x 10.50 pylon @ 24' H reading CVS Pharmacy
Drive Thru @ 73.50 sq
~~1 - 1.50 x 1.50 DO NOT ENTER directional~~
~~@ 2.75 sq~~

CORNER LOT ☒

OWNER/AGENT CERTIFICATION

I solemnly affirm under the penalties of perjury and upon personal knowledge that the contents of the above are true and further agree to locate the proposed sign such that it will not violate Baltimore County laws and regulations.

Signature

Date

Print/Type Name

☐ Require Planning Signature

Date

Copies: White-Office; Yellow- Applicant (keep this Copy for your permanent records)

REV 10/14

Authority under Section 500.4, BCZR PAI Approval (SIGN ONLY)


Signature

Initials

Date

A 1

Qty. - 1

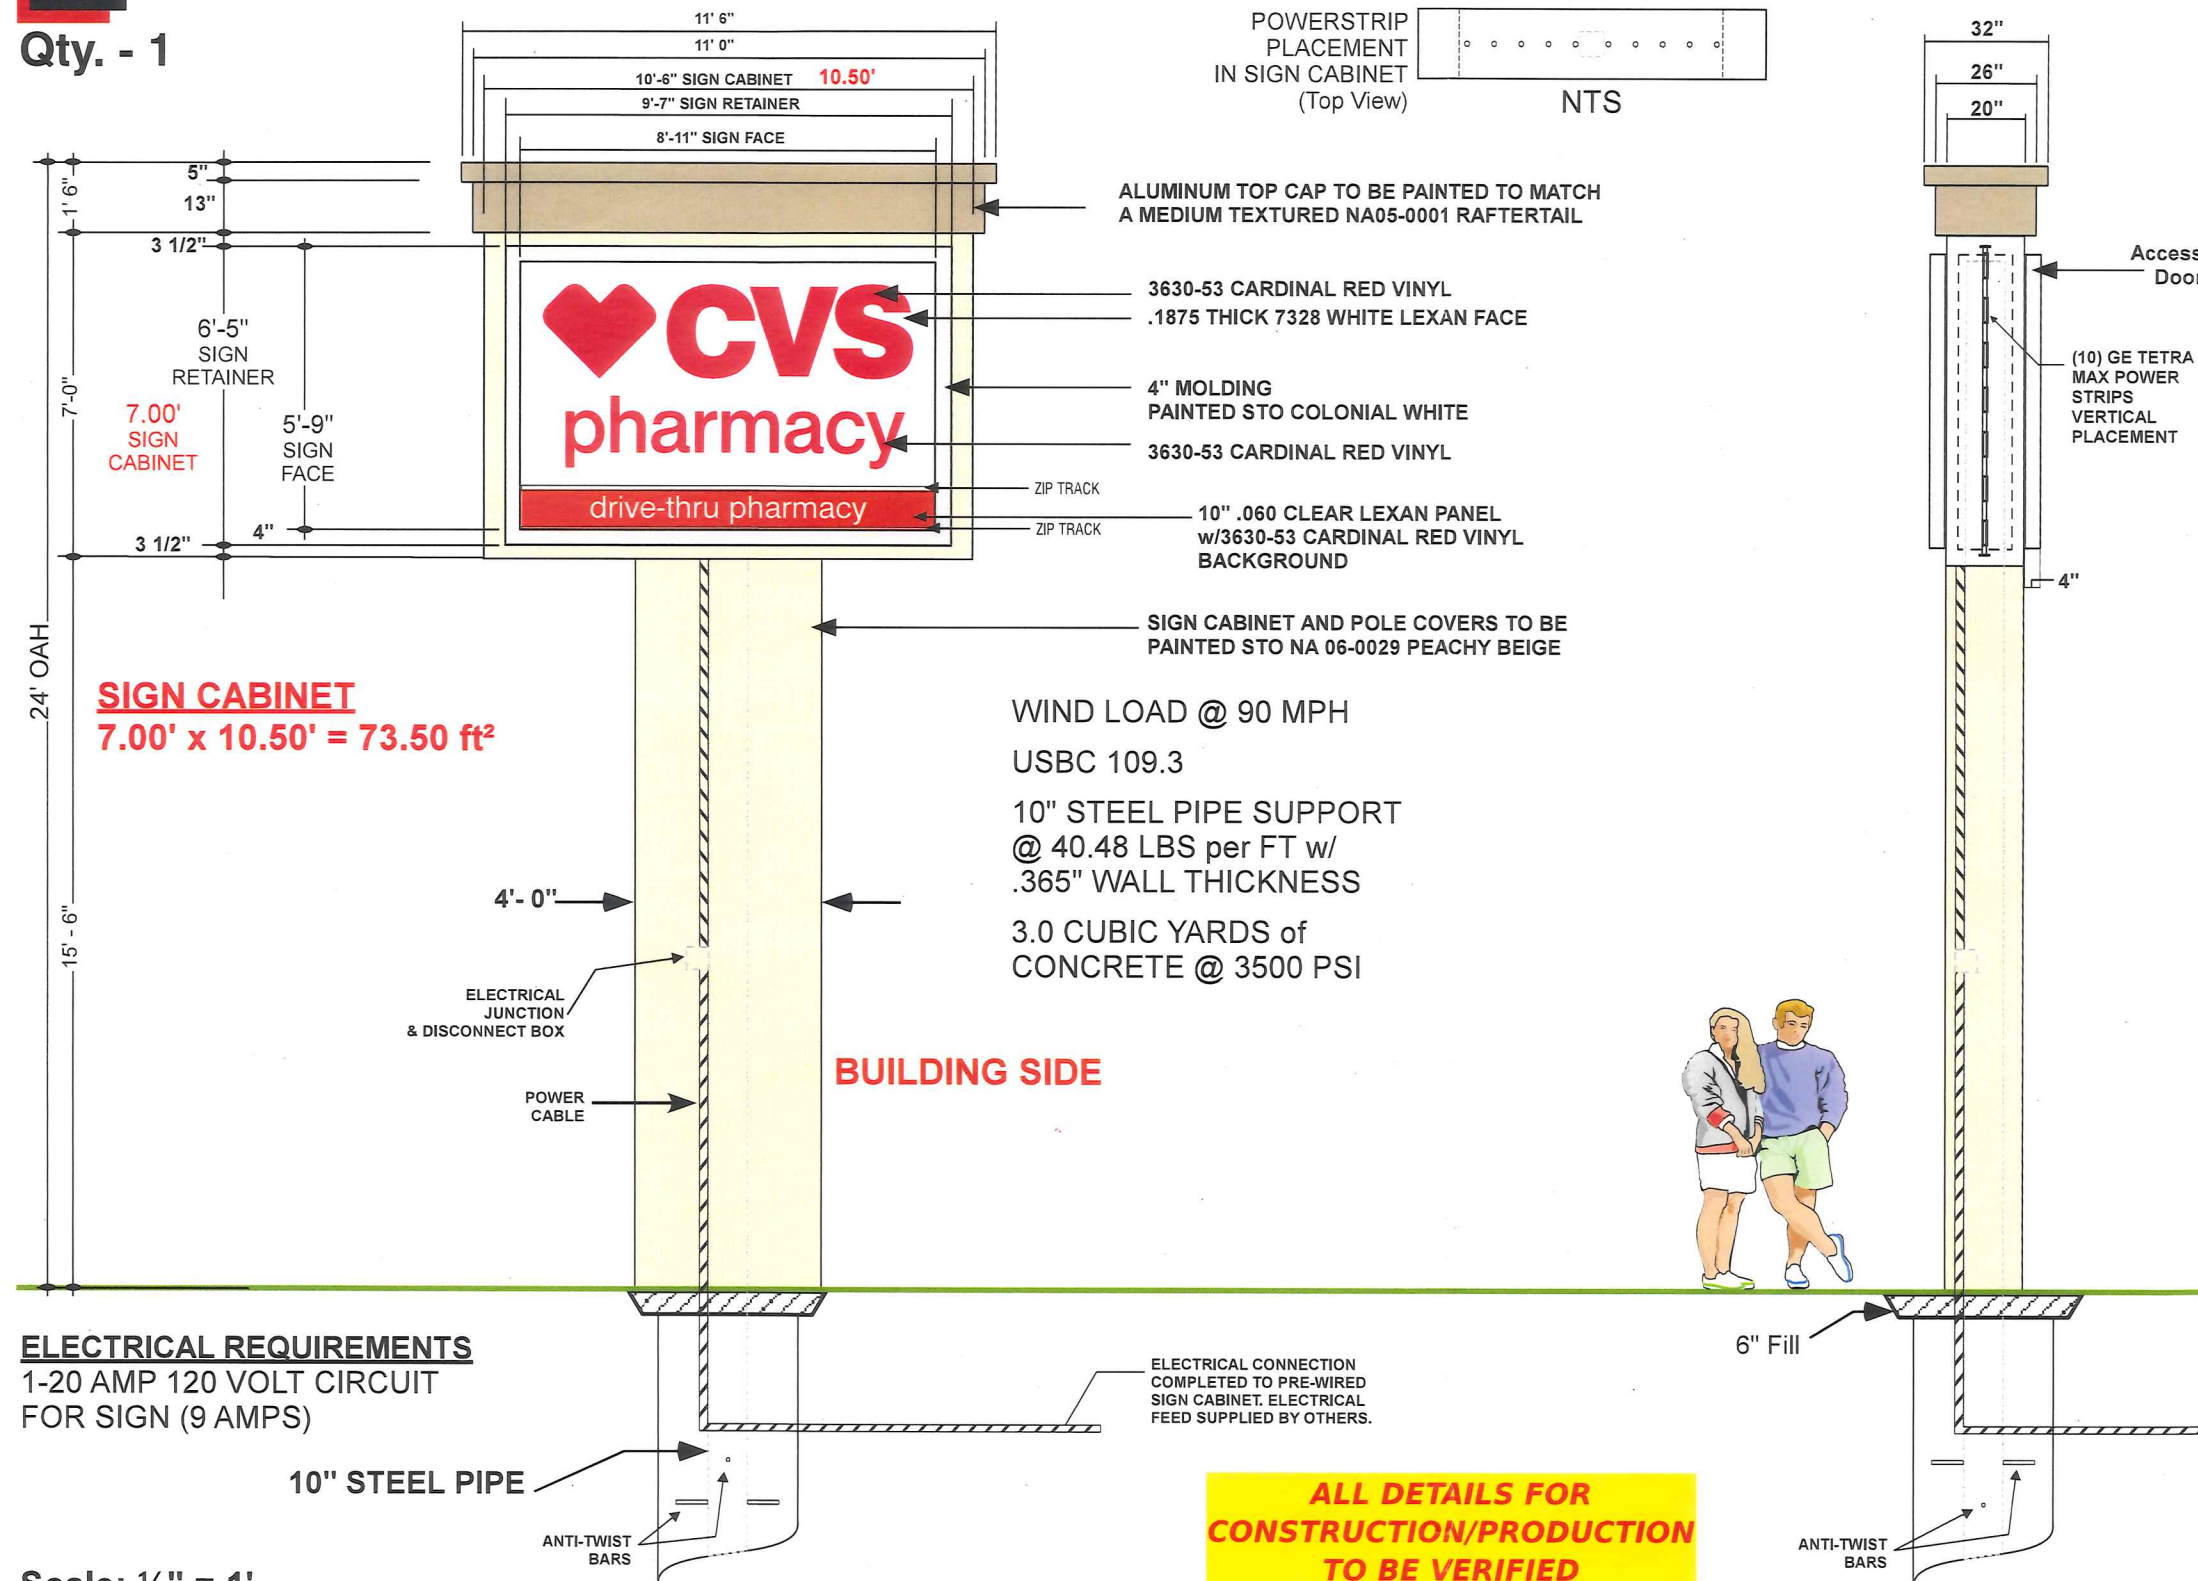

MANUFACTURE AND INSTALL:
ONE (1) 24'-0" x 11'-0" x 1'-8" (Deep)
DOUBLE FACED INTERNALLY ILLUMINATED
FREESTANDING SIGN CABINET w/ I. D. HEADER

MESSAGE: **CVS/pharmacy**
DRIVE-THRU PHARMACY

MATERIAL:
CABINETS CONSTRUCTED OF ANGLE FRAME
COVERED WITH .090 ALUMINUM SHEET,
SPRAYED TO MATCH **STO NA06-0029**
PEACHY BEIGE ON ALL EXTERIOR SURFACES
AND WHITE ENAMEL ON ALL INTERNAL SURFACES.

LIGHTING:
FROM AN INTERNAL SOURCE OF GE TETRA
MAX POWER STRIPS, POWERED BY
GEPS24W-80 POWER SUPPLIES. ALL
WIRING AND LIGHTING COMPONENTS WILL BE
U.L. APPROVED AND A U.L. LABEL
WILL BE ATTACHED TO THE EXTERIOR
OF THE CABINET.

FACES:
CONSTRUCTED OF 3/16" #7328 WHITE ACRYLIC
SHEET WITH REMOVABLE MOLDINGS
& APPLIED #230-53 TRANSLUCENT CARDINAL
RED COPY w/BLACK OUTLINE.

INSTALLATION:
SIGN CABINET MOUNTED ON ONE (1) 10" STEEL
PIPE (SCHEDULE 40) SUPPORT
10" STEEL PIPE SUPPORT @ 40.48 LBS
per FT w/ .375" WALL THICKNESS
(SPRAYED WHITE) SET IN CONCRETE FOOTER
AS SHOWN.

ELECTRICAL:
TO SIGN LOCATION BY OTHERS.

SEE NEXT PAGE FOR FOOTER DETAIL

ELECTRICAL REQUIREMENTS
1-20 AMP 120 VOLT CIRCUIT
FOR SIGN (9 AMPS)

Scale: 1/4" = 1'

ALL DETAILS FOR
CONSTRUCTION/PRODUCTION
TO BE VERIFIED

**SERVICE
NEON
SIGNS
INC**

6611 IRON PLACE
SPRINGFIELD, VA. 22151
PHONE: (703) 354-3000
FAX: (703) 354-5810

CUSTOMER NAME

CVS pharmacy

#10892

LOCATION

10201 Reisterstown Road
Owings Mills, MD 21117

DRAWING #

5-17-179

DATE

06/19/17


SALESPERSON

Rick Pepper

This design is the property of Service Neon Signs. Unauthorized use in whole or in part is prohibited, violators will be prosecuted in the fullest extent of the law.
This sign is intended to be installed in accordance with the requirements of Article 600 of the National Electrical Code and/or other applicable local codes. This includes proper grounding and bonding of the sign.

APPROVALS

CUSTOMER _____
SALES _____
PRODUCTION _____
INSTALLATION _____

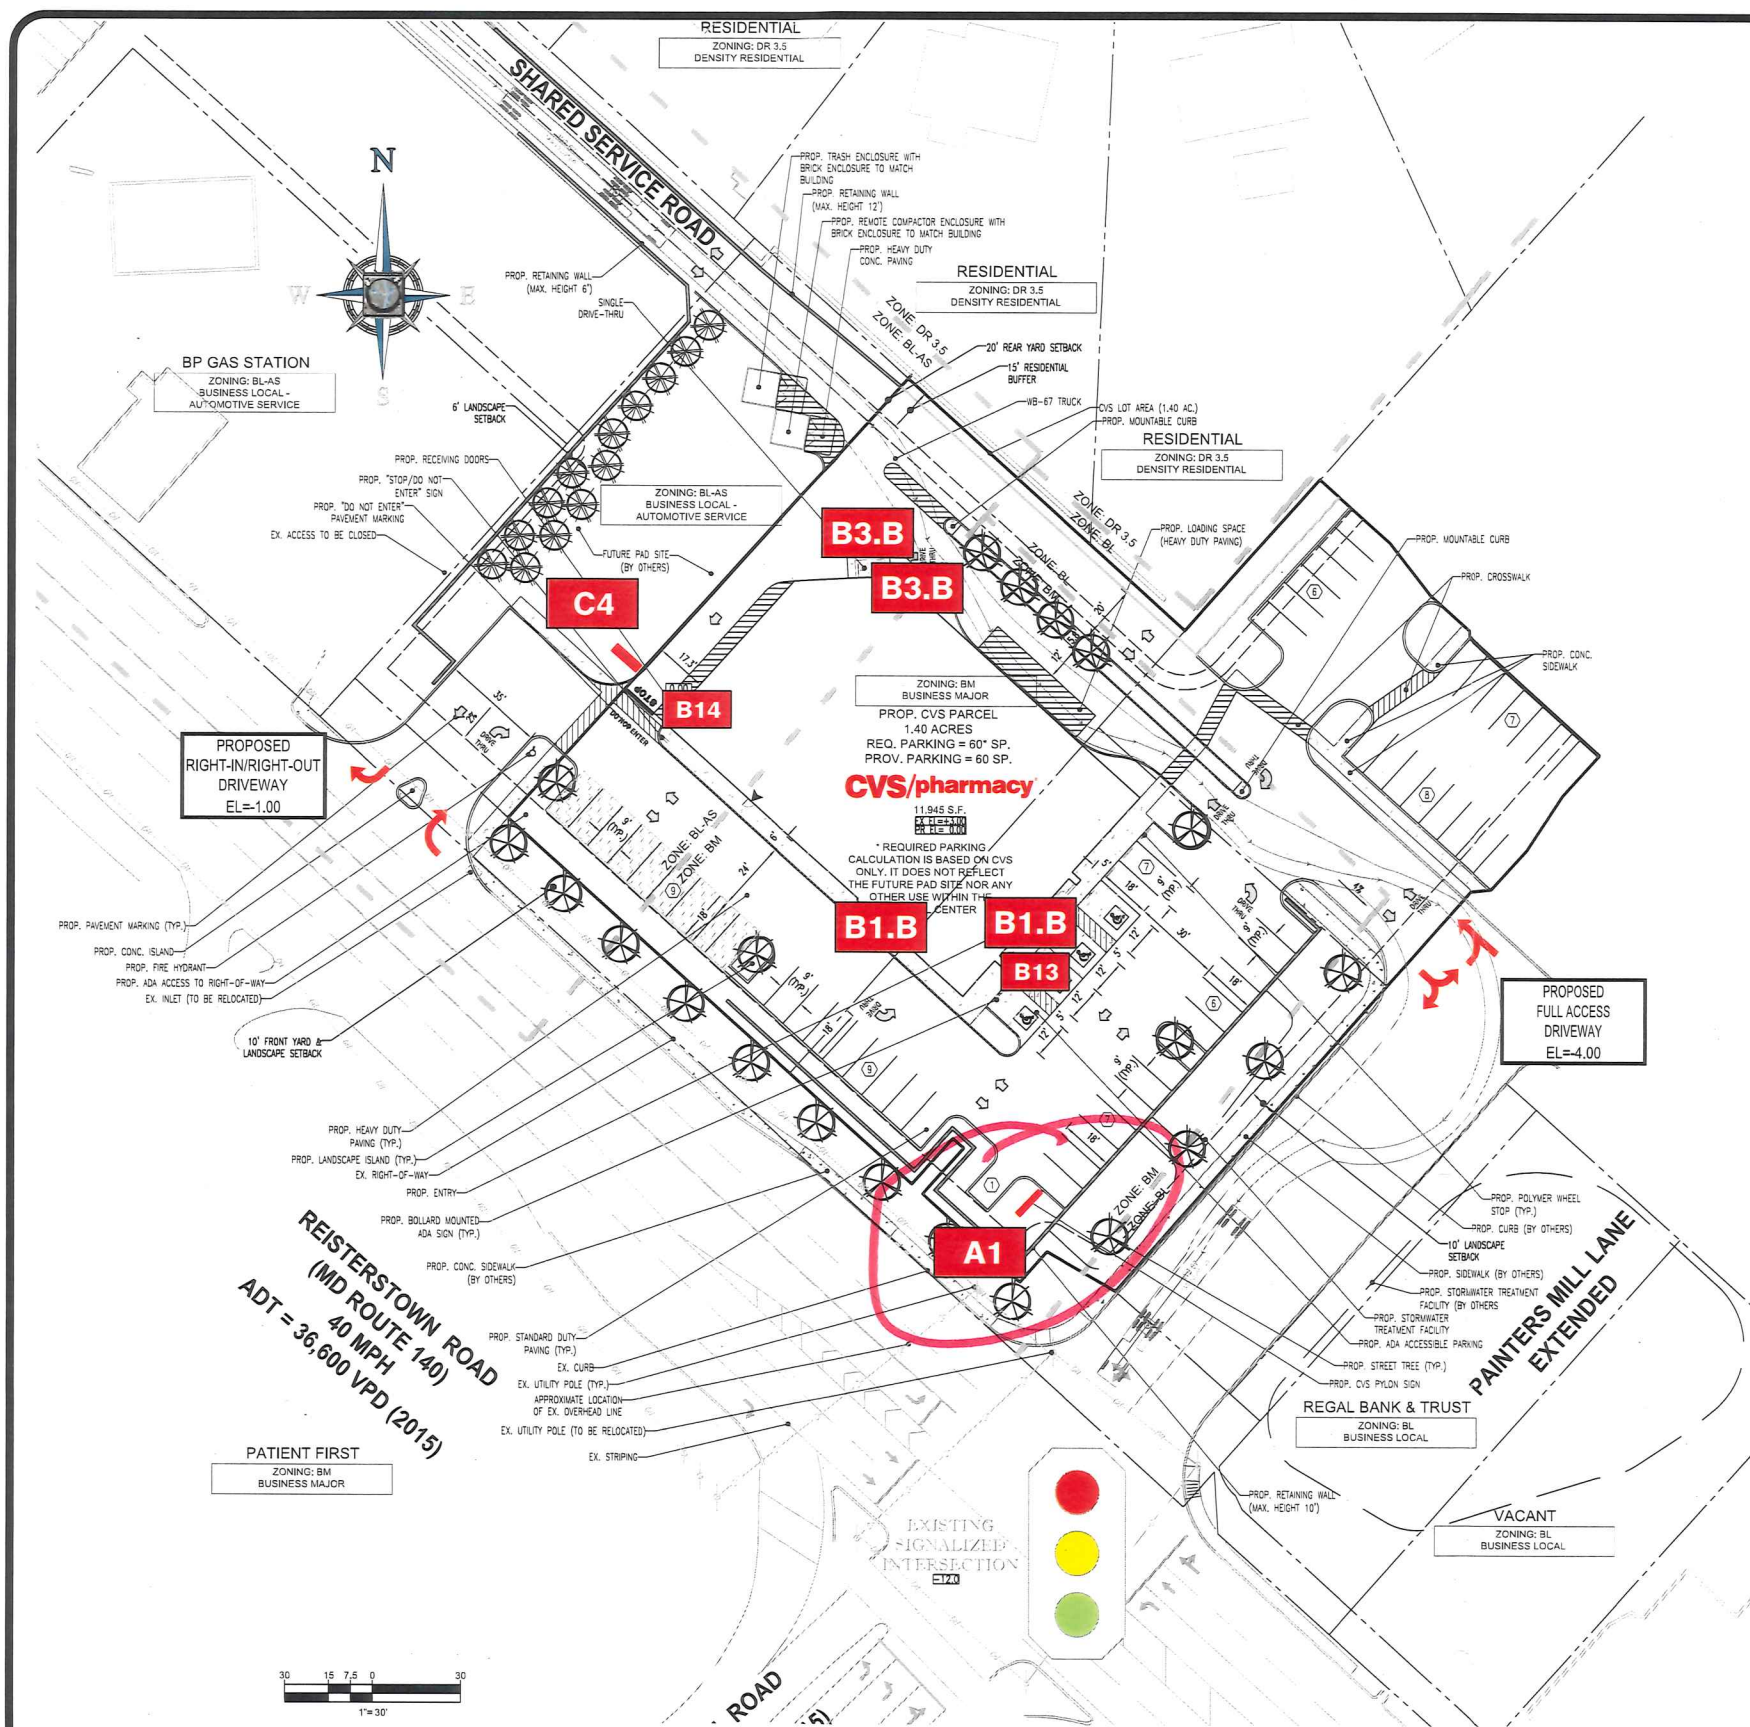

A1 — Custom Single Pole Pylon - 24' OAH / Qty 1

B1.B — ♥CVSpharmacy - Qty 2
IL-39-CL-L
NOTE: One (1) Letterset mounted on rails.

B3.B — 6" drive-thru pharmacy
Illuminated - Qty 1
Canopy Clearance vinyl letters included

B3.B — 6" drive-thru pharmacy
Illuminated - Qty 1

B13 — Operating Hours - Qty 1
18 9/16" x 14 1/2"

B14 — Receiving Door Sign - Qty 1
18" x 24"

C4 — Do Not Enter / Thank You - Qty 1
18" x 18" D/F