

2019-0419SI



BALTIMORE COUNTY
DEPARTMENT OF PERMITS, APPROVALS & INSPECTIONS
111 WEST CHESAPEAKE AVENUE
TOWSON, MD 21204
410-887-3391

B
A 187080

The applicant is authorized to affirm that there are no current violations at this site pursuant to Section 112.7 BCC

Initials *Bm*

SIGN USE PERMIT

Permit Fees are Non-Refundable; Make Check Payable to "Baltimore County, Maryland"

PROPERTY ADDRESS 4701 Wilkens Ave ZIP CODE 21228
BUSINESS NAME CUS Pharmacy ZONING BL
OWNER'S NAME Maryland CUS Pharmacy LLC PHONE NO. _____ HISTORIC DISTRICT ☐ Yes ☒ No
MAILING ADDRESS % CUS Health, One CUS Drive, Woonsocket RI 02895
APPLICANT/OWNER'S AGENT Betsy Marino / Rick Pepper PHONE NO. 703-408-8216
SIGN COMPANY NAME Service New Signs PHONE NO. 703-354-3000
TYPE OF SIGN: ☐ Window Sign TAX ACCOUNT NO. 160,000,5437

☐ Temporary- Including Real Estate/Construction/Event

Temporary Signs in the Last Year: ☐ Yes ☐ No

☒ Permanent ☐ Changeable Copy ☒ Wall ☐ Face Change Only ☒ Non-Illuminated

☐ Freestanding ☐ Pylon ☐ Monument ☒ Illuminated (separate electrical permit required)

Size: 7.6 feet x 9.80 feet = 7.40 square feet

Height: _____ feet (freestanding signs)

Property Line/Street Right-of-Way Setbacks: front _____, sides _____ and _____, and rear _____.

NOTE: A construction plan, drawn to scale and clearly showing that all requirements have been met, must be attached; a site plan also must be attached for freestanding signs.

Table of Sign Regulations: 450.4. Attachment 1, 1.- An Electronic Changeable Copy Sign may only have a maximum Frequency of one instantaneous message change per 15 second cycle.

PROHIBITIONS: including roof signs (Sections 450.5.B.7 and 450.6.A, Baltimore County Zoning Regulations):

1. Signs cannot impair motorist's clear view of traffic or government signs. All signs are subject to Section 102.5, BCZR.
2. Signs cannot imitate or resemble government signs, except for private traffic control and notice signs.
3. Signs cannot be placed in or project into or above street right of way or governmental property.
4. Sign or framework cannot obstruct window or opening for light and air or access to building, fire hydrant, or stand pipe.
5. Vehicle cannot be parked for the purpose of displaying an attached sign.
6. Except for flags exempted, flags, pennants, ribbons, streamers, tethered balloons, laser projections, and similar objects are prohibited.
7. Portable signs are prohibited, except for A-frame and sandwich board signs issued a use permit in B.M. - C.T. zones.
8. There can be no display or simulation of moving parts or message, except for an outdoor advertising sign with tri-vision, a changeable copy sign, or a thermometer, barometer, weather vane, barber pole, or clock.
9. No sign may emit sound

450.6.B.3 Changeable copy signs must operate at a constant intensity and not give the appearance of movement by flashing, blinking, strobing, scrolling, oscillating, or alternating lights.

Work Description (including number of signs, special conditions, materials, locations and size):

Install 2 illuminated Directional signs located on Drive thru Pharmacy canopy. one @ 8.23 ft and one @ 9.40

Install one non-illuminated Receiving door panel @ 3 ft

CORNER LOT ☒

OWNER/AGENT CERTIFICATION

I solemnly affirm under the penalties of perjury and upon personal knowledge that the contents of the above are true and further agree to locate the proposed sign such that it will not violate Baltimore County laws and regulations.

Signature

Date

Print/Type Name

☐ Require Planning Signature

Date

Copies: White-Office; Yellow- Applicant (keep this Copy for your permanent records)

REV 03/12

Authority under Section 500.4, BCZR PAI Approval (SIGN ONLY)

Signature

Initials

Date

JSS 7/29/19



BALTIMORE COUNTY
DEPARTMENT OF PERMITS, APPROVALS & INSPECTIONS
111 WEST CHESAPEAKE AVENUE
TOWSON, MD 21204
410-887-3391

B _____
A 187080
The applicant is authorized to affirm that there are no current violations at this site pursuant to Section 112.7 BCC
Initials BM

SIGN USE PERMIT

Permit Fees are Non-Refundable; Make Check Payable to "Baltimore County, Maryland"

PROPERTY ADDRESS 4701 Wilkens Ave ZIP CODE 21228
BUSINESS NAME CVS Pharmacy ZONING BL
OWNER'S NAME Maryland CVS Pharmacy, LLC PHONE NO. _____ HISTORIC DISTRICT ☐ Yes ☒ No
MAILING ADDRESS % CVS Health, One CVS Dr, Woonsocket RI 02895
APPLICANT/OWNER'S AGENT Betsy Marino / Rick Pepper PHONE NO. 703-408-9216
SIGN COMPANY NAME Service Neon Signs PHONE NO. 703-354-3000
TYPE OF SIGN: ☐ Window Sign TAX ACCOUNT NO. 160 1000 5437

☐ Temporary- Including Real Estate/Construction/Event Temporary Signs in the Last Year: ☐ Yes ☐ No

☒ Permanent ☐ Changeable Copy ☐ Wall ☐ Face Change Only ☐ Non-Illuminated

☒ Freestanding ☒ Pylon ☒ Monument ☒ Illuminated (separate electrical permit required)

Size: 7.66 feet x 11.25 feet = 86.18 square feet Height: 24 1/2 feet (freestanding signs)

Property Line/Street Right-of-Way Setbacks: front 1/13, sides _____ and _____, and rear _____.

NOTE: A construction plan, drawn to scale and clearly showing that all requirements have been met, must be attached; a site plan also must be attached for freestanding signs.

Table of Sign Regulations: 450.4. Attachment 1, 1.- An Electronic Changeable Copy Sign may only have a maximum Frequency of one instantaneous message change per 15 second cycle.

450.6.B.3 Changeable copy signs must operate at a constant intensity and not give the appearance of movement by flashing, blinking, strobing, scrolling, oscillating, or alternating lights.

PROHIBITIONS: including roof signs (Sections 450.5.B.7 and 450.6.A, Baltimore County Zoning Regulations):

1. Signs cannot impair motorist's clear view of traffic or government signs. All signs are subject to Section 102.5, BCZR.
2. Signs cannot imitate or resemble government signs, except for private traffic control and notice signs.
3. Signs cannot be placed in or project into or above street right of way or governmental property.
4. Sign or framework cannot obstruct window or opening for light and air or access to building, fire hydrant, or stand pipe.
5. Vehicle cannot be parked for the purpose of displaying an attached sign.
6. Except for flags exempted, flags, pennants, ribbons, streamers, tethered balloons, laser projections, and similar objects are prohibited.
7. Portable signs are prohibited, except for A-frame and sandwich board signs issued a use permit in B.M. - C.T. zones.
8. There can be no display or simulation of moving parts or message, except for an outdoor advertising sign with tri-vision, a changeable copy sign, or a thermometer, barometer, weather vane, barber pole, or clock.
9. No sign may emit sound

Work Description (including number of signs, special conditions, materials, locations and size):

Install one pylon sign 24' High, 7.66' x 11.25' cabinet @ 86.18 \$
~~Install one monument sign 12' high, 19.5' x 11.25' upper cabinet @ 61.02 \$~~
~~and lower cabinet 6' x 6' @ 40.02 \$~~
CORNER LOT ☒

OWNER/AGENT CERTIFICATION

I solemnly affirm under the penalties of perjury and upon personal knowledge that the contents of the above are true and further agree to locate the proposed sign such that it will not violate Baltimore County laws and regulations.

Signature _____

Date _____

Print/Type Name Betsy Marino

☐ Require Planning Signature _____

Date _____

Copies: White-Office; Yellow- Applicant (keep this Copy for your permanent records)

REV 10/14

Authority under Section 500.4, BCZR **PAI Approval (SIGN ONLY)**

Signature _____

Initials JSS

Date 7/29/19



BALTIMORE COUNTY
DEPARTMENT OF PERMITS, APPROVALS & INSPECTIONS
111 WEST CHESAPEAKE AVENUE
TOWSON, MD 21204
410-887-3391

B _____
A 187080
The applicant is authorized
to affirm that there are no
current violations at this
site pursuant to Section
112.7 BCC
Initials BMM

SIGN USE PERMIT

Permit Fees are Non-Refundable; Make Check Payable to "Baltimore County, Maryland"

PROPERTY ADDRESS 4701 Wilkens Ave ZIP CODE 21228
BUSINESS NAME CVS Pharmacy ZONING BL
OWNER'S NAME Maryland CVS Pharmacy LLC PHONE NO. _____ HISTORIC DISTRICT ☐ Yes ☒ No
MAILING ADDRESS 90 CVS Health, One CVS Dr, Woonsocket RI 02895
APPLICANT/OWNER'S AGENT Betsy Marino / Rick Pepper PHONE NO. 703-408-8216
SIGN COMPANY NAME Service Neon Signs PHONE NO. 7033543000
TYPE OF SIGN: ☐ Window Sign TAX ACCOUNT NO. 160100015437

☐ Temporary- Including Real Estate/Construction/Event Temporary Signs in the Last Year: ☐ Yes ☐ No
☒ Permanent ☐ Changeable Copy ☒ Wall ☐ Face Change Only ☒ Non-Illuminated
☐ Freestanding ☐ Pylon ☐ Monument ☒ Illuminated (separate electrical permit required)
Size: 20 3.54' feet x 26.46' feet = 93.67 square feet Height: _____ feet (freestanding signs)

Property Line/Street Right-of-Way Setbacks: front _____, sides _____ and _____, and rear _____.

NOTE: A construction plan, drawn to scale and clearly showing that all requirements have been met, must be attached; a site plan also must be attached for freestanding signs.

Table of Sign Regulations: 450.4. Attachment 1, 1.- An Electronic Changeable Copy Sign may only have a maximum Frequency of one instantaneous message change per 15 second cycle.

PROHIBITIONS: including roof signs (Sections 450.5.B.7 and 450.6.A, Baltimore County Zoning Regulations):

1. Signs cannot impair motorist's clear view of traffic or government signs. All signs are subject to Section 102.5, BCZR.
2. Signs cannot imitate or resemble government signs, except for private traffic control and notice signs.
3. Signs cannot be placed in or project into or above street right of way or governmental property.
4. Sign or framework cannot obstruct window or opening for light and air or access to building, fire hydrant, or stand pipe.
5. Vehicle cannot be parked for the purpose of displaying an attached sign.
6. Except for flags exempted, flags, pennants, ribbons, streamers, tethered balloons, laser projections, and similar objects are prohibited.
7. Portable signs are prohibited, except for A-frame and sandwich board signs issued a use permit in B.M. - C.T. zones.
8. There can be no display or simulation of moving parts or message, except for an outdoor advertising sign with tri-vision, a changeable copy sign, or a thermometer, barometer, weather vane, barber pole, or clock.
9. No sign may emit sound

450.6.B.3 Changeable copy signs must operate at a constant intensity and not give the appearance of movement by flashing, blinking, strobing, scrolling, oscillating, or alternating lights.

Work Description (including number of signs, special conditions, materials, locations and size):

Install 2 CVS Pharmacy (heart logo) channel letters (illuminated)
@ 3.54' x 26.46' @ 93.67 sq ft each
Install 1 Operating Hours Plaque @ 1.54 x 1.21 @ 1.86 sq ft CORNER LOT ☒
(non-illuminated)

OWNER/AGENT CERTIFICATION

I solemnly affirm under the penalties of perjury and upon personal knowledge that the contents of the above are true and further agree to locate the proposed sign such that it will not violate Baltimore County laws and regulations.

Signature _____

Date _____

Print/Type Name Betsy Marino

☐ Require Planning Signature _____

Date _____

Copies: White-Office; Yellow- Applicant (keep this Copy for your permanent records)

REV 03/12

Authority under Section 500.4, BCZR **PAI Approval (SIGN ONLY)**

Signature _____

Initials SSS

Date 7/29/19

**Permits, Approvals & Inspections**111 W. Chesapeake Avenue
Towson, MD 21204Report Generated On:
7/29/2019**Permit Processing Commerical Permit & Development Report**

Page 1 of 1

Property Information

Tax Account Number: 1600005437

Plat Ref: 007:173

Election District: 13

Owner Name(s): MARYLAND CVS PHARMACY LLC

PDM #: 13-0232

Address: C/O CVS HEALTH ONE CVS DRIVE
WOONSOCKET, RI 2895

Zoning District(s): BL

Premise Address: 4709 WILKENS AVE

Elevation Range: 224ft - 230ft

Affected Overlays	Instructions: Begin review process with Zoning Review, Room 111.	New Com Bldg.	Interior Alts.	Add / Ext. Alts.	Piers/Pilings	Grading/SW	Tanks	Ret. Walls/Bulk	Razing	Chg. of Occup.	Tower Antenna	Signs	Elect. & Plumb	Agency Acknowledgment
Contact Agency	Potential Overlay Issues													Initial & Date
DEPS-Sed. Control Jefferson Building 4th Floor Phone: 410-887-3226	Note: All Razing Permits must be sent to Sediment Control for review.													
PAI-Public Services County Office Building Room 119 Phone: 410-887-3751	Note: All permits for Grading, New Buildings & Building Additions must be sent to Public Services.													
Zoning Review County Office Building Room 111 Phone: 410-887-3391	Zoning Cases: 1965-0276-A; 2017-0218-SPHA	X		X	X	X	X			X	X	X		



Permits, Approvals & Inspections

111 W. Chesapeake Avenue
Towson, MD 21204

Report Generated On:
7/29/2019

Permit Processing Commerical Permit & Development Report

Page 1 of 1

Property Information

Tax Account Number: 1600005437

Plat Ref: 007:173

Election District: 13

Owner Name(s): MARYLAND CVS PHARMACY LLC

PDM #: 13-0232


Address: C/O CVS HEALTH ONE CVS DRIVE
WOONSOCKET,RI 2895

Zoning District(s): BL

Premise Address: 4709 WILKENS AVE

Elevation Range: 224ft - 230ft

Affected Overlays	Instructions: Begin review process with Zoning Review, Room 111.	New Com Bldg.	Interior Alts.	Add / Ext. Alts.	Piers/Pilings	Grading/SW	Tanks	Ret.Walls/Bulk	Razing	Chg. of Occup.	Tower Antenna	Signs	Elect. & Plumb	Agency Acknowledgment
	Potential Overlay Issues													
Contact Agency	Growth Tier 1: Served by public sewer and inside URDL													Initial & Date
DEPS-Sed. Control Jefferson Building 4th Floor Phone: 410-887-3226	Note: All Razing Permits must be sent to Sediment Control for review.													
PAI-Public Services County Office Building Room 119 Phone: 410-887-3751	Note: All permits for Grading, New Buildings & Building Additions must be sent to Public Services.													
Zoning Review County Office Building Room 111 Phone: 410-887-3391	Zoning Cases: 1965-0276-A; 2017-0218-SPHA	X		X	X	X	X			X	X	X		

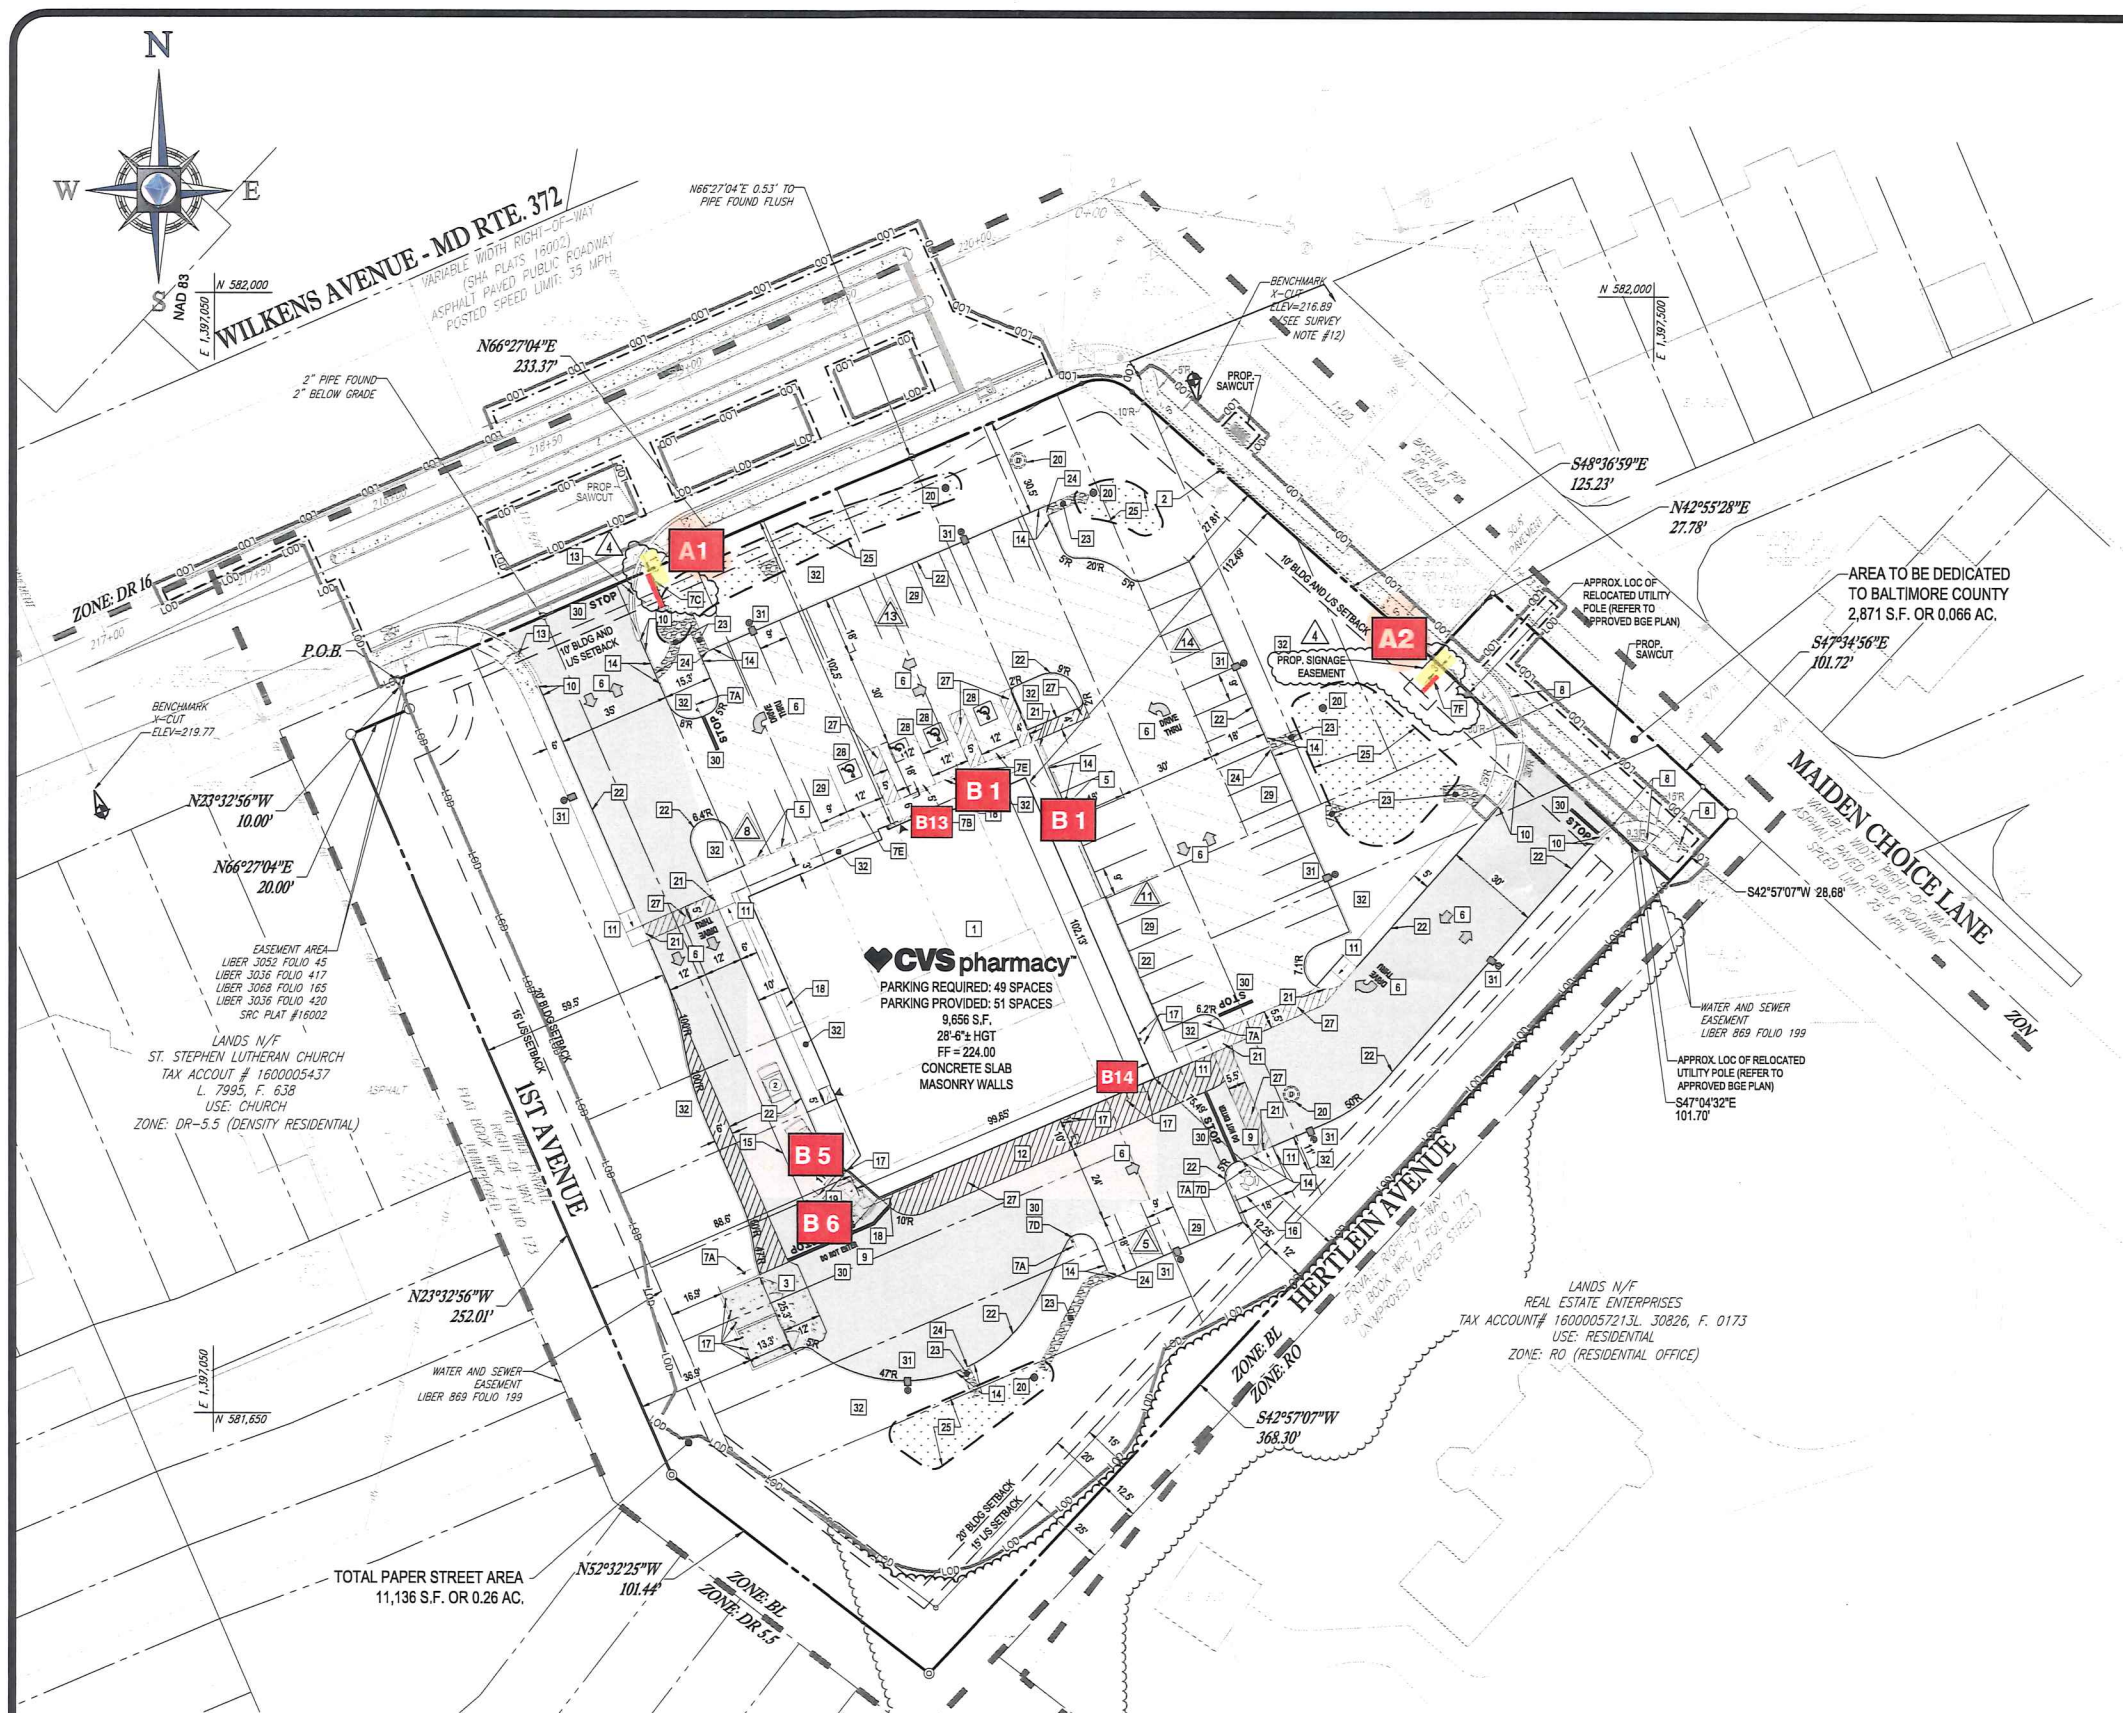

FREESTANDING SIGNS

- A1** — Pylon - Single Pole 24' OAH / Qty 1
- A2** — Custom Monument (Shared) / 12' OAH / Qty 1

WALL SIGNS

- B1** — ♥CVSpharmacy - 33" - Qty 2
- B13** — Operating Hours - Qty 1
18 9/16" x 14 1/2"

DIRECTIONAL SIGNS

- B5** — drive-thru pharmacy - 20½" x 10' 4" Cabinet Illuminated - Qty 1
4" x 30" Clearance Plaque (Clear Acrylic) - Qty 1
- B6** — drive-thru pharmacy - 20½" x 10' 4" Cabinet Illuminated - Qty 1
- B14** — Receiving Door Sign - Qty 1
18" x 24"

SCALE: 1" = 60'



6611 IRON PLACE
SPRINGFIELD, VA. 22151
PHONE: (703) 354-3000
FAX: (703) 354-5810

CUSTOMER'S NAME **#10588**

♥CVS pharmacy

LOCATION
**4701 Wilkens Avenue
Arbutus, MD 21228**

DRAWING # **12-18-375** DATE **03/01/19**

SALESPERSON
Rick Pepper


This design is the property of Service Neon Signs. Unauthorized use in whole or in part is prohibited; violators will be prosecuted in the fullest extent of the law.

This sign is intended to be installed in accordance with the requirements of Article 800 of the National Electrical Code and/or other applicable local codes. This includes proper grounding and bonding of the sign.

APPROVALS	
CUSTOMER	_____
SALES	_____
PRODUCTION	_____
INSTALLATION	_____

A 1

Qty. - 1

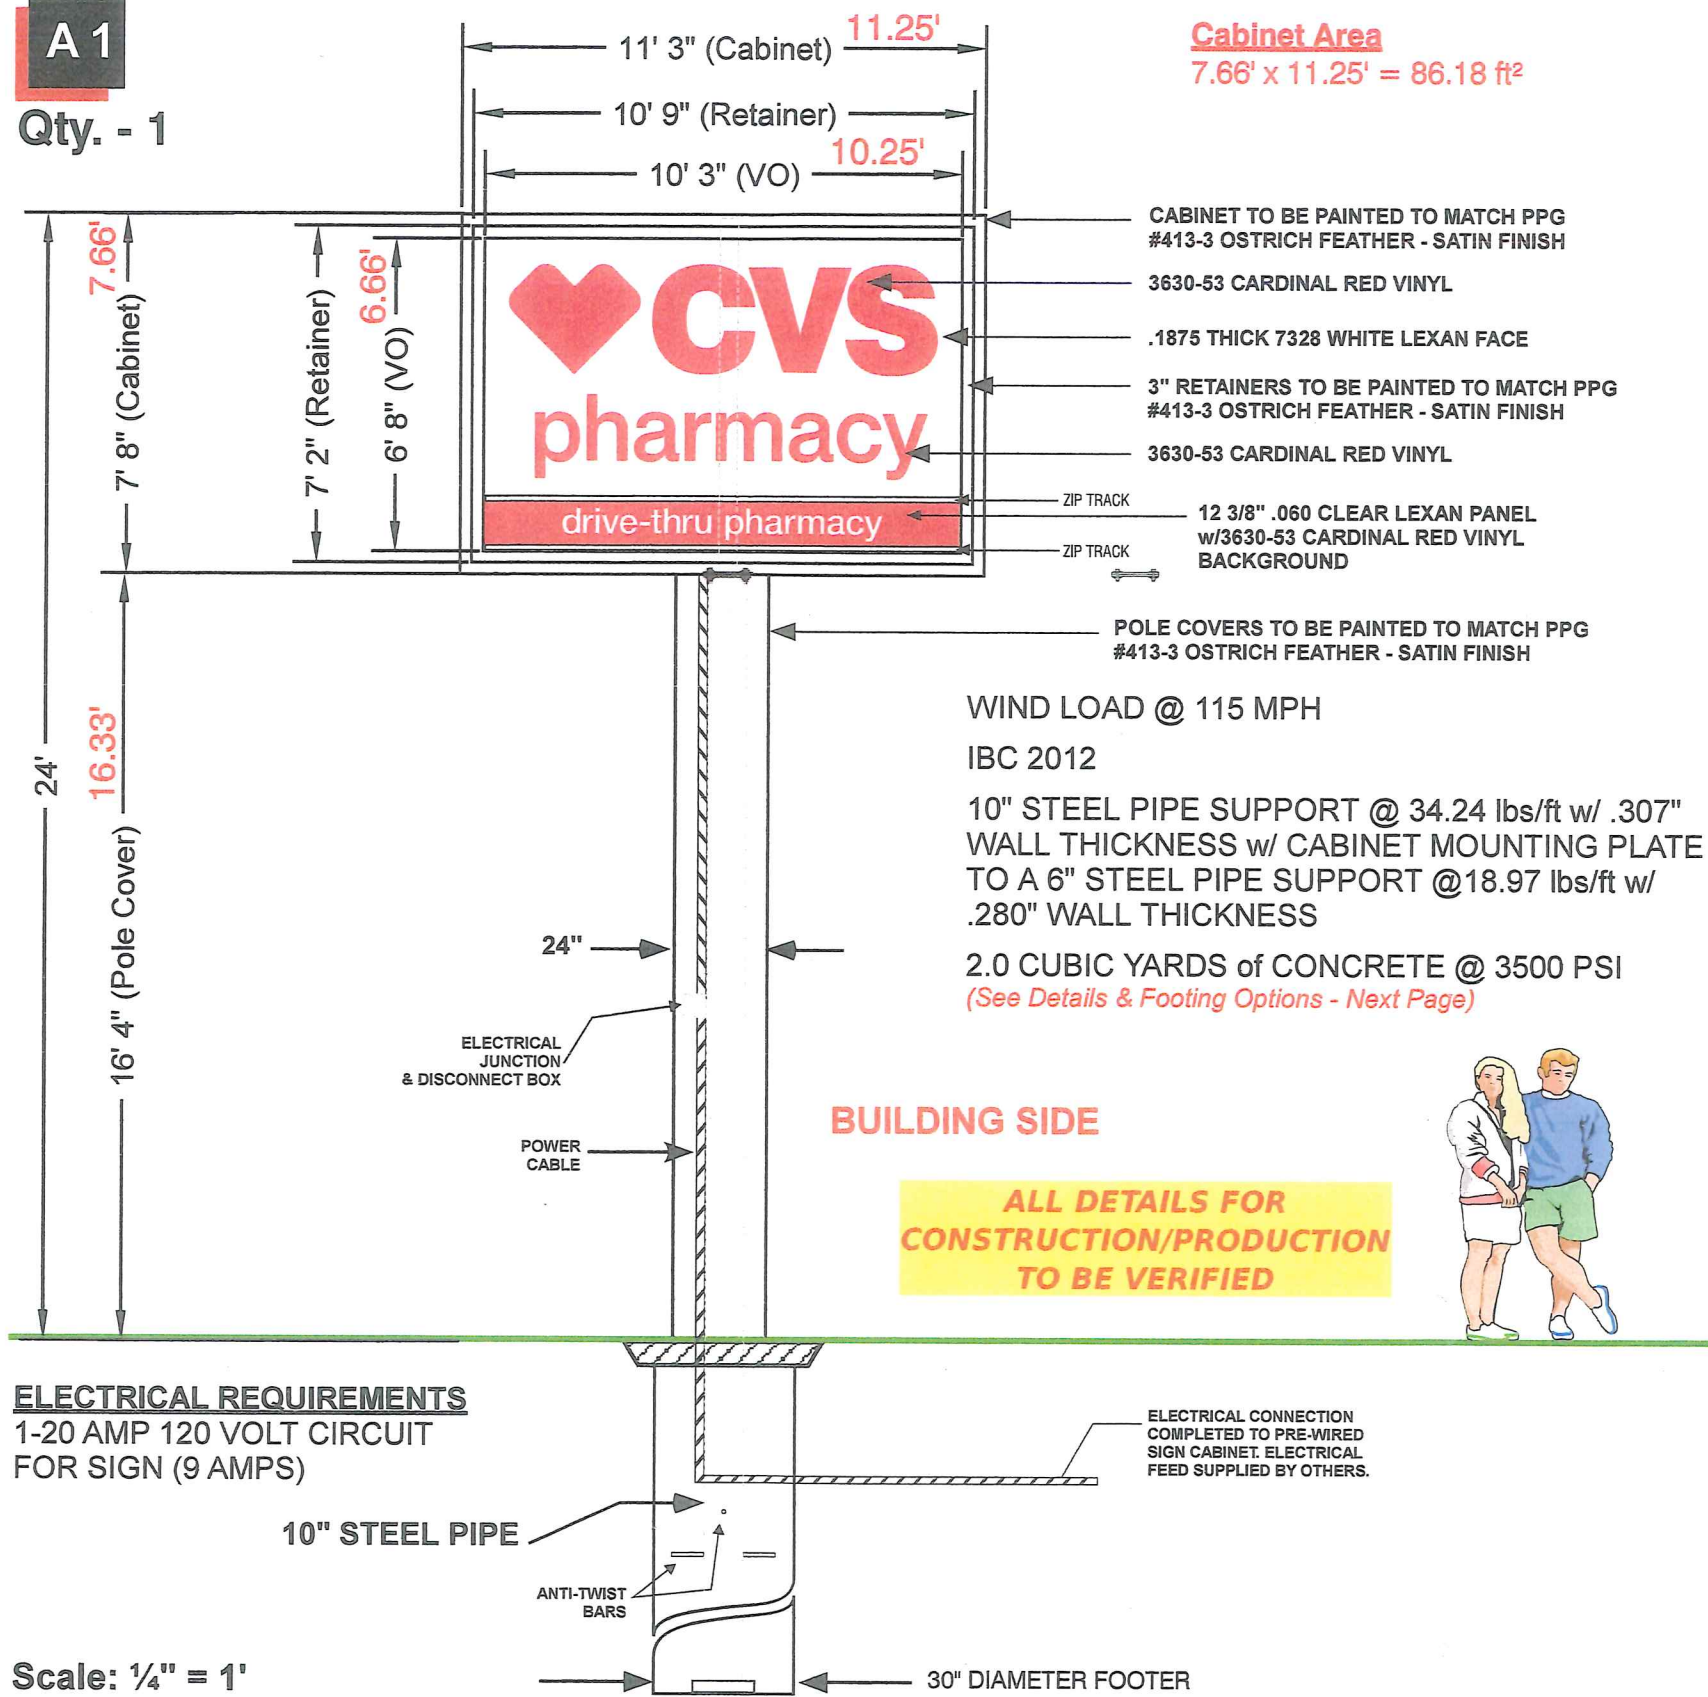**MANUFACTURE AND INSTALL:**

ONE (1) 24'-0" x 11'-3" x 1'-6" (Deep)
DOUBLE FACED INTERNALLY ILLUMINATED
FREESTANDING SIGN CABINET w/ I. D. HEADER

MESSAGE:

CVS
pharmacy
drive-thru pharmacy

MATERIAL:

CABINETS CONSTRUCTED OF ANGLE FRAME COVERED WITH .090 ALUMINUM SHEET, SPRAYED TO MATCH PPG #413-3 OSTRICH FEATHER - SATIN FINISH ON ALL EXTERIOR SURFACES AND WHITE ENAMEL ON ALL INTERNAL SURFACES.

LIGHTING:

FROM AN INTERNAL SOURCE OF GE TETRA MAX POWER STRIPS, POWERED BY GEPS24-100U POWER SUPPLIES. ALL WIRING AND LIGHTING COMPONENTS WILL BE U.L. APPROVED AND A U.L. LABEL WILL BE ATTACHED TO THE EXTERIOR OF THE CABINET.

FACES:

CONSTRUCTED OF 3/16" #7328 WHITE ACRYLIC SHEET WITH 3" RETAINERS & APPLIED #230-53 TRANSLUCENT CARDINAL RED COPY.

INSTALLATION:

SIGN CABINET MOUNTED ON ONE (1) 10" STEEL PIPE SUPPORT & (1) 6" STEEL PIPE ATTACHED TO LARGER PIPE VIA MATCHING MOUNTING PLATES TO SUPPORT UPPER CABINET STRUCTURE.
10" STEEL PIPE SUPPORT @ 34.24 lbs/ft w/ .307" WALL THICKNESS (SPRAYED WHITE) SET IN CONCRETE FOOTER AS SHOWN. **6" STEEL PIPE SUPPORT @ 18.97 lbs/ft w/ .280" WALL THICKNESS** (SPRAYED WHITE) ATTACHED BY MOUNTING PLATE TO 10" SUPPORT PIPE.

ELECTRICAL:

TO SIGN LOCATION BY OTHERS.

ELECTRICAL REQUIREMENTS
1-20 AMP 120 VOLT CIRCUIT
FOR SIGN (9 AMPS)

Scale: 1/4" = 1'

**SERVICE
NEON
SIGNS
INC**

6611 IRON PLACE
SPRINGFIELD, VA.
22151
PHONE: (703) 354-3000
FAX: (703) 354-5810

CUSTOMERS NAME

#10588

CVS pharmacy

LOCATION

4701 Wilkens Avenue
Arbutus, MD 21228

DRAWING #

12-18-375

DATE

02/19/19

SALESPERSON

Rick Pepper

This design is the property of Service Neon Signs. Unauthorized use in whole or in part is prohibited, violators will be prosecuted in the fullest extent of the law.

This sign is intended to be installed in accordance with the requirements of Article 600 of the National Electrical Code and/or other applicable local codes. This includes proper grounding and bonding of the sign.

APPROVALS

CUSTOMER _____
SALES _____
PRODUCTION _____
INSTALLATION _____

A 2 Custom Monument - 12' OAH

Qty: 1

Upper Cabinet Area
4.65' x 6.67' = 31.02 ft²

Lower Cabinet Area
6' x 6.67' = 40.02 ft²

WIND LOAD @ 115 MPH
IBC 2012

Upper Sign Face

3/16" #7328 White Acrylic Faces
#3630-53 Cardinal Red
Translucent Vinyl Copy

Lower Sign Face


3/16" #7328 White Acrylic Faces
#3630-76 Holly Green
Translucent Vinyl Copy



REVERSE FACE

6" STEEL PIPE @ 28.57 lbs/ft
w/ .432" WALL THICKNESS
1.0 CUBIC YARD of
CONCRETE @ 3500 PSI

SCALE: 1/2" = 1'

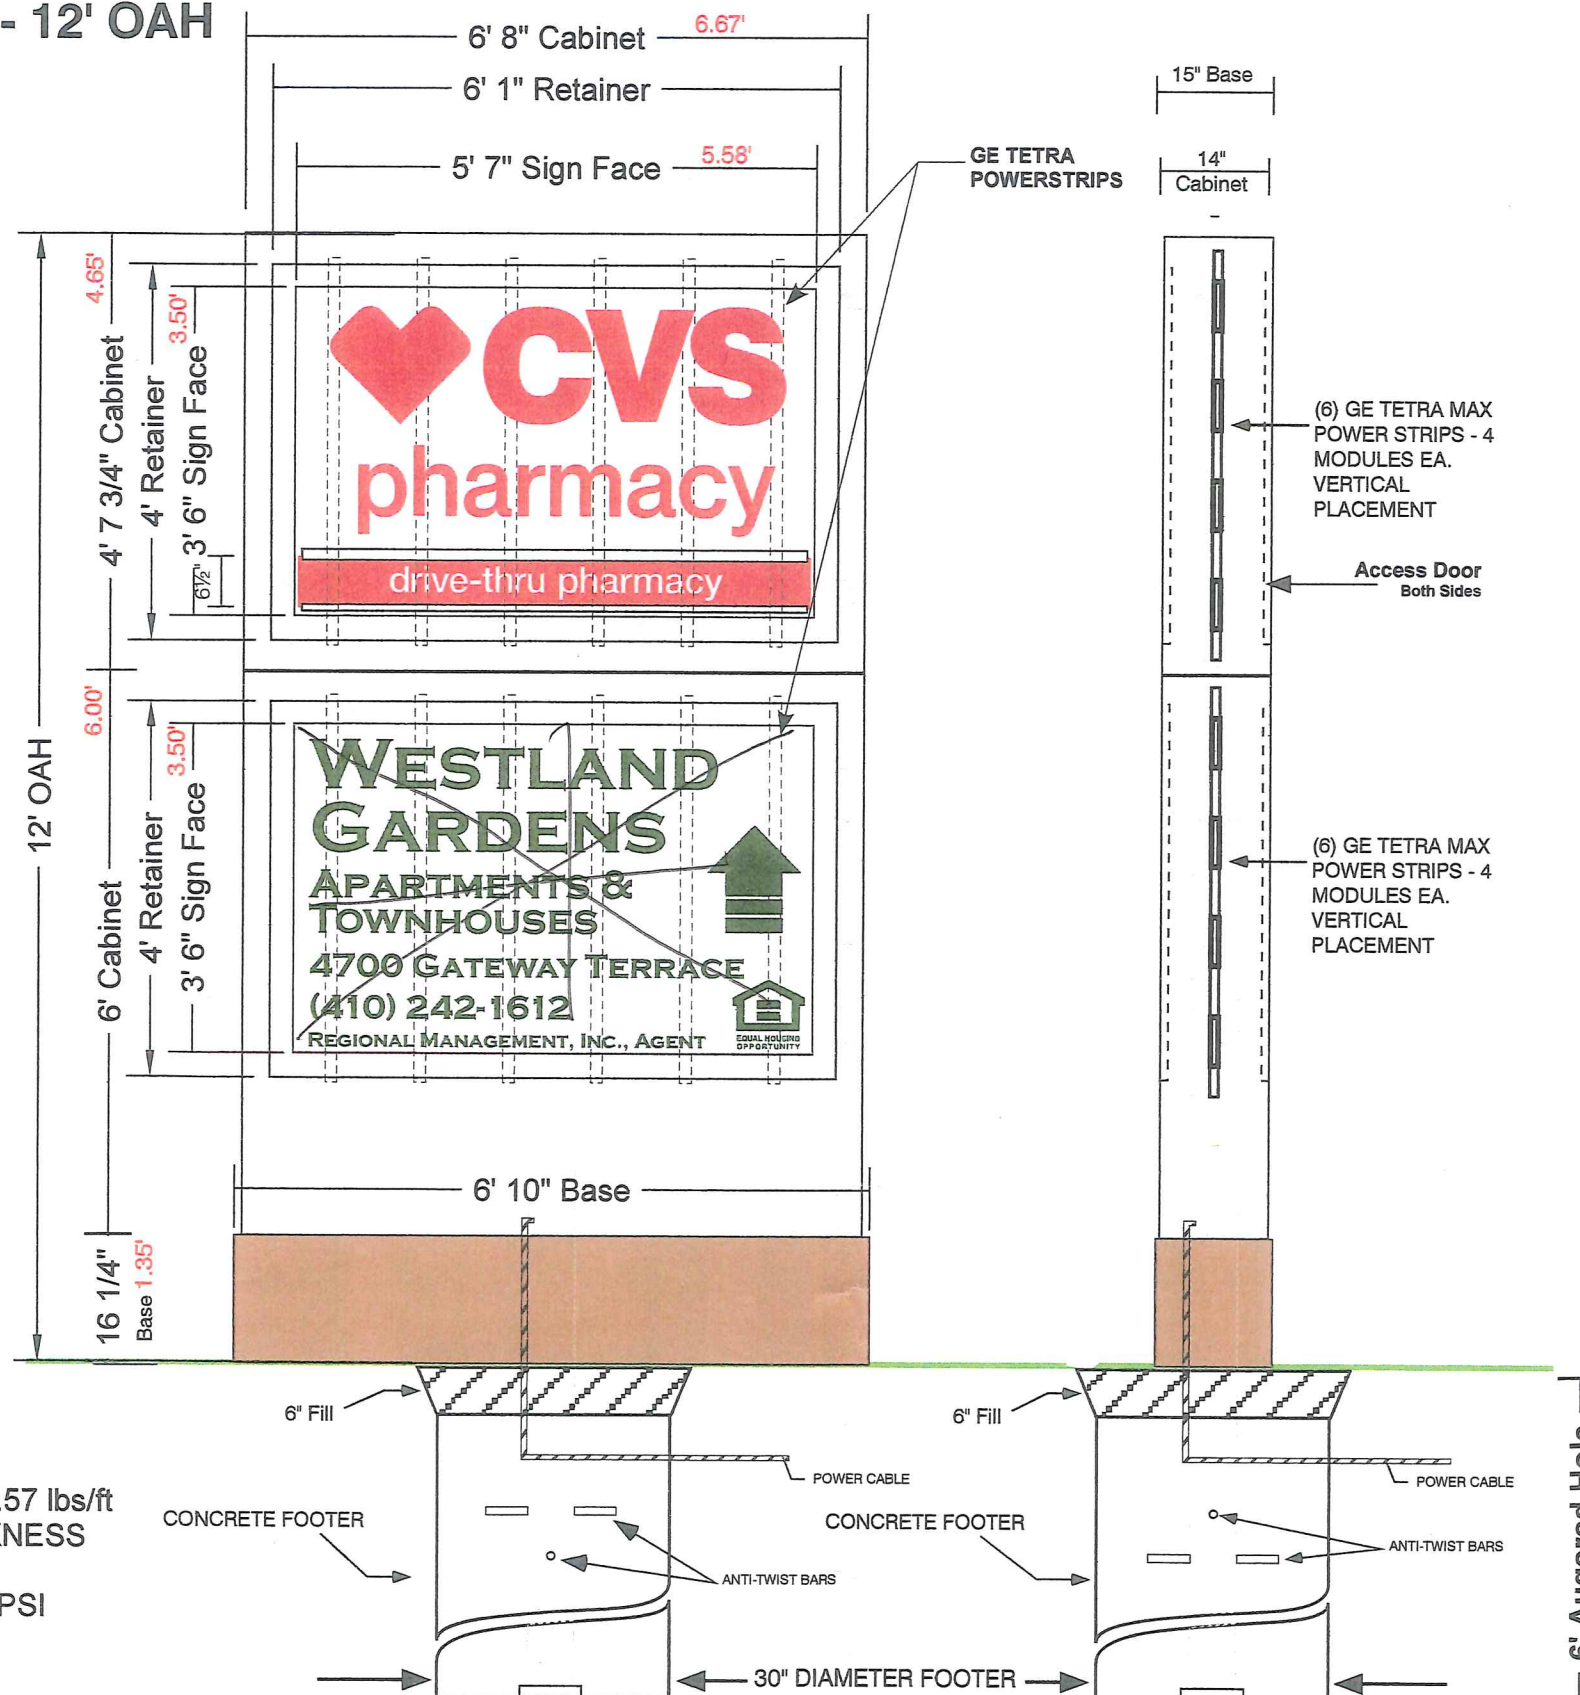

MANUFACTURE AND INSTALL:

ONE (1) 12" x 6' - 8" x 1'-3" (Deep)
DOUBLE FACED INTERNALLY ILLUMINATED
FREESTANDING SIGN CABINET

MESSAGES: AS SHOWN

MATERIAL:

CABINETS CONSTRUCTED OF ALUMINUM ANGLE
FRAME COVERED WITH .090 ALUMINUM SHEET,
SPRAYED TO MATCH PPG #413-3 Ostrich Feather -
To Match EX-2 (SATIN FINISH) ON EXTERIOR
CABINET SURFACES, PPG #420-6 Caravel Brown -
To Match EX-3 (SATIN FINISH) AND WHITE ENAMEL
ON ALL INTERNAL SURFACES.

LIGHTING:

FROM AN INTERNAL SOURCE OF GE TETRA
MAX POWER STRIPS, POWERED BY GEPS24-100U
POWER SUPPLIES. ALL WIRING AND LIGHTING
COMPONENTS WILL BE U.L. APPROVED AND A U.L.
LABEL WILL BE ATTACHED TO THE EXTERIOR
OF THE CABINET.

FACES:

UPPER CABINET

CONSTRUCTED OF 3/16" #7328 WHITE ACRYLIC
SHEET WITH 3" RETAINERS & APPLIED #3630-53
TRANSLUCENT CARDINAL RED COPY.

LOWER CABINET

CONSTRUCTED OF 3/16" #7328 WHITE ACRYLIC
SHEET WITH 3" RETAINERS & APPLIED #3630-76
TRANSLUCENT HOLLY GREEN COPY.

INSTALLATION:

SIGN CABINET MOUNTED ON ONE (1) 6" STEEL
PIPE SUPPORT @ 28.57 lbs/ft w/ .432" WALL
THICKNESS (SPRAYED WHITE) & SET IN
CONCRETE FOOTER AS SHOWN.

ELECTRICAL:

TO SIGN LOCATION BY OTHERS.

**SERVICE
NEON
SIGNS
INC**

6611 IRON PLACE
SPRINGFIELD, VA.
22151
PHONE: (703) 354-3000
FAX: (703) 354-5810

CUSTOMERS NAME

#10588

CVS pharmacy

LOCATION

4701 Wilkens Avenue
Arbutus, MD 21228

DRAWING #

12-18-375

DATE

01/17/19

SALESPERSON

Rick Pepper


This design is the property of Service Neon
Signs. Unauthorized use in whole or in part
is prohibited, violators will be prosecuted
in the fullest extent of the law.
This sign is intended to be installed in accordance
with the requirements of Article 600 of the National
Electrical Code and/or other applicable local codes.
This includes proper grounding and bonding of the sign.

APPROVALS

CUSTOMER _____
SALES _____
PRODUCTION _____
INSTALLATION _____

B1 Main ID Sign

Qty: 2
93.67 ft²

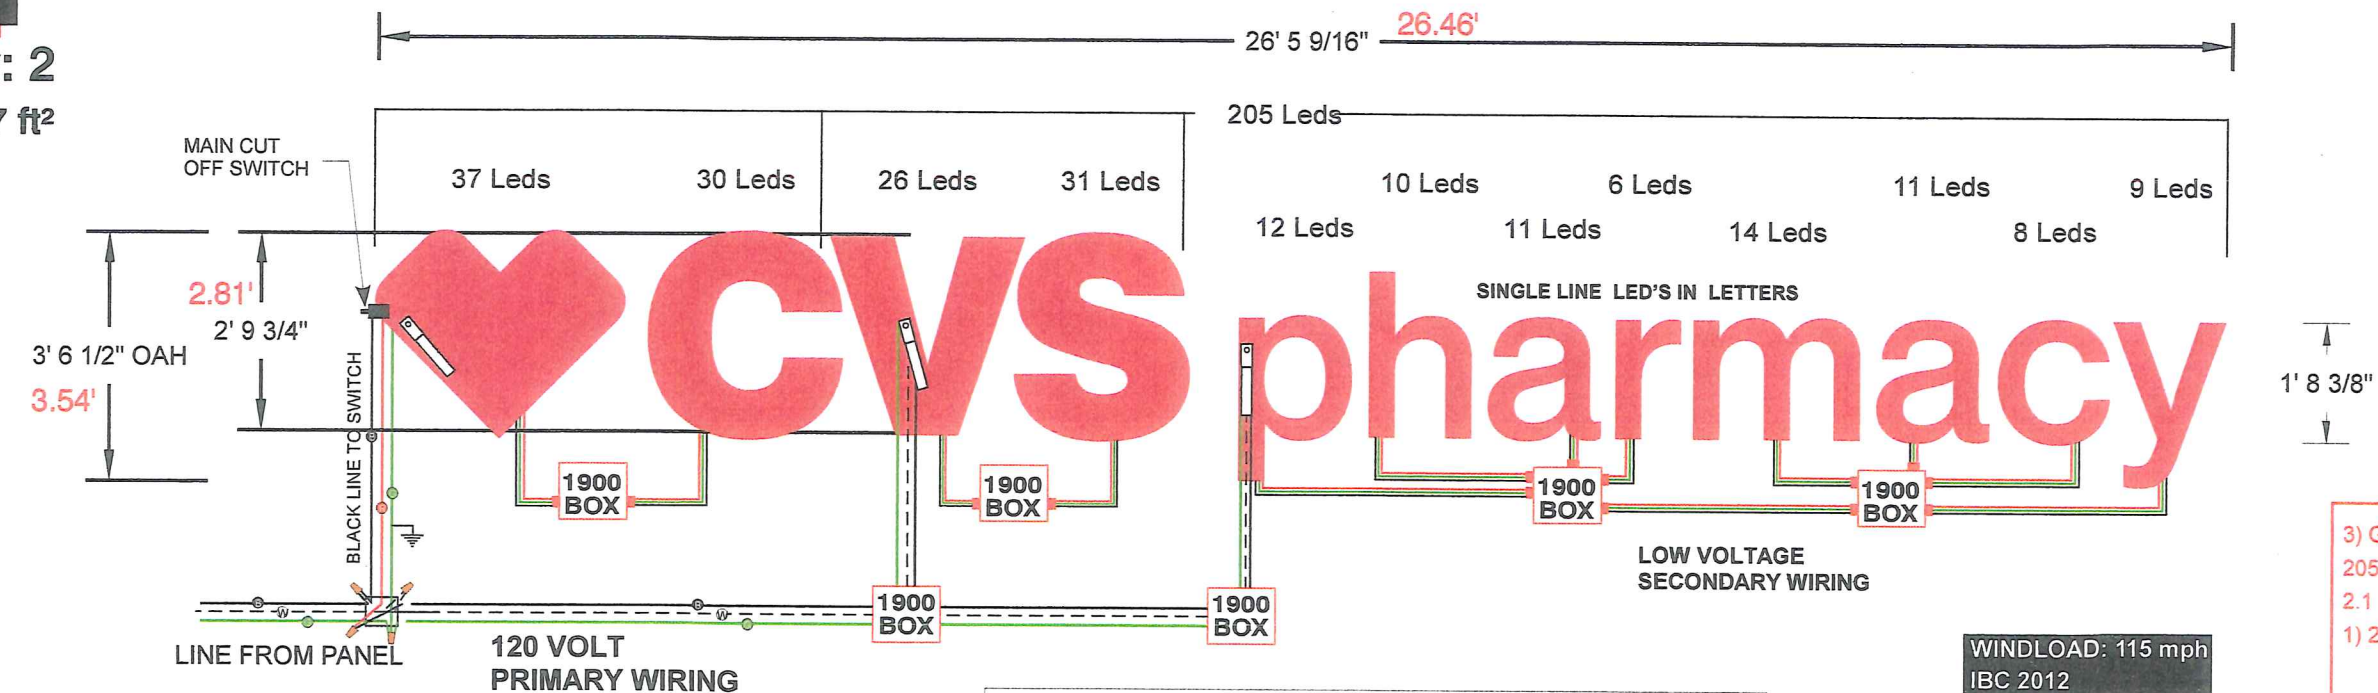

THIS SIGN IS INTENDED TO BE INSTALLED IN ACCORDANCE WITH THE REQUIREMENTS OF ARTICLE 600 OF THE NATIONAL ELECTRICAL CODE AND/OR OTHER APPLICABLE LOCAL CODES. THIS INCLUDES PROPER GROUNDING AND BONDING OF THE SIGN.

3) GEPS12-60 power supplies
205 total red tetra max (GEMXRD-W1) LEDs
2.1 amps (Primary)
1) 20 amp 120 volts circuit required
per set of letters

33" set of self-contained channel letters (Leds)

SCALE: 3/8" = 1'

Electrical Cable Installed: E67179 2/C 18 AWG 105c (UL) PLTC

B = BLACK IS SWITCH FEED
R = RED IS SWITCH LOAD TO ALL LETTERS
G = GREEN IS GROUND
W = WHITE IS NEUTRAL

SIGN B-1.
MANUFACTURE & CO-ORDINATE INSTALLATION OF TWO (2) SETS OF 33" CHANNEL LETTERS WITH RED LED INTERNAL LIGHTING AS SHOWN

MESSAGE: ♥CVSpharmacy


MATERIALS:
CHANNELS CONSTRUCTED OF PRECOATED WHITE/ HUNTER RED ALUMINUM WITH 5" DEEP .040 CHANNEL RETURNS & WHITE/ BRONZE .063 BACKS

FACES OF 3/16" RED #2793 ACRYLIC BANDED WITH ONE INCH WIDE TRUE RED TRIM-CAP MOLDING.


LIGHTING FROM AN INTERNAL SOURCE OF RED GE TETRA MAX LED MODULES #GEMXRD-W1, POWERED BY GE POWER SUPPLIES #GEPS12-60U-NA (12VDC/60W) @ .7 AMP PER UNIT - 120 VOLT PRIMARY
NOTE: ALL WIRING & MATERIALS USED WILL U.L. APPROVED WITH EACH LETTER LABELED

ELECTRICAL TO BE BROUGHT TO SIGN LOCATION BY OTHERS. ONE 20 AMP 120 VOLT CIRCUIT REQUIRED FOR EACH SIGN. TOTAL LOAD 1.2 AMPS (PRIMARY)

MOUNTING OF LETTERS WITH PROVIDED 3/8" x 12" LONG ALUMINUM ALL-THREAD INTO THREADED RIV-NUTS ON BACK OF LETTERS. ALUMINUM BACK-UP PLATES (4" x 4" X 1/8" THICK) w/ WASHER-LOCK WASHER-NUT PROVIDED AS SHOWN. ALL PENETRATIONS SEALED WITH MASTERSEAL.

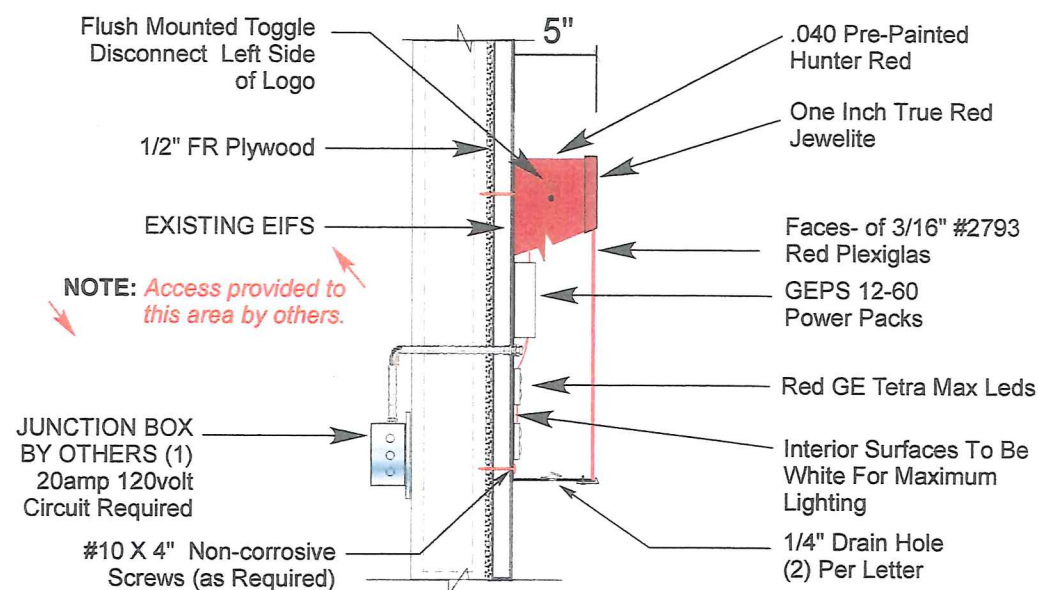

TYPICAL SECTION

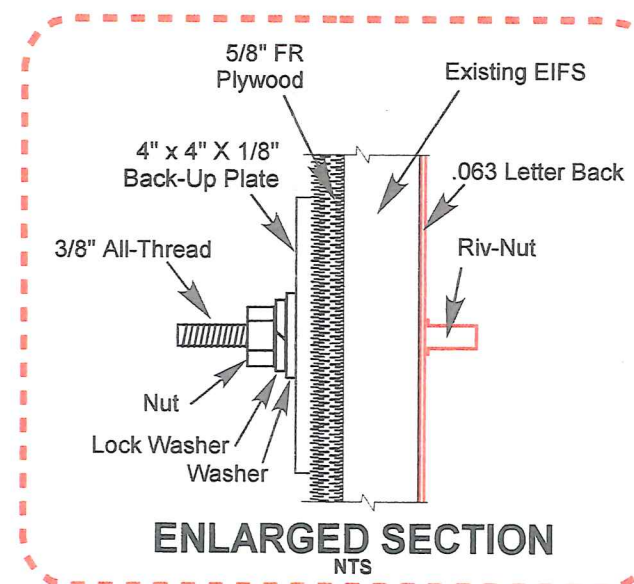

**SERVICE
NEON
SIGNS
INC**

6611 IRON PLACE
SPRINGFIELD, VA. 22151
PHONE: (703) 354-3000
FAX: (703) 354-5810

CUSTOMERS NAME

#10588

♥CVS pharmacy

LOCATION

4701 Wilkens Avenue
Arbutus, MD 21228

DRAWING #

12-18-375

DATE

02/19/19

SALESPERSON



Rick Pepper

This design is the property of Service Neon Signs. Unauthorized use in whole or in part is prohibited, violators will be prosecuted in the fullest extent of the law.

This sign is intended to be installed in accordance with the requirements of Article 600 of the National Electrical Code and/or other applicable local codes. This includes proper grounding and bonding of the sign.

APPROVALS

CUSTOMER _____
SALES _____
PRODUCTION _____
INSTALLATION _____

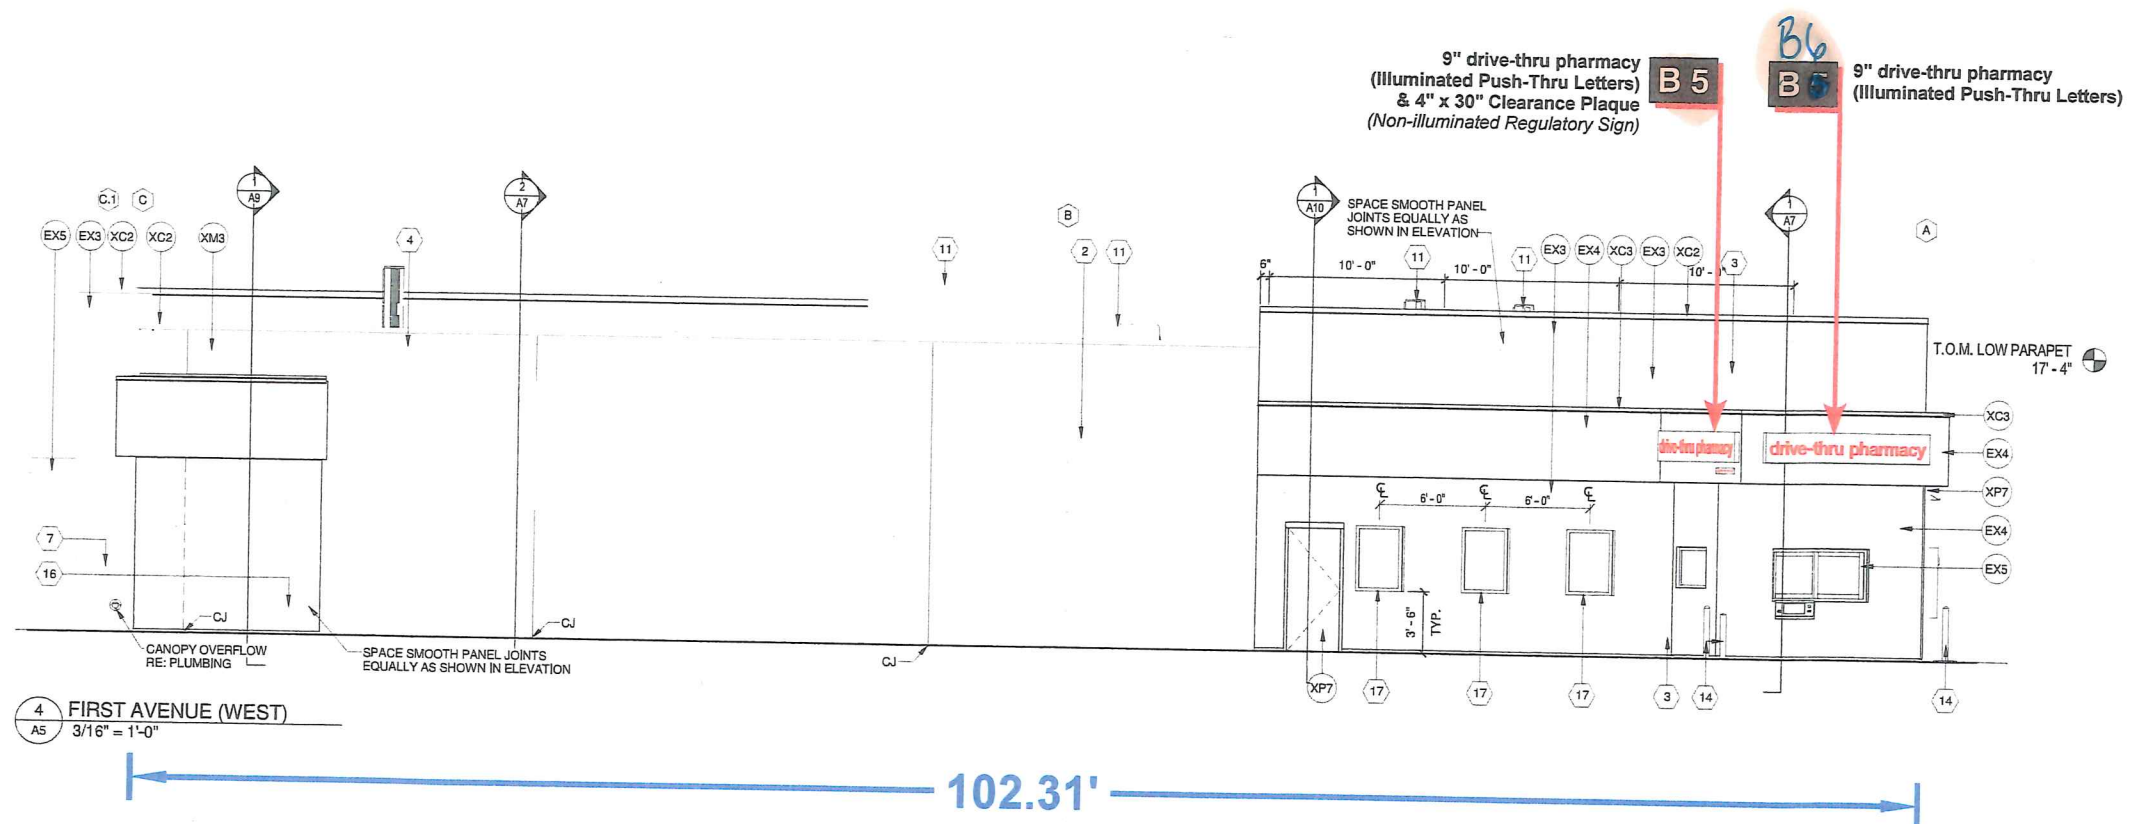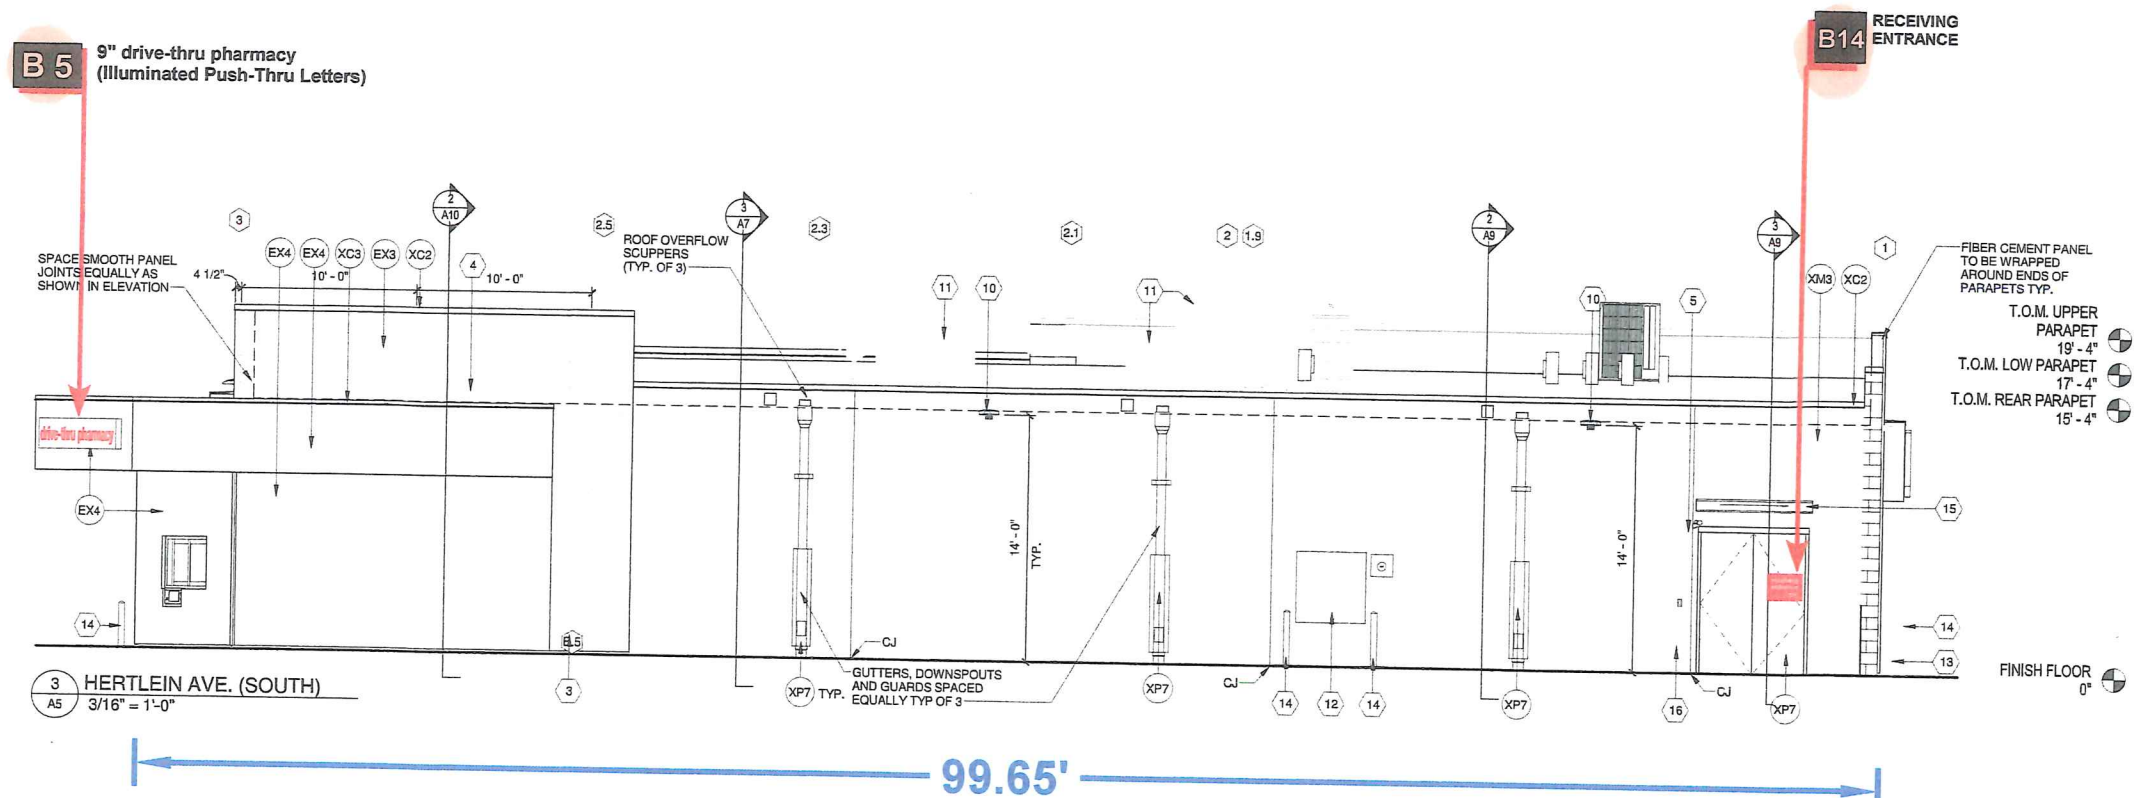

**SERVICE
NEON
SIGNS
INC**

6611 IRON PLACE
SPRINGFIELD, VA. 22151
PHONE: (703) 354-3000
FAX: (703) 354-5810

CUSTOMERS NAME **#10588**

CVS pharmacy

LOCATION
**4701 Wilkens Avenue
Arbutus, MD 21228**

DRAWING # **12-18-375** DATE **03/01/19**

SALESPERSON **Rick Pepper**

This design is the property of Service Neon Signs. Unauthorized use in whole or in part is prohibited, violators will be prosecuted in the fullest extent of the law.


This sign is intended to be installed in accordance with the requirements of Article 600 of the National Electrical Code and/or other applicable local codes. This includes proper grounding and bonding of the sign.

APPROVALS

CUSTOMER _____
SALES _____
PRODUCTION _____
INSTALLATION _____

B5



8.23 ft²

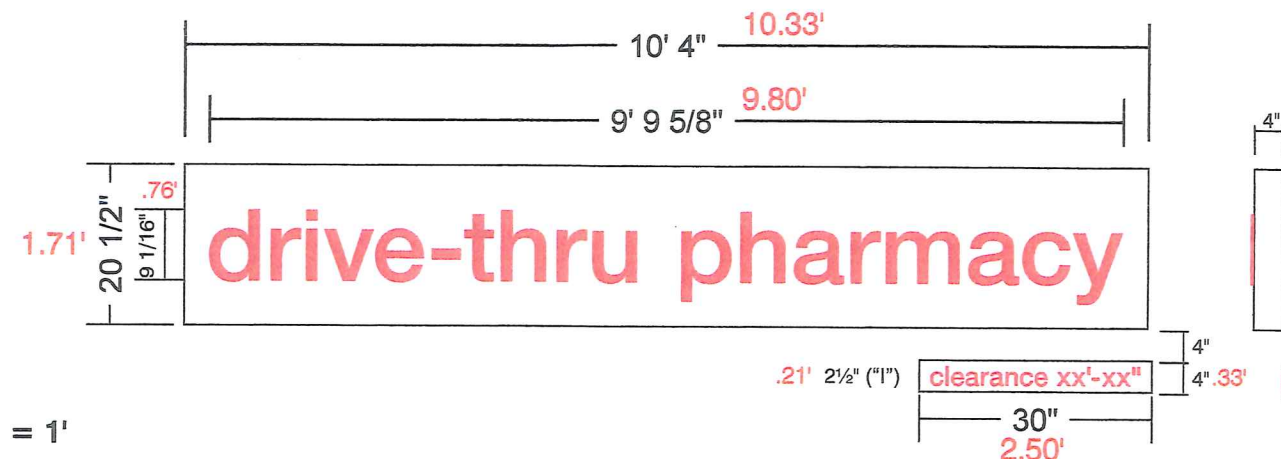


SCALE: 1/2" = 1'

B6

7.40 ft²

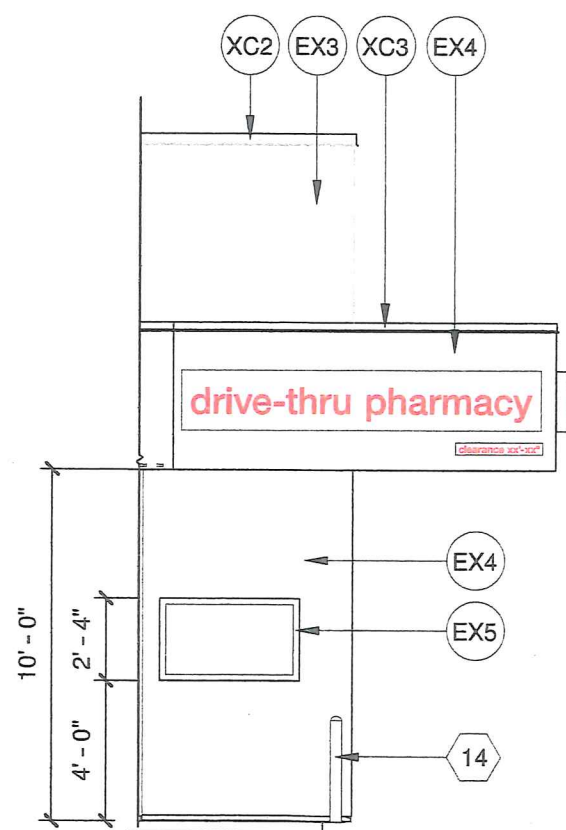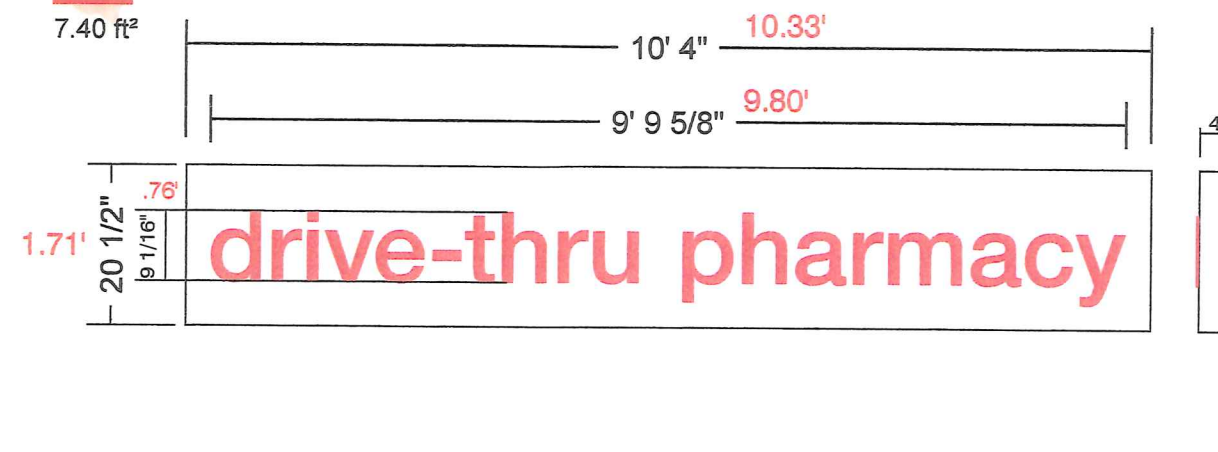


5 drive-thru Entrance Elevation
A5 3/16" = 1'

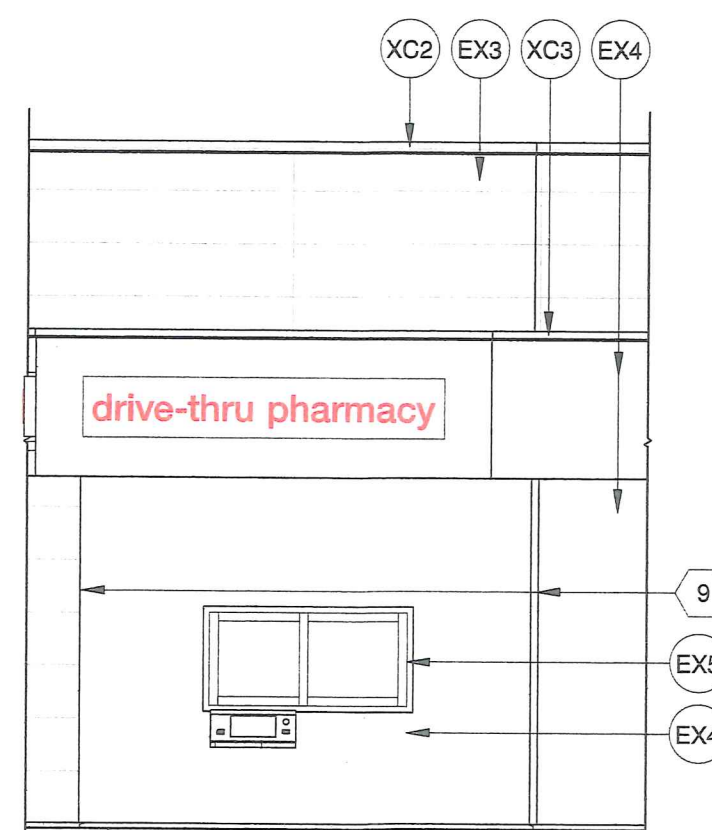

6 drive-thru Elevation
A5 3/16" = 1'

B13 Open Hours Plaque 1.86 ft² SCALE: 3" = 1'-0"
Qty: 1

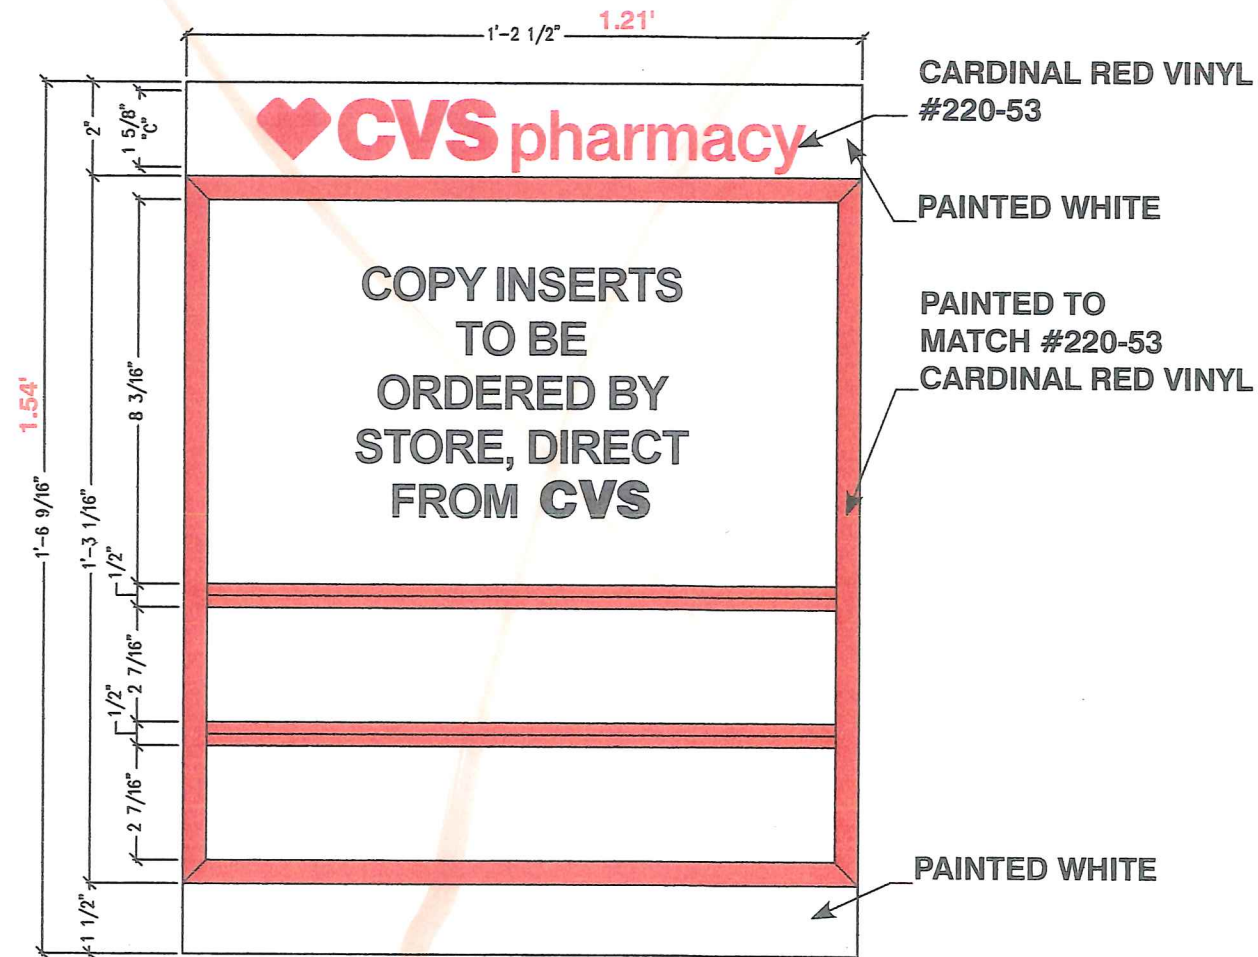

Install the hours plaque on the right side of the entry 60" up from grade to centerline and within 48" of the entrance. Placement moves to the left side if it does not fit on the right side.

B14 Receiving Entrance 3 ft² SCALE: 3" = 1'-0"
Qty: 1



Single Face Non-Illuminated Panel Sign

- ☐ .090 Aluminum painted Hunter Red
- ☐ 3M #7125-10 White Vinyl (all copy)

