### **USE PERMIT**



IT IS ORDERED by the Director of the Department of Permits, Approvals and		
Inspections of Baltimore County, this 4Th day of 700	<u> </u>	
that Wcomans	located at	
(Individual or business name)		
10100 Rcistalstown RZ	should be and the	
(Street address)		
same is hereby granted permission to operate a:	Pichup	
- Lane Grocery PRRUP 2002		
Three		

JA-2024-0001-PP C/25%

Revised 10/17/11

# Wegmans


### Approvals and Inspections Planner's Initials 12

# 10100 REISTERSTOWN ROAD CURBSIDE PICKUP PLANS

## TOWN OF OWINGS MILLS COUNTY OF BALTIMORE STATE OF MARYLAND

### **INDEX OF DRAWINGS**

SHEET NO.	DRAWING TITLE
GC001	COVER SHEET (SHEET 1 OF 3)
CC100	CURBSIDE PICKUP PLAN (SHEET 2 OF 3)
	REDLINED SITE PLAN (SHEET 3 OF 3)

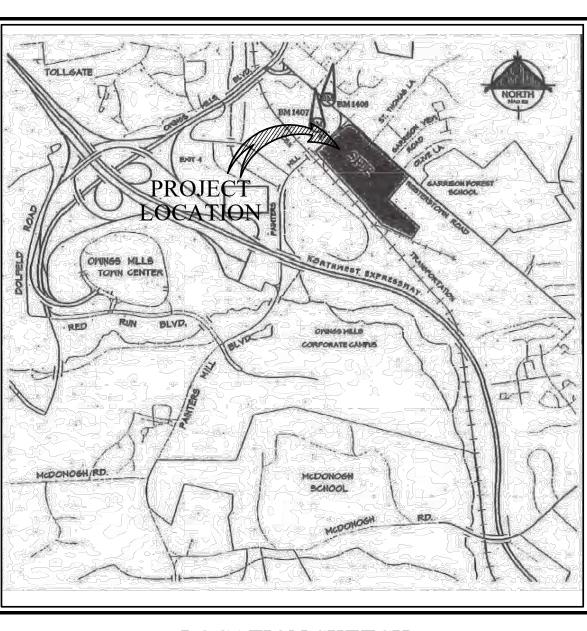

LOCATION SKETCH

### PROJECT TEAM

CIVIL ENGINEER
GARTH WINTERKORN
COSTICH ENGINEERING
217 LAKE AVENUE
ROCHESTER, NEW YORK 14608
PHONE: (585) 458-3020 EXT. 115

PROJECT OWNER
CAITLYN PIATKOWSKI - PROJECT MANAGER
WEGMANS FOOD MARKETS, INC.
SITE DEVELOPMENT & ENGINEERING DEPT.
100 WEGMANS MARKET STREET
ROCHESTER, NEW YORK 14624
PHONE: (585) 720-5707

PREPARED FOR:
WEGMANS FOOD MARKETS, INC.
SITE DEVELOPMENT & ENGINEERING DEPT.
100 WEGMANS MARKET STREET
ROCHESTER, NEW YORK 14624
(585) 464-4600



ENGINEERING

LAND
SURVEYING

• Landscape Architecture

COSTICH 217 LAKE AVENUE ROCHESTER, NY 14608 (585) 458-3020

DATE: SEPTEMBER 09, 2021 REVISED: 06/19/2024





Wegmans FOOD MARKET

10100 REISTERSTOWN ROAD
CURBSIDE PICKUP PLANS
TOWN OF OWINGS MILLS
COUNTY OF BALTIMORE
STATE OF MARYLAND

CONSTRUCTION PLANS PROJECT NO. 1858-125 SHEET NO. GC001

SHEET 1 O

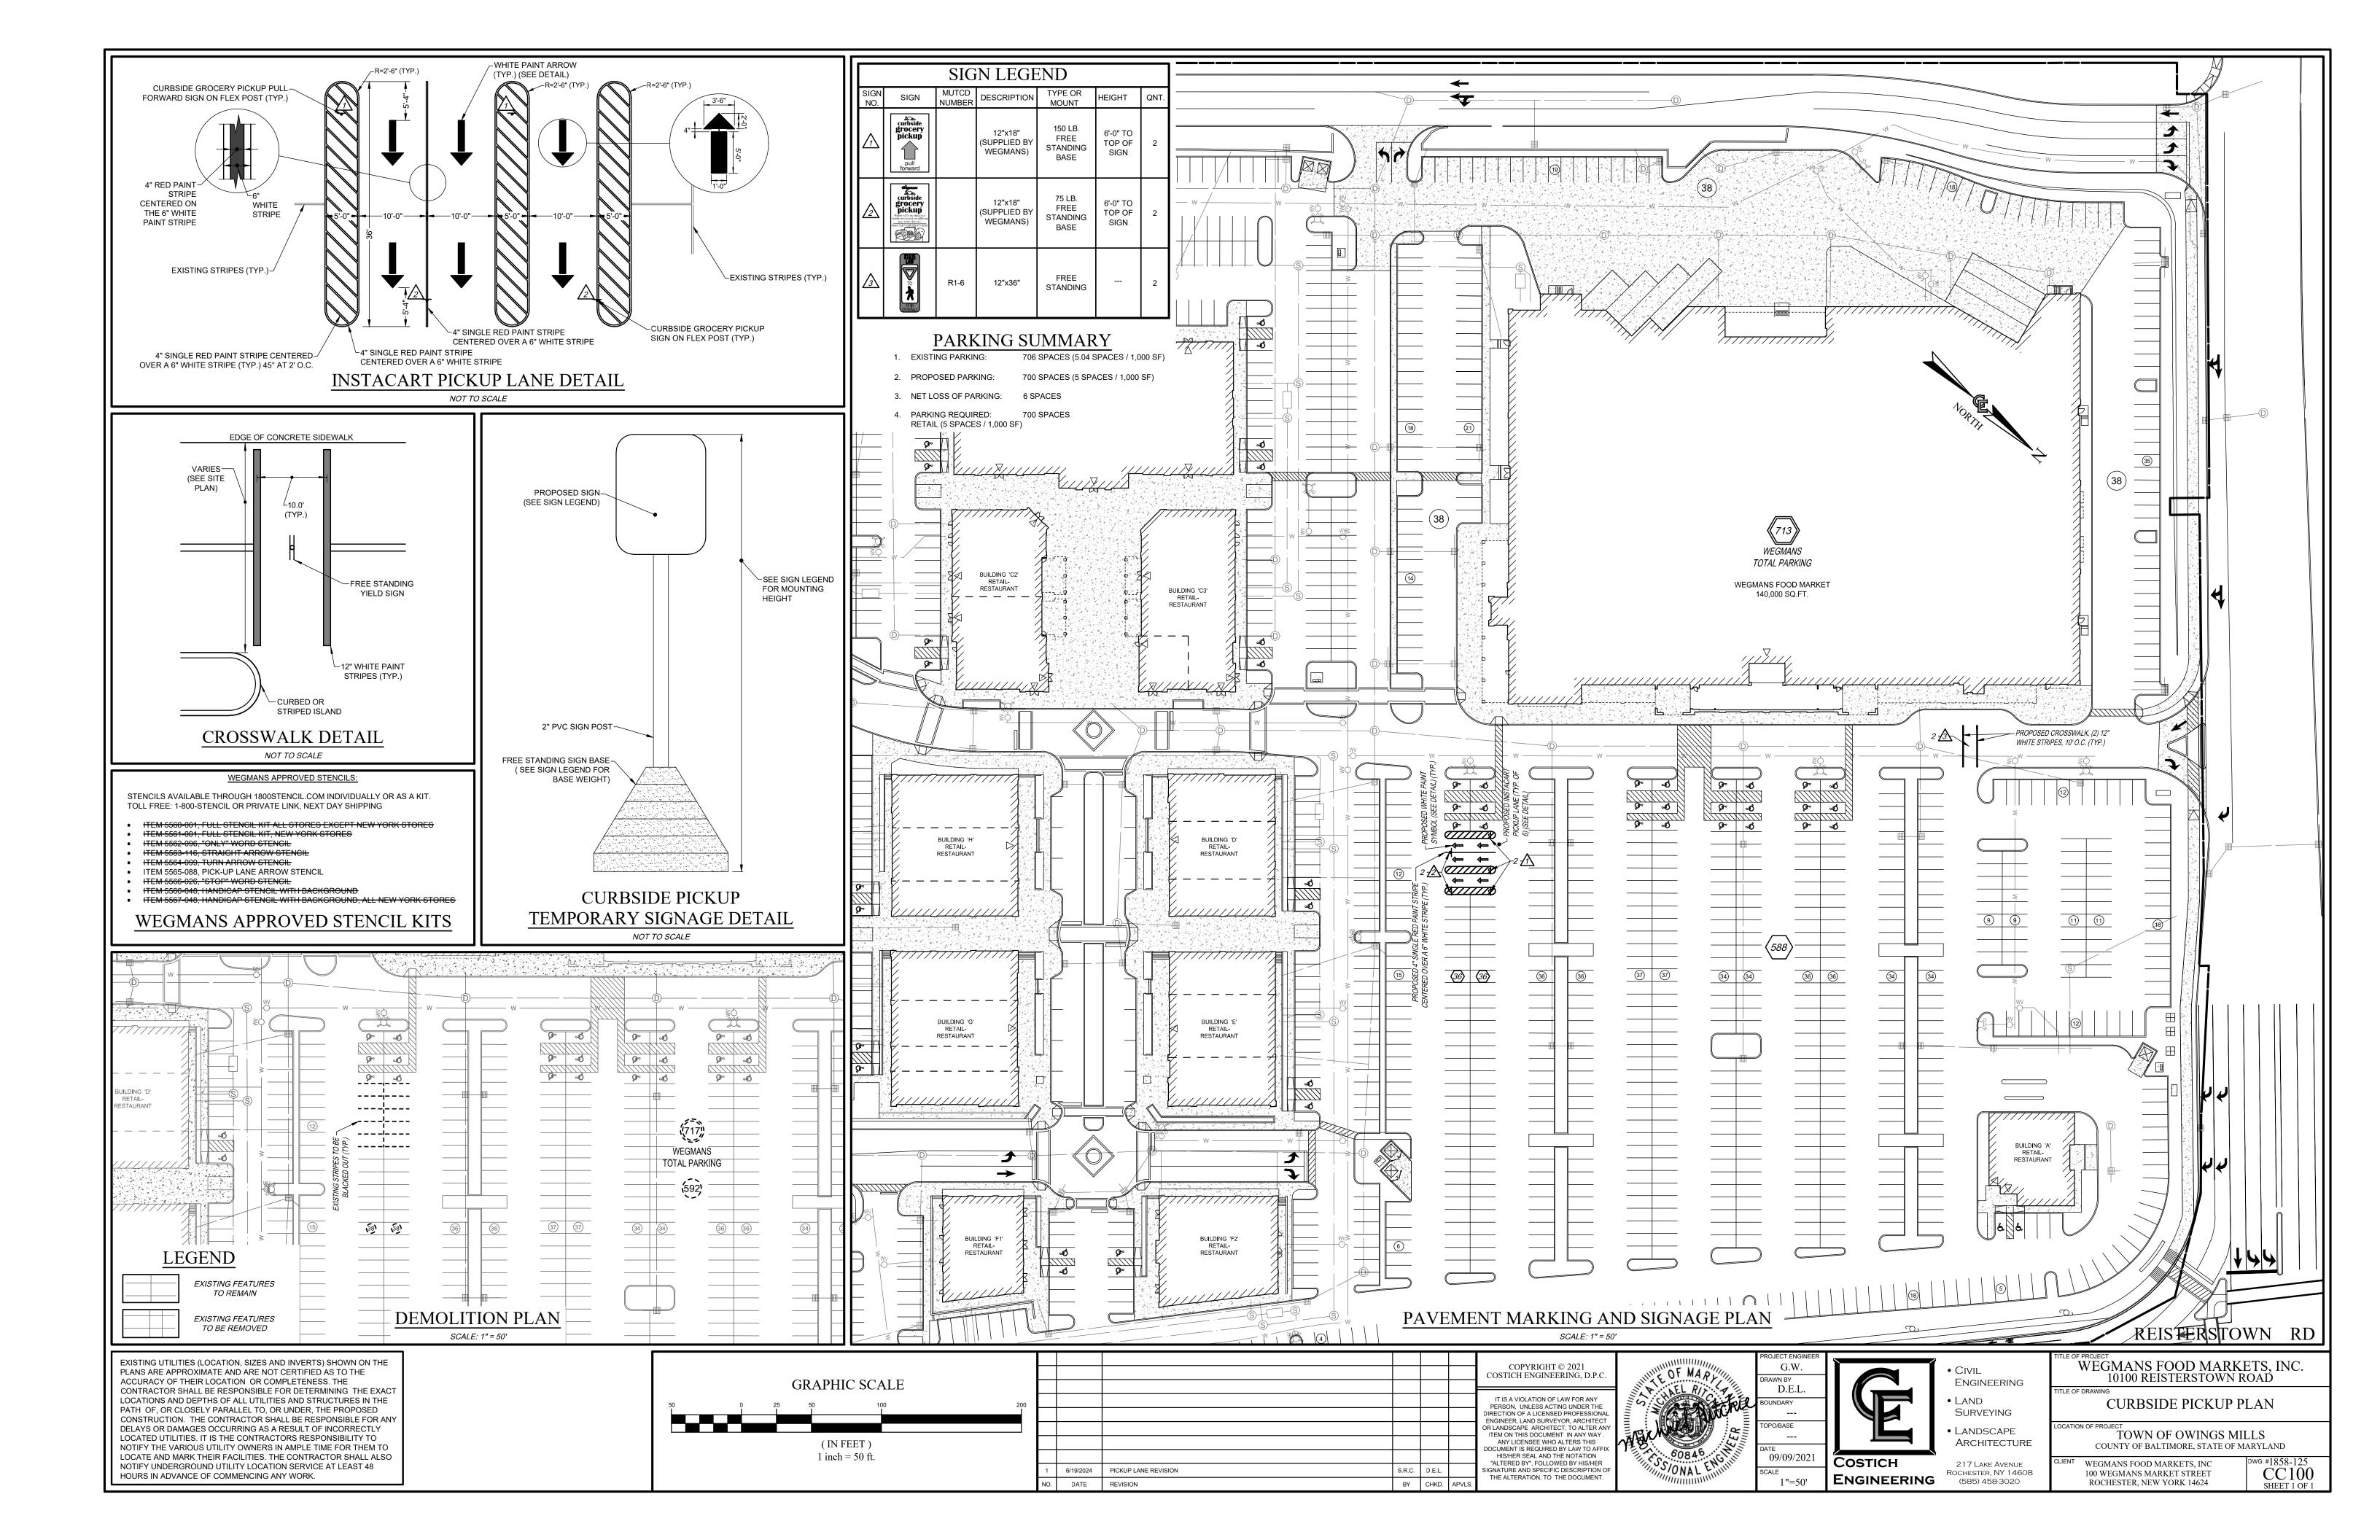

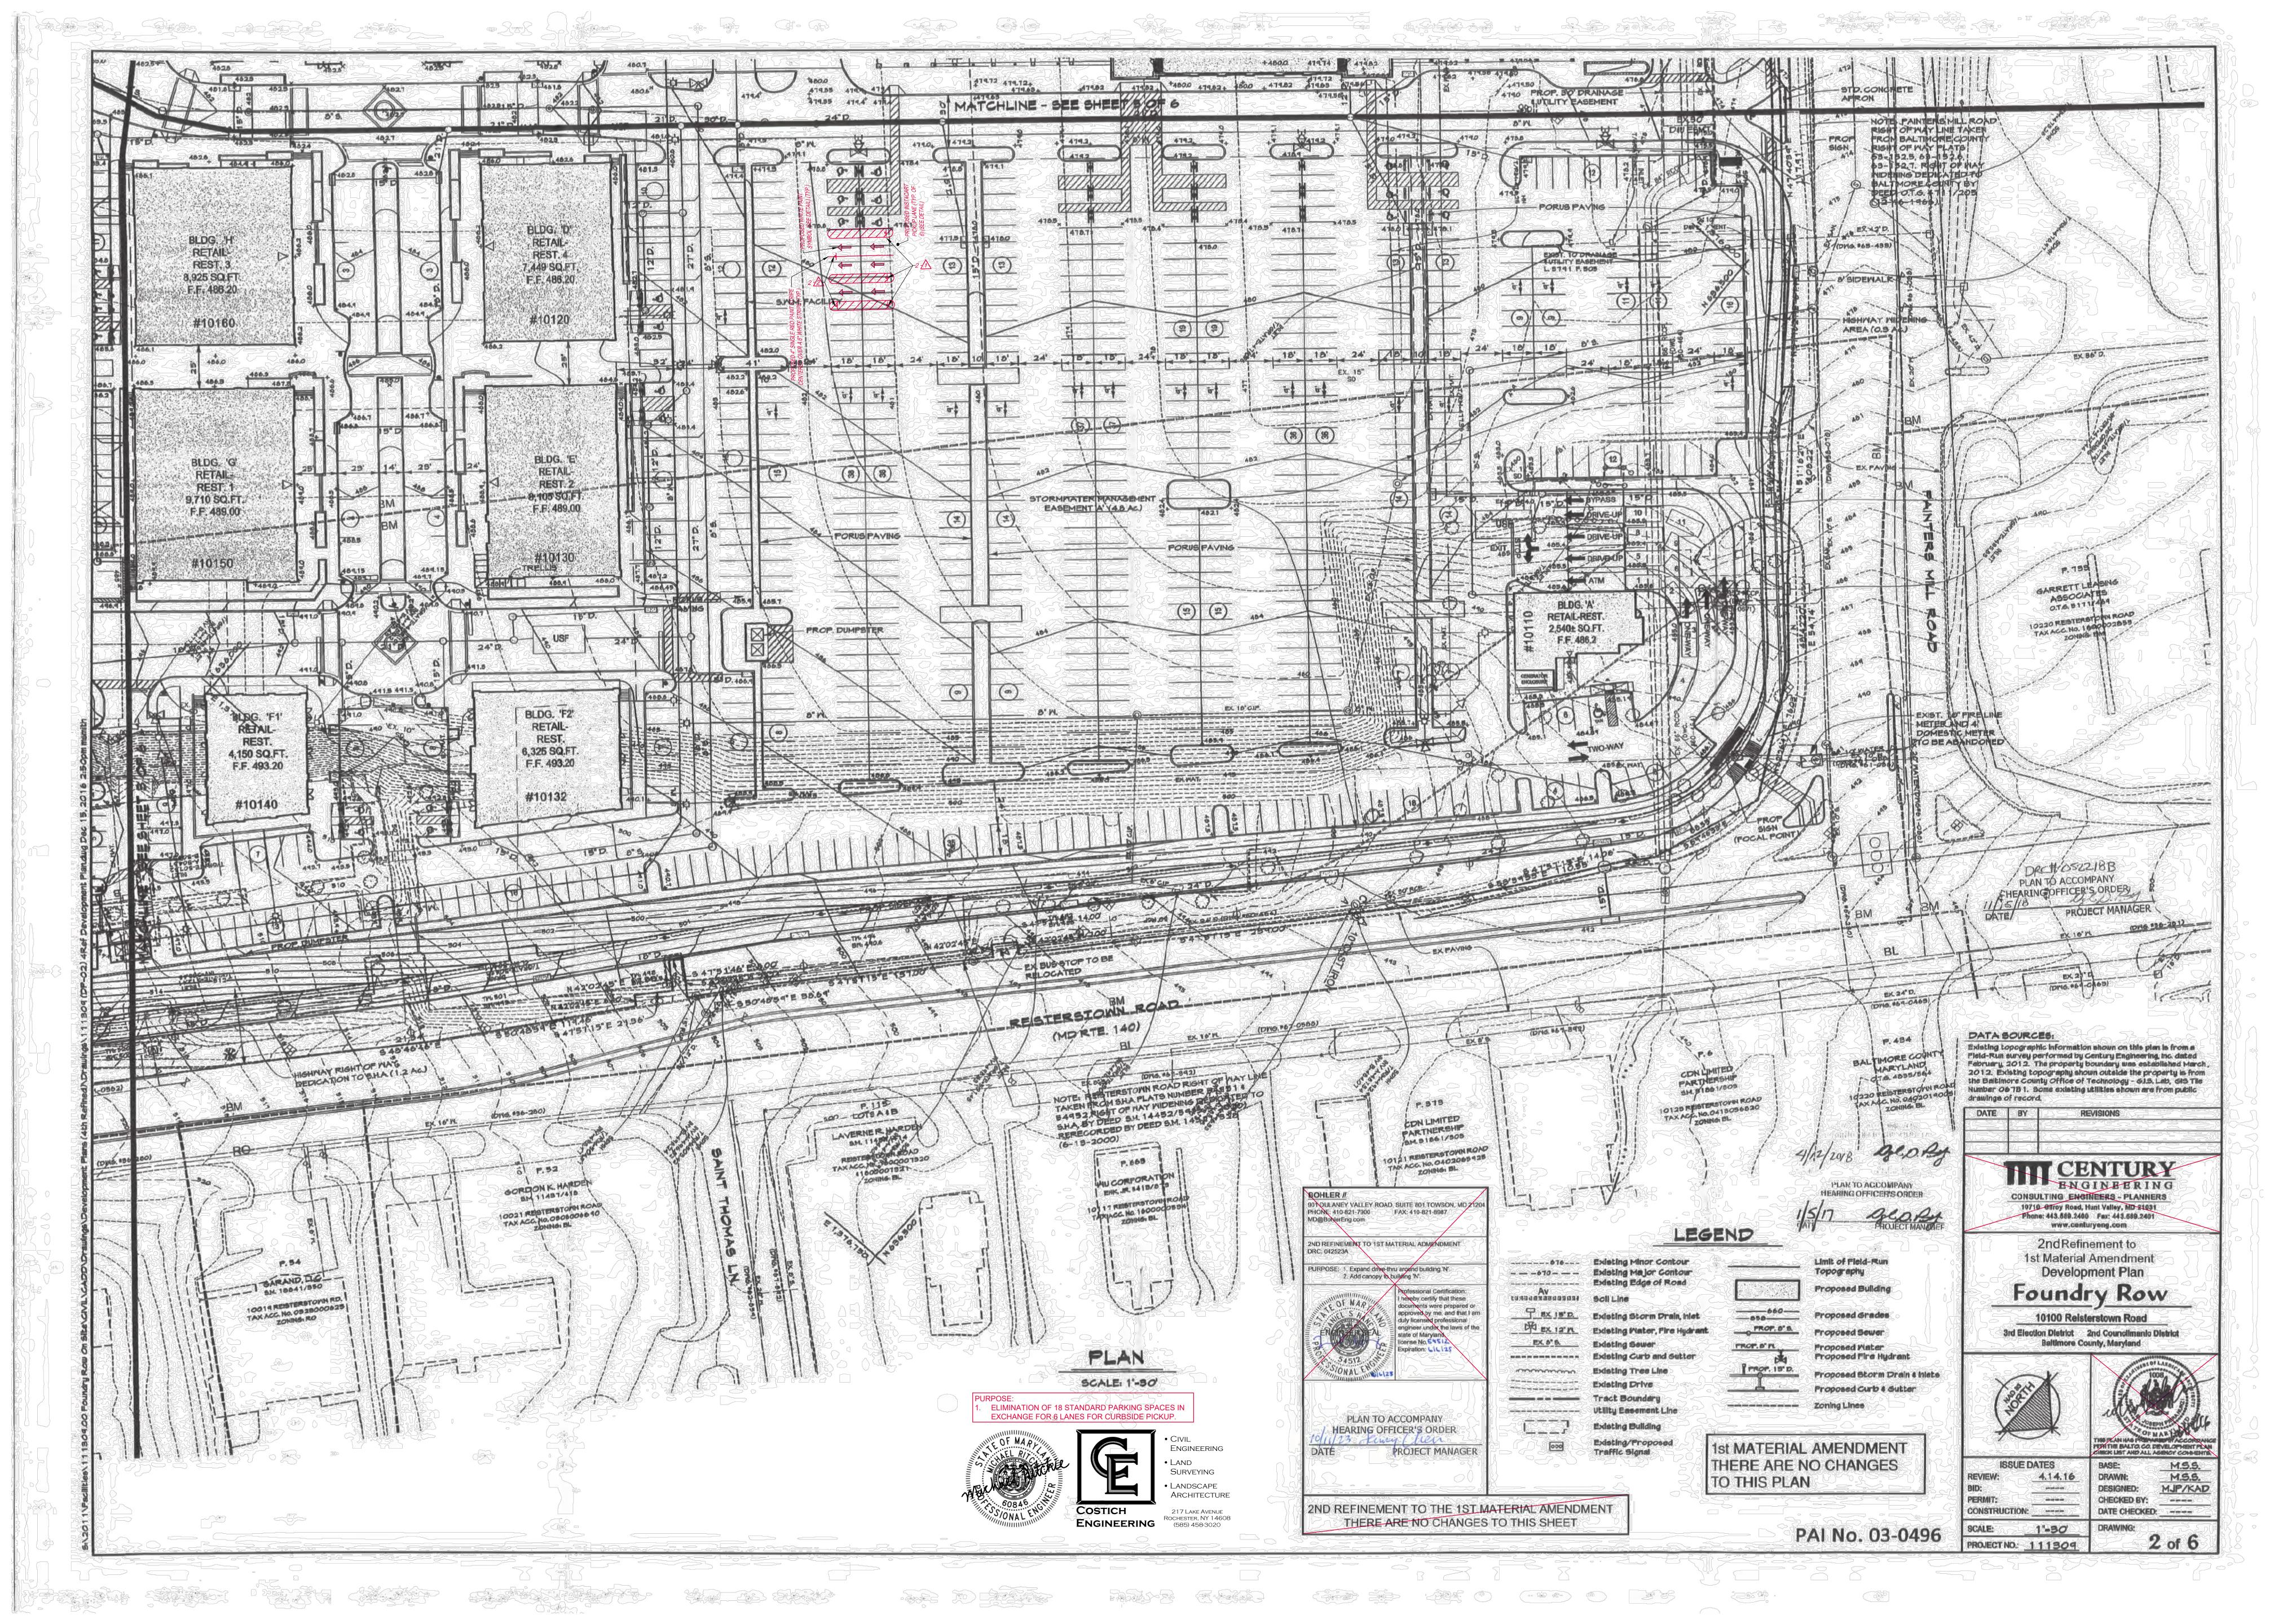

### **USE PERMIT**

Revised 10/17/11



IT IS ORDERED by the Director of the Department of Permits, A	pprovals and
Inspections of Baltimore County, this 4Th day of 700	c , 2024 ,
that Womans	located at
(Individual or business name)	
INIAA DA LA FILL	should be and the
same is hereby granted permission to operate a:	Pichof
-Six Lane Grocery Pizrup 2002	
Three	
UR-2024-0001-PP	

Wegmans


Planner's Initials To COD MARKET

# 10100 REISTERSTOWN ROAD CURBSIDE PICKUP PLANS

## TOWN OF OWINGS MILLS COUNTY OF BALTIMORE STATE OF MARYLAND

### INDEX OF DRAWINGS

SHEET NO.	DRAWING TITLE
GC001	COVER SHEET (SHEET 1 OF 3)
CC100	CURBSIDE PICKUP PLAN (SHEET 2 OF 3)
	REDLINED SITE PLAN (SHEET 3 OF 3)

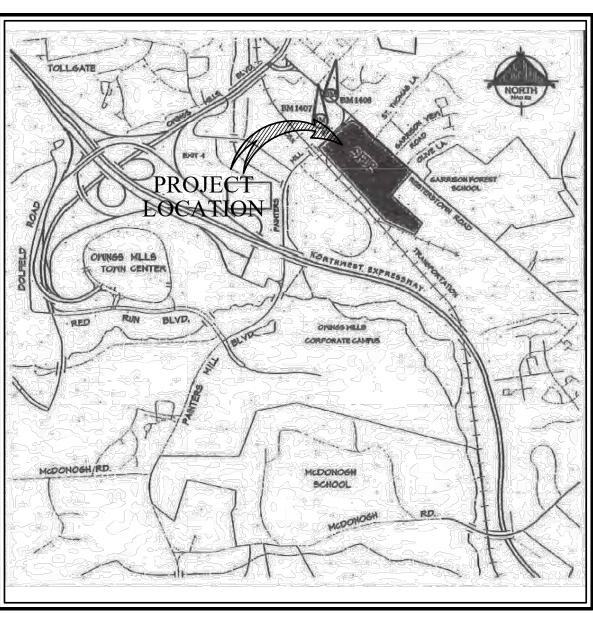

**LOCATION SKETCH** 

### PROJECT TEAM

CIVIL ENGINEER
GARTH WINTERKORN
COSTICH ENGINEERING
217 LAKE AVENUE
ROCHESTER, NEW YORK 14608
PHONE: (585) 458-3020 EXT. 115

PROJECT OWNER
CAITLYN PIATKOWSKI - PROJECT MANAGER
WEGMANS FOOD MARKETS, INC.
SITE DEVELOPMENT & ENGINEERING DEPT.
100 WEGMANS MARKET STREET
ROCHESTER, NEW YORK 14624
PHONE: (585) 720-5707

PREPARED FOR:
WEGMANS FOOD MARKETS, INC.
SITE DEVELOPMENT & ENGINEERING DEPT.
100 WEGMANS MARKET STREET
ROCHESTER, NEW YORK 14624
(585) 464-4600



ENGINEERING

LAND
SURVEYING

• Landscape Architecture

COSTICH
217 LAKE AVENUE
ROCHESTER, NY 14608
(585) 458-3020

DATE: SEPTEMBER 09, 2021 REVISED: 06/19/2024



**Wegmans** FOOD MARKET

10100 REISTERSTOWN ROAD
CURBSIDE PICKUP PLANS
TOWN OF OWINGS MILLS
COUNTY OF BALTIMORE
STATE OF MARYLAND

CONSTRUCTION PLANS PROJECT NO. 1858-125 SHEET NO. GC001

SHEET 1 C

