

0592-525

LELAND ROCKWELL,
Sulphur Spring & Oakland Roads,
15th dist.

523

1, or we, agree to pay expenses of above re-classification, advertising, posting, etc., upon filing this petition, and further agree to and are to be bound by the zoning regulations and restrictions of Baltimore County, Maryland, as amended to the Zoning Law for Baltimore County.

Address 1241 Sulphur Spring Rd.
Arbutus 27, Maryland

(over)

\$24.00

Zoning Commissioner.

PAID
DEC - 8194
COUNTY COMMISSIONER
OF BALTIMORE COUNTY
BY C. Enver

#523

John F. Finner
Zoning Commissioner of Baltimore County

.....the above re-classification should NOT be had

It Is Ordered by the Zoning Commissioner of Baltimore County, this.....day of.....

Zoning Commissioner of Baltimore County

It is this 28th day of March, 1946, ORDERED by the Board of Zoning Appeals of Baltimore County that the aforesaid Order of the Zoning Commissioner be and the same is hereby sustained and the reclassification of said property from an "A" Residence Zone to a "B" Residence Zone is hereby granted.

Wm. A. Mahoney
Edward L. Natus
Kings Beach, N.Y.
Board of Zoning Appeals
of Baltimore County.

Date: April 26, 1946

By Christian H. Kah President

~~\$22.00~~

Zoning Commissioner.

Received Payment
March 16 1946
Wacker

REC'D DEC 17 1945

TOWSON, MD. *Feb. 14/85* 12

THE JEFFERSONIAN
P. Danahy
 Manager

Cost of Advertisement, \$.....

1

ZONING DEPARTMENT - BALTIMORE COUNTY, MD

Certificate of Posting - Re-Classification of Special Permit Notice

1/3 District Date of Posting See Sec. 14-111.3

Date of Posting Report 1/15/45

Location of Sign on Property 3 (see from front Street or Road)

1. ~~most~~ *west side of Calverton Rd. South side, South*
2. ~~corner of Calverton Rd. and~~ *corner of Calverton Rd.*
3. *South side of Spring Rd.*


Re-Classification of Special Permit Petitioned for by *George Hansen*

Petitioner *Calverton Home Corporation*

Remarks: *2 signs on South side, South side of Spring Rd. 1 sign west side of Calverton Rd.*

Inspector making return *Henry D. Sankel*

ALBERT E. POWNER
SURVEYOR & CIVIL ENGINEER
322 CHARLES ST. BALTIMORE, MD.
SCALE 1" = 100' 1/2" (1/2" = 50')

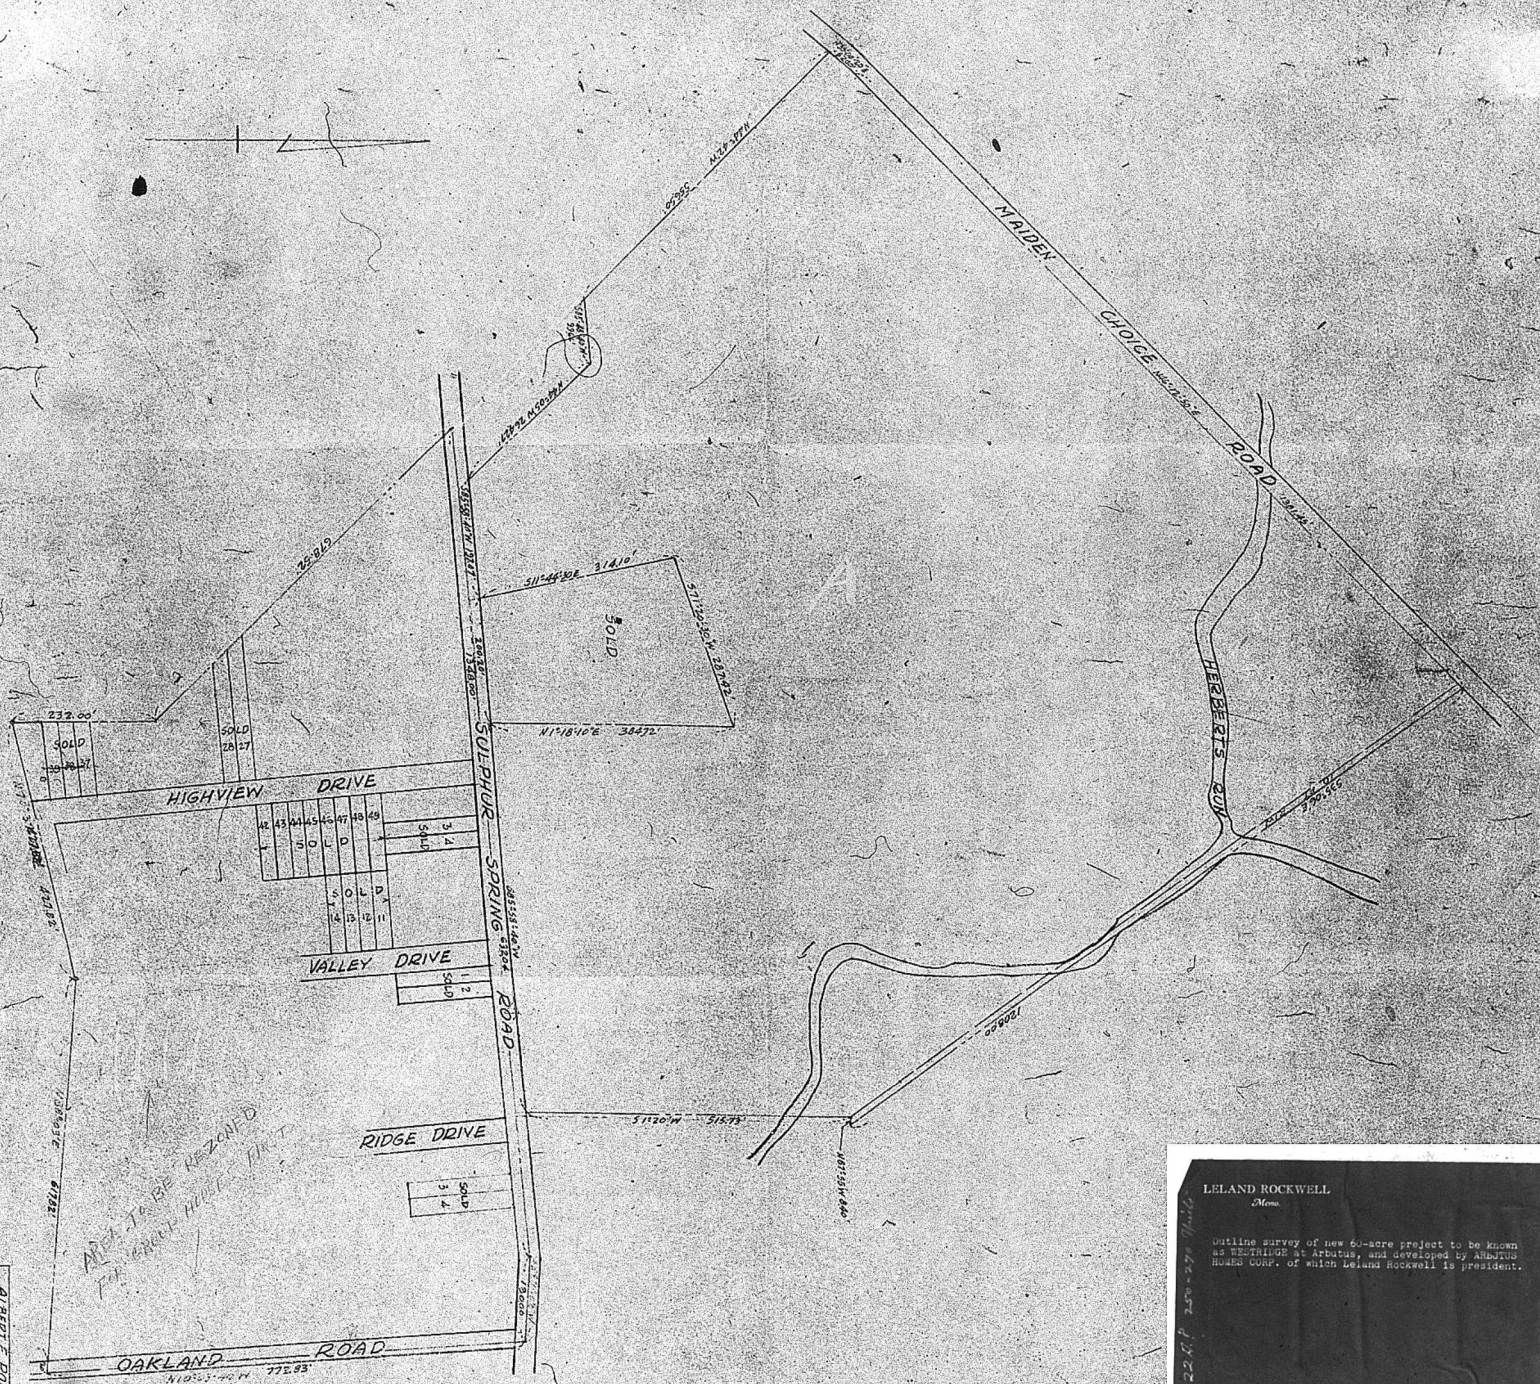

LELAND ROCKWELL
Mons.


LEGEND.

- 20' — 7 UNIT GROUPS = 140 UNITS.
 69' — 6 UNIT GROUPS = 414 UNITS.
 20' — 5 UNIT GROUPS = 100 UNITS.
 1' — 4 UNIT GROUP = 4 UNITS.
 110 = TOTAL GROUPS = 658 UNITS.

TOTAL LENGTH OF STREET = 3100 FT.
 (NOT INCLUDING BRIDGE OVER AVE. SULPHUR.
 SPRINGS ROAD. 9' OAKLAND ROAD.)

SCALE: 1" = 100'-0"

WESTRIDGE
 HOUSING.

FOR
 ARDUTUS HOMES CORP.
 BALTIMORE, MARYLAND.
 LALAND ROCKWELL — PRES.

GUSTAVE W. ISEB, ARCHITECT.
 109 EAST 29TH ST. NEW YORK, N.Y.
 DATE: NOV. 20, 1945.
 REV. NOV. 20, 1945.

