

PETITION FOR ZONING RE-CLASSIFICATION AND/OR SPECIAL EXCEPTION

TO THE ZONING COMMISSIONER OF BALTIMORE COUNTY:

I, or we, Marvin D. Kolker and Ann B. Kolker, his wife, of the property situated in Baltimore County and which is described in the description and plat attached hereto and made a part hereof, hereby petition (1) that the zoning status of the herein described property be reclassified, pursuant to the Zoning Law of Baltimore County, from R-10 to B-R and (2) for a Special Exception, under the said Zoning Law and Zoning Regulations of Baltimore County, to use the herein described property, for:

change in zoning and utilities in neighborhood and economic infeasibility of using area for an individual home.

See attached description

and (3) for a Special Exception, under the said Zoning Law and Zoning Regulations of Baltimore County, to use the herein described property, for:

Property is to be used and advertised as prescribed by Zoning Regulations.

I, or we, agree to pay expenses of above re-classification and/or Special Exception advertising, posting, etc., upon filing of this petition, and further agree to and are to be bound by the zoning regulations and restrictions of Baltimore County adopted pursuant to the Zoning Law for Baltimore County.

Contract purchaser: Marvin D. Kolker
Address: Barton Oaks Road, Pikesville, MD.
Legal Owner: Marvin D. Kolker
Address: 107 Jefferson Building, Towson, MD. 21204
Petitioner's Attorney: Raymond Feinberg
Address: 1414 E. Baltimore Ave., Baltimore, Maryland 21202
Protestant's Attorney: John A. Slawik
Address: 1414 E. Baltimore Ave., Baltimore, Maryland 21202

ORDERED By The Zoning Commissioner of Baltimore County, this 14th day of October, 1969, that the subject matter of this petition be advertised, as required by the Zoning Law of Baltimore County, in two newspapers of general circulation throughout Baltimore County, that property be posted, and that the public hearing be had before the Zoning Commissioner of Baltimore County in Room 108, County Office Building in Towson, Baltimore County, on the 15th day of December, 1969, at 2:00 o'clock.

Edward D. Hardisty
Zoning Commissioner of Baltimore County

(over)

WHITFORD, FALK, AND MARK
Consulting Engineers - Land Surveyors
Land Planners
JEFFERSON BUILDING
TOWSON, MARYLAND 21204

November 13, 1968

Description of 0.962 Acre Parcel to Accompany Petition for Reclassification of Zoning from R-10 Zone to "B-R" Zone Kolker Property

Beginning for the same at a point on the southernmost side of Old Court Road, said point being 235.62 feet measured westerly from the westernmost side of Reisterstown Road (66 feet wide) and thence leaving said Old Court Road South 34° 33' East, 287.00 feet, more or less, to the northernmost side of Clovelly Road (30 feet wide); thence binding on said north side of Clovelly Road South 78° 07' West, 48.33 feet; thence to the centerline of said Clovelly Road South 30° 07' West, 15.00 feet, and thence binding on or near the centerline of said Clovelly Road (30 feet wide) the two following courses: (1) North 60° 22' West, 92.33 feet; and (2) North 67° 41' West, 105.08 feet; thence leaving said Clovelly Road North 17° 20' West, 171.05 feet to the southernmost side of Old Court Road as previously mentioned herein and thence binding on the southernmost side of said Old Court Road the following two courses: (1) North 64° 14' 29" East, 49.56 feet; and (2) North 58° 34' 12" East, 91.15 feet to the point of beginning. Containing 0.962 acres of land, more or less.



RE: PETITION FOR RECLASSIFICATION -
S/S Old Court Road 235.62' W. of
Reisterstown Road
3rd District
Marvin D. Kolker
Petitioner
BEFORE
COUNTY BOARD OF APPEALS
OF
BALTIMORE COUNTY
No. 70-113-R

ORDER OF DISMISSAL

Petition of Marvin D. Kolker for reclassification from R-10 zone to B.R. zone, on property located on the south side of Old Court Road 235.62' west of Reisterstown Road, in the 3rd District of Baltimore County.

WHEREAS, the Board of Appeals is in receipt of an Order of Dismissal of appeal filed May 8, 1970 (a copy of which is attached hereto and made a part hereof) from the attorney representing the Petitioner-Appellant; and

WHEREAS, the said attorney for the said Petitioner-Appellant requests that the appeal filed on behalf of said Petitioner be dismissed and withdrawn as of May 8, 1970;

IT IS HEREBY ORDERED, this 12th day of May, 1970, that said appeal be and the same is dismissed.

COUNTY BOARD OF APPEALS
OF BALTIMORE COUNTY

William S. Baldwin
William S. Baldwin, Chairman
W. Giles Parker
W. Giles Parker
John A. Slawik
John A. Slawik

RECLASSIFICATION S/S OF OLD COURT ROAD, 235.62' W. of Reisterstown Road - 3rd District MARVIN D. KOLKER and ANN B. KOLKER, his wife.
BEFORE THE COUNTY BOARD OF APPEALS OF BALTIMORE COUNTY
Case No. 70-113-R (Item No. 74)

ORDER OF DISMISSAL

Gentlemen:

Please enter an Order of Dismissal on behalf of Marvin D. Kolker and Ann B. Kolker, his wife, Petitioners, the Appellants in the above entitled case.

Raymond Feinberg
Attorney for Marvin D. Kolker and Ann B. Kolker

cc:

Raymond Feinberg, Esquire,
1414 Clarkview Road,
Baltimore, Maryland 21209

RECLASSIFICATION S/S OF OLD COURT ROAD, 235.62' W. of Reisterstown Road - 3rd District MARVIN D. KOLKER and ANN B. KOLKER, his wife.
BEFORE THE ZONING COMMISSIONER OF BALTIMORE COUNTY
Case No. 70-113-R (Item No. 74)

ORDER FOR APPEAL

Mr. Commissioner:

Please enter an Appeal in the above captioned matter to the Board of Appeals for Baltimore County from your decision of February 10, 1970, denying the reclassification on behalf of the above captioned Marvin D. Kolker and Ann B. Kolker, his wife.

Raymond Feinberg
Attorney for Marvin D. Kolker and Ann B. Kolker

cc: Raymond Feinberg, Esquire,
1414 Clarkview Road,
Baltimore, Maryland 21209

BALTIMORE COUNTY, MARYLAND

INTE-OFFICE CORRESPONDENCE

TO: Mr. Edward D. Hardisty, Deputy Zoning Commissioner
FROM: George E. Cavellis, Director of Planning
Date: December 11, 1969

SUBJECT: Petition 70-113-R, Reclassification from R-10 to B.R. Zone. South side of Old Court Road 235.62 feet west of Reisterstown Road. Marvin D. Kolker, Petitioner.

3rd District

HEARING: Monday, December 15, 1969 (2:00 P.M.)

The planning staff of the Office of Planning and Zoning has reviewed the subject petition and offers the following comments:

- The subject request is not in accordance with the proposed zoning map preliminary approved by the Planning Board, and it is not reflected by staff or committee recommendations with respect to changes in the preliminary map to ready it for final Board approval.
- We have no record of this request as an issue brought before the Planning Board in or pursuant to its hearings on the preliminary map.
- The subject petition constitutes another example of the difficulties to be encountered when two methods of zoning reclassification are being employed during the same period of time. We again point out that any decision rendered pursuant to the subject petition (or any other zoning reclassification petition) will be, in effect, subject to rejection or confirmation upon adoption of the new comprehensive zoning map, required under the County Code by June 30, 1970. In view of this, it is suggested that the subject petition be withdrawn, and that the reclassification issue be decided solely through the process of comprehensive zoning-map review and adoption. In this process, it would be appropriate for the petitioner to bring his request before the County Council after the Planning Board has forwarded its final recommendations.
- Without in any way changing our view that the issue should not be decided under petition review, we do take issue with this proposal and the reasons for reclassification stated by the petitioner's attorney.

It is implied that use of property for commercial purposes renders adjacent property "useless" for residential purposes. If this were true, it would be impossible to draw any line as a boundary between residential and commercial zones without rendering property "useless." We agree with the many planning-law authorities and jurists who have said, simply enough, "The line must be drawn somewhere." The Zoning Regulations recognize this by providing for "buffer"

ROYSTON, MUELLER, THOMAS & MCLEAN

ATTORNEYS AT LAW
100 WEST WASHINGTON AVENUE
TOWSON, MARYLAND 21204

April 21, 1970

Board of Appeals of Baltimore County
County Office Building
Towson, Maryland 21204

Re: Zoning Appeal - Petition 70-113-R
Reclassification from R-10 to B.R. Zone
South side of Old Court Road 235.62 feet west of Reisterstown Road.
Marvin D. Kolker, Petitioner and Appellant

Gentlemen:

Will you please enter the appearance of Ronald M. Shapiro and me as attorneys for parties protestant, Frank A. Kaufman and Clementine L. Kaufman and Joel G. D. Butzler and Carolyn Butzler, in the above referred to zoning appeal.

Very truly yours,

R. Taylor McLean
R. Taylor McLean

RTMCL/md

cc: Raymond Feinberg, Esq.
Julius R. Willen, Esq.
James P. Offutt, Jr., Esq.
Ronald M. Shapiro, Esq.

Reid Gamm
4/21/70

CERTIFICATE OF POSTING ZONING DEPARTMENT OF BALTIMORE COUNTY Towson, Maryland

District: 2nd Date of Posting: Nov. 29 - 1969
Posted for: RECLASSIFICATION FROM R-10 TO B.R.
Petitioner: MARVIN D. KOLKER
Location of property: 1/4 OF OLD COURT RD. 235.62 FT. W. OF REISTERSTOWN RD.
Location of Signs: ON S/S OF OLD COURT RD. 235.62 FT. W. OF REISTERSTOWN RD. @ N/S OF CLOVELLY RD. 400 FT. E. W. OF REISTERSTOWN RD.
Remarks:
Posted by: Charles M. Paul Date of return: Dec. 19 - 1969
70-113-R

CERTIFICATE OF POSTING ZONING DEPARTMENT OF BALTIMORE COUNTY Towson, Maryland

District: 2nd Date of Posting: Nov. 29 - 1969
Posted for: RECLASSIFICATION FROM R-10 TO B.R.
Petitioner: MARVIN D. KOLKER
Location of property: 1/4 OF OLD COURT RD. 235.62 FT. W. OF REISTERSTOWN RD.
Location of Signs: ON S/S OF OLD COURT RD. 235.62 FT. W. OF REISTERSTOWN RD. @ N/S OF CLOVELLY RD. 400 FT. E. W. OF REISTERSTOWN RD.
Remarks:
Posted by: Charles M. Paul Date of return: Dec. 19 - 1969

OCT 27 1978

Pursuant to the advertisement, posting of property, and public hearing on the above petition and it appearing that by reason of

the above Reclassification should be had; and it further appearing that by reason of

a Special Exception for a.....should be granted.

IT IS ORDERED by the Zoning Commissioner of Baltimore County this.....day of....., 1967, that the herein described property or area should be and the same is hereby reclassified; from a.....zone to a.....zone, and/or a Special Exception for a.....should be and the same is granted, from and after the date of this order.

Zoning Commissioner of Baltimore County

Pursuant to the advertisement, posting of property and public hearing on the above petition and it appearing that by reason of failure to show that the proposed zoning map or substantial changes in the character of the neighborhood

the above re-classification should NOT BE HAD, and/or a Special Exception should NOT BE GRANTED.

IT IS ORDERED by the Zoning Commissioner of Baltimore County, this.....day of....., 1967, that the above re-classification be and the same is hereby DENIED and that the above described property or area be and the same is hereby continued as to remain a.....zone, and/or a Special Exception for a.....should be and the same is granted.

ORDER REVERSED FOR FILING

DATE 3/10/70

BY J. C. HARRIS, Jr.
ADMINISTRATIVE ASSISTANT

Edward D. Hardesty
Zoning Commissioner of Baltimore County

James F. Offutt, Jr., Esq.
107 Jefferson Building
Towson, Maryland 21204
Item 74 Page 4

October 30, 1969

BOARD OF EDUCATION:

Acres is too small to commit on since no more than one (1) student would be involved.

FIRE DEPARTMENT:

Owner shall be required to comply with all Fire Department requirements in accordance with Life Safety Code, 1967 edition, Chapter 12, "Mercantile Occupancies", when plans are submitted for approval.

HEALTH DEPARTMENT:

Public water is available and sewers are proposed.

Air Pollution Comments: The building or buildings on this site may be subject to registration and compliance with the Maryland State Health Air Pollution Control Regulations. Additional information may be obtained from the Division of Air Pollution, Baltimore County Department of Health.

BUREAU OF TRAFFIC ENGINEERING:

The requested zoning change could increase trip density by 400 trips per day. However, the way the property is proposed to be graded, the southerly portion of the property will have access only to Clovelly Road. This road is not conducive to commercial traffic.

ZONING ADMINISTRATION DIVISION:

The petitioner should take note of the Bureau of Engineering's comment in regard to the sewer.

This petition is accepted for filing on the date of the enclosed filing certificate. Notice of the hearing date and time, which will be held not less than 30, nor more than 90 days after the date on the filing certificate, will be forwarded to you in the near future.

Very truly yours,

Oliver L. Myers
Oliver L. Myers, Chairman

BALTIMORE COUNTY ZONING ADVISORY COMMITTEE

October 30, 1969

COUNCIL ON A. REEDS
111 N. Chesapeake Ave.
Towson, Maryland 21204

OLIVER L. MYERS
Chairman

MEMBERS:

BUREAU OF ENGINEERING

DEPARTMENT OF HEALTH

STATE BOARD OF COMMISSIONERS

DEPARTMENT OF FIRE PREVENTION

HEALTH DEPARTMENT

PROJECT PLANNING

BUILDING DEPARTMENT

BOARD OF EDUCATION

ZONING ADMINISTRATION

DEPARTMENT

James F. Offutt, Jr., Esq.
107 Jefferson Building
Towson, Maryland 21204

RE: Type of Hearing: Reclassification
from an R-10 zone to an R-10 zone
Location: 5/5 of Old Court Rd., 235.62
W. of Reisterstown Road
Petitioner: Marvin D. Kolkar, et al
Committee Meeting of October 14, 1969
3rd District
Item 74

Dear Sir:

The Zoning Advisory Committee has reviewed the plans submitted with the above referenced petition and has made an on site field inspection of the property. The following comments are a result of this review and inspection.

The subject property is presently improved with a ranch type brick home with attached garage. It fronts on Clovelly Road. The access to the existing dwelling would be by Reisterstown Road to Clovelly Road. The property to the east is involved with a Shopper's Supermarket. The properties to the southeast and north are improved with dwellings, 10 to 40 years of age, in excellent repair. The topography of the land is such that the entire lot lies below the level of the Old Court Road and Shopper's Supermarket. Clovelly Road at the present time is not improved as far as concrete curb and gutter are concerned; however, Old Court Road is since it was recently widened.

BUREAU OF ENGINEERING:

Highways:

Old Court Road is an existing County road improved with a 40-foot closed section with flexible pavement on a variable width right-of-way, minimum width 70 feet. No further improvements are required at this time. However, public sidewalk will be required along the Old Court Road frontage.

James F. Offutt, Jr., Esq.
107 Jefferson Building
Towson, Maryland 21204
Item 74 Page 2

October 30, 1969

Highways: (Continued)

The entrance locations are subject to approval by the Department of Traffic Engineering.

Entrances shall be a minimum of 24 ft. and a maximum of 30 feet wide, shall have 5-foot minimum radius curb returns, shall be located a minimum of 75 feet from any property line, and shall be constructed in accordance with Baltimore County Standards for 7 inch concrete entrance.

Clovelly Road is an existing public road maintained by Baltimore County, which will be improved in the future as a 30-foot closed section with flexible pavement on a 40-foot right-of-way. No vehicular access will be permitted to this property or the adjacent supermarket, from Clovelly Road. A 5-foot minimum highway widening along the frontage of Clovelly Road is required. Highway improvements, including public sidewalk, will be required in connection with any subsequent grading or building permit applications.

Sewer Drainage:

The Applicant must provide necessary drainage facilities (temporary or otherwise) to prevent creating any nuisances or damages to adjacent properties, especially by the concentration of surface waters. Correction of any problem which may result, due to improper grading or other drainage facilities, would be the full responsibility of the Applicant.

Sediment Controls:

Development of this property through striping, grading, and stabilization could result in a sediment pollution problem, disrupting private and public holdings downstream of the property. A grading permit is, therefore, necessary for all grading, including the striping of top soil.

Grading studies and sediment control drawings will be necessary to be reviewed and approved prior to the issuance of any grading or building permits.

Water:

Public water supply is available to serve this property.

James F. Offutt, Jr., Esq.
107 Jefferson Building
Towson, Maryland 21204
Item 74 Page 3

October 30, 1969

Sanitary Sewer:

Public sanitary sewerage is not readily available to serve this property. However, public sanitary sewerage can be made available to serve this property by constructing a public sanitary sewer extension, approximately 2500 feet in length, from the existing 8-inch public sanitary sewer shown on Drawing SJ-526, A-10. Thus, sewage would be directed to the Wynns Falls Sanitary Interceptor Sewer.

The Developer's financial responsibility will be determined by the Director of Public Works in regard to any deficit to be incurred by the construction, under County contract and inspection, of such public sanitary sewerage to serve this property. The Developer is responsible for the prepayment and cost of construction drawings and right-of-way plans required.

The Developer indicates proposed construction of a public sanitary sewer to connect to the existing 8-inch sanitary sewer in the west side of Reisterstown Road, shown on Drawing 40-741, A-10.

This method of sewerage the site would direct the sewage to the Jones Falls Sewage Pumping Station and would require approval by the Director of Public Works of Baltimore County, and the Maryland State Department of Health, as recent restrictions imposed by the Maryland State Department of Health on increased sewage flow contributing to the Jones Falls Sewage Pumping Station prohibits the connection of this site to this existing public sewerage system. This restriction is anticipated to prevail until mid 1971.

The Developer is entirely responsible for the construction, and the cost of the construction and maintenance, of his on site private sanitary sewerage, which must conform with the Baltimore County Plumbing Code.

No approval is granted to include any food waste grinder among the sanitary fixtures. This is subject to further review, upon application for permission to the Department of Permits and Licenses.

The Developer shall provide a 10-foot drainage and utility easement through the property contiguous to the easternmost property line.

PROJECT PLANNING DIVISION:

This plan has been reviewed and there are no site planning factors requiring comment.

THE COMMUNITY TIMES

RANDALLSTOWN, MD. 21133 Dec. 4, 1969

THIS IS TO CERTIFY, that the annexed advertisement of Edward D. Hardesty, Deputy Zoning Commissioner of Baltimore County

was inserted in THE COMMUNITY TIMES, a weekly newspaper published

in Baltimore County, Maryland, once a week for ONE WEEK

beginning the 4th day of Dec., 1969 that is to say, the same

was inserted in the issue of November 27, 1969.

STROMBERG PUBLICATIONS, Inc.

By: Ruth Morgan

PETITION FOR RECLASSIFICATION

and ZONING

LOCATION: From R-10 to R-10 Zone

LOCATION: South side of Old Court Road, 235.62 feet West of Reisterstown Road

DATE: 2 Year Hearing, November 11, 1969 at 7:00 P.M.

PUBLIC HEARING: Room 114, County Office Building, 111 W. Chesapeake Avenue, Towson, Maryland

The Board of Commissioners of Baltimore County, in and for Baltimore County, do hereby certify that the above petition was filed with the Board of Commissioners of Baltimore County, and that a public hearing was held on the same on the date and at the place above stated.

Witness my hand and the Seal of Baltimore County, this 27th day of November, 1969.

Edward D. Hardesty, Deputy Zoning Commissioner of Baltimore County

CERTIFICATE OF PUBLICATION

TOWSON, MD. NOV. 27, 1969

THIS IS TO CERTIFY, that the annexed advertisement was

published in THE JEFFERSONIAN, a weekly newspaper printed

and published in Towson, Baltimore County, Md., once in each

of one time, successive weeks before the 15th

day of December, 1969, the first publication

appearing on the 27th day of November

1969.

THE JEFFERSONIAN

By: Ruth Morgan

Cost of Advertisement, \$.....

CERTIFICATE OF PUBLICATION

TOWSON, MD. NOV. 27, 1969

THIS IS TO CERTIFY, that the annexed advertisement was

published in THE JEFFERSONIAN, a weekly newspaper printed

and published in Towson, Baltimore County, Md., once in each

of one time, successive weeks before the 15th

day of December, 1969, the first publication

appearing on the 27th day of November

1969.

THE JEFFERSONIAN

By: Ruth Morgan

Cost of Advertisement, \$.....

James F. Offutt, Jr., Esq.
107 Jefferson Building
Towson, Maryland 21204

BALTIMORE COUNTY OFFICE OF PLANNING AND ZONING

County Office Building
111 W. Chesapeake Avenue
Towson, Maryland 21204

Your Petition has been received and accepted for filing this

day of _____, 1969

14th October


John G. Rossi
John G. Rossi,
Zoning Commissioner

Petitioner

Petitioner: Marvin D. Kolker, et al

Reviewed by

Charles L. Myers
Chairman of
Advisory Committee

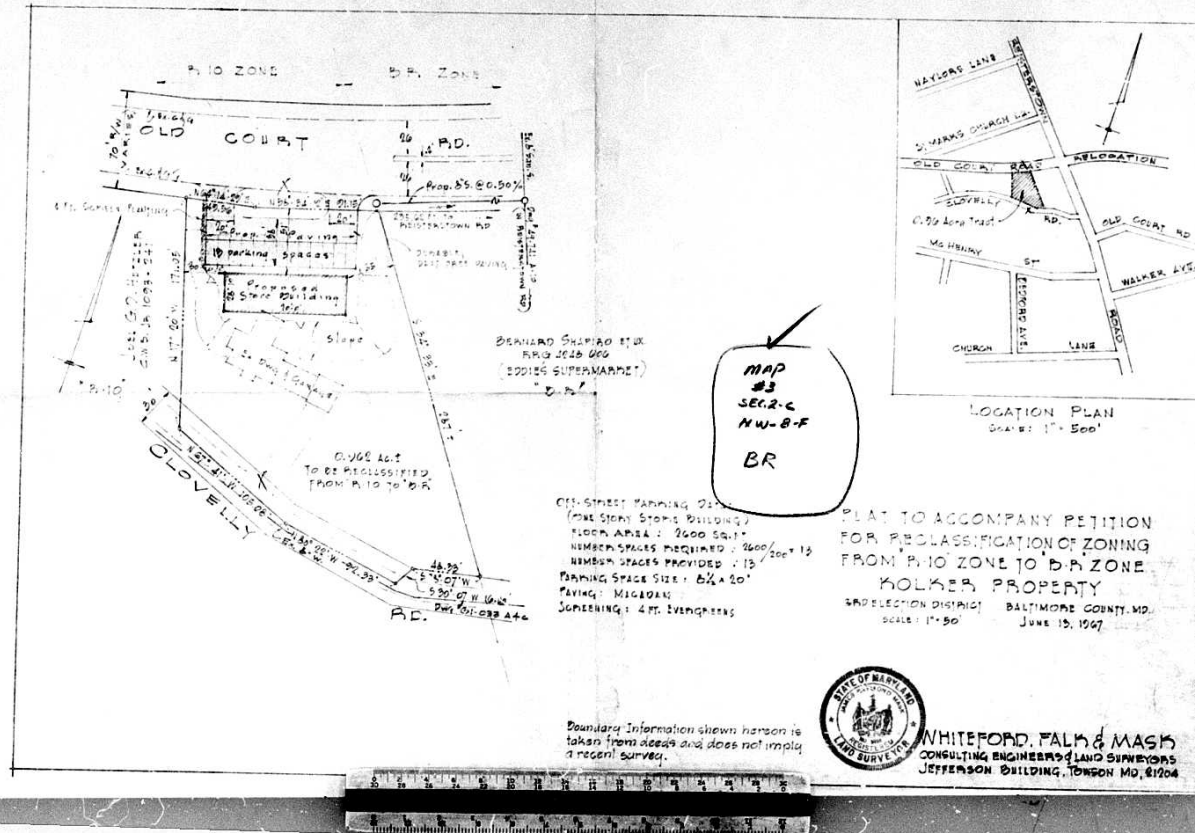

(ONE STORY STORE BUILDING)
NUMBER OF SPACES PROVIDED: 2600 / 200 x 13
NUMBER OF SPACES PROVIDED: 13
PARKING SPACE SIZE: 6' x 20'

PLAN TO ACCOMPANY PETITION
FOR RECLASSIFICATION OF ZONING
KOLKER PROPERTY
SCALE: 1" = 50'
JUNE 13, 1967

Boundary information shown herein is
taken from deeds and does not imply
a recent survey.



WHITEFORD, FALK & MASH
CONSULTING ENGINEERS AND SURVEYORS
JEFFERSON BUILDING, TOWSON, MD. 21204

TELEPHONE
823-3000
EXT. 387

BALTIMORE COUNTY, MARYLAND OFFICE OF FINANCE

No. 67097

DATE: Dec. 15, 1962

Division of Collection and Receipts
COURT HOUSE
TOWSON, MARYLAND 21204

BILLED BY:

Zoning Dept. of Baltimore County

To: Maryland Lumber Co.
2520 W. Franklin St.
Baltimore, Md. 21223

REPORT TO ACCOUNT NO. 01 RETURN THIS PORTION WITH YOUR REMITTANCE

DETACH ALONG PERFORATION AND KEEP THIS PORTION FOR YOUR RECORDS

QUANTITY 1.00 COST \$52.00

Advertising and posting of property 770-113-R 52.00

4

IMPORTANT: MAKE CHECKS PAYABLE TO BALTIMORE COUNTY, MARYLAND

MAIL TO DIVISION OF COLLECTION & RECEIPTS, COURT HOUSE, TOWSON, MARYLAND 21204

TELEPHONE
823-3000
EXT. 387

BALTIMORE COUNTY, MARYLAND OFFICE OF FINANCE

No. 69302

DATE: 2/26/70

Division of Collection and Receipts
COURT HOUSE
TOWSON, MARYLAND 21204

BILLED BY:

To: James F. Offutt, Jr., Esq.
119 County Office Bldg.
Towson, Md. 21204

Zoning Office
119 County Office Bldg.
Towson, Md. 21204

REPORT TO ACCOUNT NO. 01-622 RETURN THIS PORTION WITH YOUR REMITTANCE

DETACH ALONG PERFORATION AND KEEP THIS PORTION FOR YOUR RECORDS

QUANTITY 1.00 COST 70.00

Cost of appeal - property of Marvin D. Kolker and Ann B. Kolker 70.00

No. 70-113-R

4

IMPORTANT: MAKE CHECKS PAYABLE TO BALTIMORE COUNTY, MARYLAND

MAIL TO DIVISION OF COLLECTION & RECEIPTS, COURT HOUSE, TOWSON, MARYLAND 21204

TELEPHONE
823-3000
EXT. 387

BALTIMORE COUNTY, MARYLAND OFFICE OF FINANCE

No. 67067

DATE: Nov. 24, 1962

Division of Collection and Receipts
COURT HOUSE
TOWSON, MARYLAND 21204

BILLED BY:

To: James F. Offutt, Jr., Esq.
107 Jefferson Building
Towson, Md. 21204

Zoning Dept. of Baltimore County

REPORT TO ACCOUNT NO. 01-622 RETURN THIS PORTION WITH YOUR REMITTANCE

DETACH ALONG PERFORATION AND KEEP THIS PORTION FOR YOUR RECORDS

QUANTITY 1.00 COST \$50.00

Petition for Reclassification for Marvin D. Kolker 770-113-R 50.00

4

IMPORTANT: MAKE CHECKS PAYABLE TO BALTIMORE COUNTY, MARYLAND

MAIL TO DIVISION OF COLLECTION & RECEIPTS, COURT HOUSE, TOWSON, MARYLAND 21204