PETATON FOR ZONING VARIANCE FROM AREA AND HEIGHT REGULATIONS

TO THE BONING COMMISSIONER OF BALTIMORE COUNTY:

for a Variance from Section 1809. 30 (214-1b) to possit a sidepend outland of five (5) feet in lim of the required fifteen (15) foot.

of the Zoning Regulations of Baltimore County, to the Zoning Law of Baltimore County; for the following reasons: (indicate hardship or practical difficulty)

Property is to be posted and advertised as prescribed by Zoning Regulations.

J. or we, agree to pay expenses of above Variance advertising, poeting, etc., upon filing of this don, and further agree to and are to be bound by the zoning regulations and restrictions of home County standard surresult is the National County of the County of

My Day Hest Legal Owner Asserts 3227 Karales Had Bell 2/217

Protestant's Attorney

Su 6-B

12175

11-26-7

76-R-A

1975 at 10:45 o'clock

OFFICE OF PLANIAG & ZONING

October 21, 1975

Mr. & Mrs. Roy Herb Jr. 3227 Kessler Road Baltimore, Maryland 21227

RE: Petition for Variance E/S of Kessler Road, 290' N of Caledoula Avenue - 13th Election District Roy Herb, Jr., et ux - Petitioners NO. 76-86-A (Item No. 52)

Dear Mr. & Mrs. Herbi

I have this date passed my Order in the above captioned matter in

Very trois yours, S. ERIC DI NENNA

SED/me

ce: John W. Hessian, III, Esquire People's Counsel

BEFORE THE ZONING COMMISSIONE

...... ORDER TO ENTER APPEARANCE

plead in Section 524, I of the Buildings County Charter

I heraby certify that on this 8th day of October, 1975, a capy of the foregoing Order ed to Mr. Rey Herb, Jr., 3227 Kassler Road, Baltimere, Maryland 21227, Patti

John W. Hessian III

TA AVERSE AND ENDER AS 107 \$ 56 AS SHOWS ON PLAY OF REVIEWED

13th District

William D. Fromm, Director of Planning

HEARING: Monday, October 20, 1975 (10:45 A.M.)

The staff of the Office of Planning and Zoning will offer no comment on this patition at this time.

East side of Kessler Road 290 feet, more or less, north of Caledonia Avenue Petitioner - Roy Herb, Jr.

BALTIMORE COUNTY, MARTLAND

TO 5. Eric DiMenna, Zoning Commissioner Date October 15, 1975

SUBJECT Petition #76-86-A. Petition for Variance for a Side Yard.

William D. Fromm Director of Planning

WDF :NEG : rw



. Ben

BALTIMORE COUNTY ZONING PLANS ADVISORY COMMITTEE

October 6, 1975

COUNTY OFFICE BUILDING 111 W. Chesapeake Avenue Towson, Haryland 21204

REFERENCES Franklin T.

PROPERTY HEALTH DEPARTMENT BUREAU CF FIRE PREVENTION

DEPARTMENT OF TRAFFIC ENGINEERS STATE BIGHWAY

BUREAU OF ENGINEERING PROJECT AND DEVELOPMENT PLANNING

INDUSTRIAL DEVELOPMENT COMMISSION BOARD OF EDUCATION OFFICE OF THE

The enclosed comments are to be included with the Zoning Plans Advisory Committee comments sent you between 17, 1975 under the above referenced subject.

Very truly yours,

Franklin T. Hogans, Jr. Chairman, Zoring Plans Advisory Committee

FTH:JD Enclosure Benartment Of Bublit Borbs COUNTY OFFICE BUILDING

September 29, 1975

Mr. 5. Brie Dillenne . Zoning Commissioner County Office Building Towson, Maryland 2120h

Item #52 (1975-1976)
Property Owner: Hr. and Hrs. Roy Herb, Jr.
E/s of Mescler Hd., 200 N.cf Caladomia Are.
Existing Zoming: D.R. 10.5
Proposed Zoming: Variance from Sec. 1802,38 (214,1b)
to permit a side yard setback of 5° in lieu of the
required 15°.
Restricts 13th

The following comments are furnished in regard to the plat submitted to this office review by the Zoning Advisory Countities in connection with the subject item.

Baltimore County utilities and highway improvements are not directly involved. Additional fire hydrant protection may be required in the vicinity.

ELLSWORTH N. DIVER, P.E. Chief, Bureau of Engineering

END: BAM: FWR: BE

cc: W. Munchel

C-WE Key Sheet 23 SW 6 Pos. Sheet SW 6 B Topo 109 Tax Map

Mr. Ray Herb. 3227 Herales Ad. Balto, County, 21227 to start my room additition as soon as possible, I take full pinancial Respondition on the thirty day period



DEC 1 5 1975

BALTIMORE COUNTY ZONING PLANS ADVISORY COMMITTEE

Mr. Roy Herb, Jr., 3227 Kessler Road Baltimore, Maryland 21227

Dear Mr. Herb:

ranklin T. Hogans Chairman Jr.

MEMBERS ZOWING ADMINISTRATIO HEALTH DEPARTMENT BUREAU OF FIRE PREVENTION

PROJECT AND DEVELOPMENT PLANS

BOARD OF EDUCATION OFFICE OF THE

DEPARTMENT OF TRAFFIC ENGINEERIN STATE HIGHWAY ADMINISTRATION BUREAU OF

The Zoning Plans Advisory Committee has reviewed the plans submitted with the above referenced petition and has made an on site field inspection of the property. The following comments are a result of this review and inspection.

RE: Variance Petition
Item 52
Mr. & Mrs. Roy Herb, Jr. Petitioners

September 17, 1975

These comments are not intended to indicate the appropriateness of the zoning action requested, but to assure that all parties are made aware of plans or problems with regard to the development plans that may have a bearing on this case. The Director of Planning may file a written report with the Zoning Commissioner with recommendations as to the appropriateness of the requested zoning.

The subject property, currently zoned D.R. 10.5, is located on the east side of Kessler Road, approximately 290 feet north of the intersection of Caledonia Avenue and Kessler Road.

The petitioner is requesting a side yard Variance of 5 feet in lieu of the required 15 feet to construct a 10'x25' addition to the side of the existing end of group residence. Group homes exist along the east side of Kessler Road with the Riverview Elementary School directly opposite the subject property.

As indicated on the revised site plan, a similar type addition was constructed on the dwelling

BALTIMORE COUNTY

ADVISORY COMMITTEE

ZONING PLANS



PETITION AND SITE PLAN

EVALUATION COMMENTS

Mr. Roy Herb, Jr., Item 52 September 17, 1975 Page 2

located at 3229 Kessler Road within the past two months; however, the required setback was maintained.

This petition is accepted for filing on the date of the enclosed filing certificate. Notice of the hearing date and time, which will be held not less than 30, nor more than 90 days after the date on the filing certificate, will be forwarded to you in the near future.

Very truly yours, Michola B. Commoderi NICHOLAS B. COMMODARI,

NBC:JD Enclosure

BALTIMORE COUNTY, MARYLAND DEPARTMENT OF HEALTH-



September 8, 1975

Mr. S. Eric DiNenna, Zoning Commissioner Office of Planning and Zoning County Office Building Towson, Maryland 21204

Dear Mr. DiNenna:

Comments on Item #52, Zoning Advisory Committee Heeting, September 9, 1975, are as follows:

Property Owner: Hr. and Mrs. Roy Herb, Jr.
Location: E/S of Kessler Rd. 290' N of Caledonia Ave.
Existing Zoning: D.R. 10.5
Proposed Zoning: Variance from Sec. 1802.38 (214.1b)
to permit a sideyard setback of 5' in
lieu of the required 15'.

Since this is a variance for an addition to an existing dwelling and public water and sever exist, no health hazard is

Very truly yours,

Thom A. Done

Thomas H. Devlin, Director BUREAU OF ENVIRONMENTAL SERVICES

&HVB:dlse

BALTIMORE COUNTY, MARYLAND



WM. T. MELIER

DEPARTMENT OF TRAFFIC ENGINEERING

Stephen E. Collins

September 15, 1975

Mr. S. Eric DiMenna Zoning Commissioner County Office Building Townon, Maryland 21204

Itam 52 - ZAC - September 9, 1975
Property Owner: Rr. 6 Mrs. Roy Herb, Jr.
Location: E/S of Kessler Rd. 290' N of Caledonia Ave.
Existing Zoning: D.s. 20.5 for Sec. 1802.38 (214.1b) to
permit a sideyard setback of five feet in
lieu of the required fifteen feet.

No traffic problems are anticipated by the requested variance to the sideward.

Very truly yours, Michael S. He

Michael S. Flanigan Traffic Engineer Associ



September 22, 1975

Mr. S. Eric Di Nenna, Zoning Commissi Zoning Advisory Committee
Office of Planning and Zoning
Baltimore County Office Building
Towson, Maryland 21204

Comments on Item #52, Zoning Advisory Committee Meeting, September 9, 1975, are as follows

Property Owner: Mr. and Mrs. Roy Herb, Jr.
Lacation: E/S of Kessler Road 290' N. of Caledonia Avenue
Existing Zoning: D. R. 10.5
Proposed Zoning: Variance from Sec. 1802,38 (214.1b) to permit a sideyard setback of five
No. of Acres


This office has reviewed the subject petition and offers the following comments. These comments are not intended to indicate the appropriateness of the zoning in question, but are to assure that all parties are made aware of plans or problems with regard to development plans that may have a bearing on this petition.


This plan has been reviewed and there are no site-planning factors requiring comment.


Very truly yours,

John ZWimbles John L. Wimbley
Planning Specialist II
Project and Development Planning

BALTIMORE COUNTY OFFICE OF PLANNING AND ZONING LDING 105 WEST CHESAPEAKE AVENUE TOWSON, MARYLAND 21204
AREA CODE 301 PLANNING 484-3211 ZOMINC 494-3381

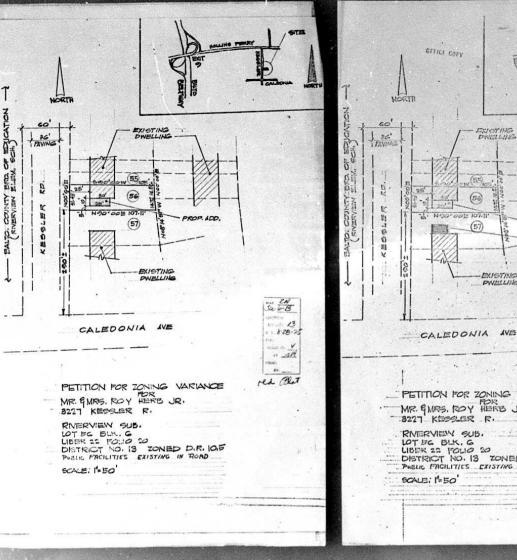

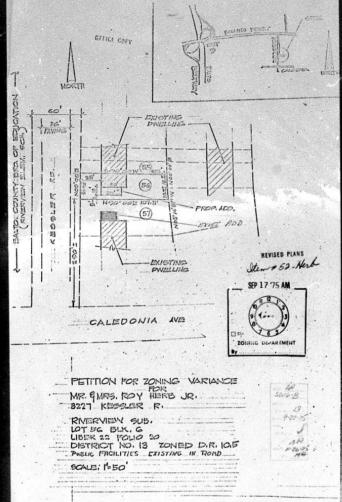

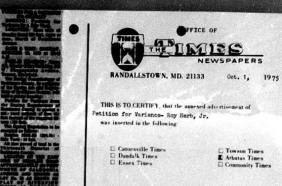

week for one succession weeks before the 20th day of October 19 75, that it to say, the same was inserted in the issues of October 1, 1975.

STROMBERG PUBLICATIONS, INC.

BY E.P. Smik



CERTIFICATE OF PUBLICATION

L. Leanh Structure

-	1
<u>:</u>	
	TENES.

BALTIMORE COUNTY, MARYLAND OFFICE OF FINANCE: REVENUE DIVISION MISCELLANEOUS CASH RECEIPT	m. 25932
DATE 600. 20, 1975 ACCOUNT 02-66	
AMOUNT #5	5
RECEIVED Bur Burb, Jr. (Cont.)	
ron Mountining and posting of	tenaty
1988 4 98 to 10	4 5.2 5 ASC
VALIDATION OR SIGNATURE OF	CASHIER

76-86-A 1-SIGN

CERTIFICATE OF POSTING ING DEPARTMENT OF BALTIMORE COUNTY

13th	Dute of Posting OCT, 4,1975 OR VARIANCE. JR. Kessler Rd. 290' N eF (Aledonia Ave.
PETITION F	on VARIANCE
Roy HERA	TR
Tetitioner (104 Trens)+	Kessler Rd. 290' NOF CALEDONIA AVE.
Location of property E/S Cr.	11070700
ocation of Signs FRELT	3227 Kessker Rd.

Posted by Thomas To Robert

	h 4							
Date	of	retu	rn (م رد	Τ.	16	.19	25

PETITION	M	APPI	NG	PRC	GRE	SS	SHE	ET		
	Wall	Мар	Orig	inal	Dupl	icate	Tro	cing	200	Shee
FUNCTION	date	by	date	by	date	by	date	by	date	by
Descriptions checked and outline plotted on map										
Petition number added to outline										
Denied										
Granted by ZC, BA, CC, CA										
Reviewed by: 71.B.C.					ed Pla ge in o		or des	sc ript	ion	
Previous case:				Мар						-00.0

BALTIMORE	COUNTY	OFFICE	OF	PLANNING	AND	ZONING	
	County	Office	B 1	uilding			

111 W. Chesapeake Avenue Towson, Maryland 21204

Your Petition has been received * this 27 day of 1975. Filing Fee \$____ Cash

Reviewed by MBL Petitioner's Attorney____ * This is not to be interpreted as acceptance of the Petition for assignment of a hearing date.

Petitioner MR. HERB

BALTIMORE COUNTY, MARY AND OFFICE OF FINANCE REVENUE DIVID MISCELLANEOUS CASH RECEIPT	m. 23349
DATE ANS. 27, 1975 . ACCOUNT 03-6	4
AMOUNT_ 854	•
neceived Thomas Swisher, 914 S, Rayler	Palto, Ma. 21224
Petition for Variance for key lie	