

83-283-A
PETITION FOR ZONING VARIANCE
TO THE ZONING COMMISSIONER OF BALTIMORE COUNTY:

The undersigned, legal owner(s) of the property situate in Baltimore County and which is described in the description and plat attached hereto and made a part hereof, hereby petition for a Variance from Section 400.1 to permit an existing accessory structure to be located in the front yard in lieu of required rear yard.

of the Zoning Regulations of Baltimore County, to the Zoning Law of Baltimore County, for the following reasons: (Indicate hardship or practical difficulty)

Demolition of the pavilion would be extremely expensive and hopes and dreams of the property would be destroyed.

Property is to be posted and advertised as prescribed by Zoning Regulations.

I, or we, agree to pay expenses of above Variance advertising, posting, etc., upon filing of this petition, and further agree to and are to be bound by the zoning regulations and restrictions of Baltimore County adopted pursuant to the Zoning Law For Baltimore County.

I/We do solemnly declare and affirm, under the penalties of perjury, that I/we are the legal owner(s) of the property which is the subject of this Petition.

Contract Purchaser:	Legal Owner(s):
(Type or Print Name)	Steven R. Shores
Signature	Signature
Address	(Type or Print Name)
City and State	Signature
Attorney for Petitioner:	3921 New Section Road 574-0466
(Type or Print Name)	Address Phone No.
Signature	Baltimore, Maryland 21220
Address	City and State
City and State	Name, address and phone number of legal owner, contract purchaser or representative to be contacted
Attorney's Telephone No.:	Name
Address	Phone No.

ORDERED By The Zoning Commissioner of Baltimore County, this 5th day of April 1983, that the subject matter of this petition be advertised, as required by the Zoning Law of Baltimore County, in two newspapers of general circulation throughout Baltimore County, that property be posted, and that the public hearing be had before the Zoning Commissioner of Baltimore County in Room 106, County Office Building in Towson, Baltimore County, on the 21st day of June 1983, at 9:30 o'clock A.M.

John W. Hession, III
Zoning Commissioner of Baltimore County.

(over)

83-283-A
PETITION FOR ZONING VARIANCE
TO THE ZONING COMMISSIONER OF BALTIMORE COUNTY:

The undersigned, legal owner(s) of the property situate in Baltimore County and which is described in the description and plat attached hereto and made a part hereof, hereby petition for a Variance from Section 400.1 to permit an existing accessory structure to be located in the front yard in lieu of required rear yard.

of the Zoning Regulations of Baltimore County, to the Zoning Law of Baltimore County, for the following reasons: (Indicate hardship or practical difficulty)

Demolition of the pavilion would be extremely expensive and hopes and dreams of the property would be destroyed.

Property is to be posted and advertised as prescribed by Zoning Regulations.

I, or we, agree to pay expenses of above Variance advertising, posting, etc., upon filing of this petition, and further agree to and are to be bound by the zoning regulations and restrictions of Baltimore County adopted pursuant to the Zoning Law For Baltimore County.

I/We do solemnly declare and affirm, under the penalties of perjury, that I/we are the legal owner(s) of the property which is the subject of this Petition.

Contract Purchaser:	Legal Owner(s):
(Type or Print Name)	Steven R. Shores
Signature	Signature
Address	(Type or Print Name)
City and State	Signature
Attorney for Petitioner:	3921 New Section Road 574-0466
(Type or Print Name)	Address Phone No.
Signature	Baltimore, Maryland 21220
Address	City and State
City and State	Name, address and phone number of legal owner, contract purchaser or representative to be contacted
Attorney's Telephone No.:	Name
Address	Phone No.

ORDERED By The Zoning Commissioner of Baltimore County, this 5th day of April 1983, that the subject matter of this petition be advertised, as required by the Zoning Law of Baltimore County, in two newspapers of general circulation throughout Baltimore County, that property be posted, and that the public hearing be had before the Zoning Commissioner of Baltimore County in Room 106, County Office Building in Towson, Baltimore County, on the 21st day of June 1983, at 9:30 o'clock A.M.

John W. Hession, III
Zoning Commissioner of Baltimore County.

(over)

83-283-A
PETITION FOR ZONING VARIANCE
TO THE ZONING COMMISSIONER OF BALTIMORE COUNTY:

The undersigned, legal owner(s) of the property situate in Baltimore County and which is described in the description and plat attached hereto and made a part hereof, hereby petition for a Variance from Section 400.1 to permit an existing accessory structure to be located in the front yard in lieu of required rear yard.

of the Zoning Regulations of Baltimore County, to the Zoning Law of Baltimore County, for the following reasons: (Indicate hardship or practical difficulty)

Demolition of the pavilion would be extremely expensive and hopes and dreams of the property would be destroyed.

Property is to be posted and advertised as prescribed by Zoning Regulations.

I, or we, agree to pay expenses of above Variance advertising, posting, etc., upon filing of this petition, and further agree to and are to be bound by the zoning regulations and restrictions of Baltimore County adopted pursuant to the Zoning Law For Baltimore County.

I/We do solemnly declare and affirm, under the penalties of perjury, that I/we are the legal owner(s) of the property which is the subject of this Petition.

Contract Purchaser:	Legal Owner(s):
(Type or Print Name)	Steven R. Shores
Signature	Signature
Address	(Type or Print Name)
City and State	Signature
Attorney for Petitioner:	3921 New Section Road 574-0466
(Type or Print Name)	Address Phone No.
Signature	Baltimore, Maryland 21220
Address	City and State
City and State	Name, address and phone number of legal owner, contract purchaser or representative to be contacted
Attorney's Telephone No.:	Name
Address	Phone No.

ORDERED By The Zoning Commissioner of Baltimore County, this 5th day of April 1983, that the subject matter of this petition be advertised, as required by the Zoning Law of Baltimore County, in two newspapers of general circulation throughout Baltimore County, that property be posted, and that the public hearing be had before the Zoning Commissioner of Baltimore County in Room 106, County Office Building in Towson, Baltimore County, on the 21st day of June 1983, at 9:30 o'clock A.M.

John W. Hession, III
Zoning Commissioner of Baltimore County.

(over)

RE: PETITION FOR VARIANCE : BEFORE THE ZONING COMMISSIONER
5/5 of New Section Rd., : OF BALTIMORE COUNTY
601.7' NE of Seneca Rd.,
15th District
STEVEN R. SHORES,
Petitioner : Case No. 83-283-A

ORDER TO ENTER APPEARANCE

Mr. Commissioner:

Pursuant to the authority contained in Section 524.1 of the Baltimore County Charter, I hereby enter my appearance in this proceeding. You are requested to notify me of any hearing date or dates which may be now or hereafter designated therefor, and of the passage of any preliminary or final Order in connection therewith.

Peter Max Zimmerman John W. Hession, III
Deputy People's Counsel People's Counsel for Baltimore County
Rm. 223, Court House
Towson, Maryland 21204
494-2188

I HEREBY CERTIFY that on this 10th day of June, 1983, a copy of the foregoing Order was mailed to Mr. Steven R. Shores, 3921 New Section Road, Baltimore, MD 21220, Petitioner.

John W. Hession, III
John W. Hession, III

BALTIMORE COUNTY

ZONING PLANS

ADVISORY COMMITTEE



PETITION AND SITE PLAN

EVALUATION COMMENTS

BALTIMORE COUNTY, MARYLAND

INTER-OFFICE CORRESPONDENCE

William E. Hammond
TO: Zoning Commissioner Date: May 31, 1983
Norman E. Gerber, Director
FROM: Office of Planning and Zoning
Zoning Petition No. 83-283-A
SUBJECT: Steven R. Shores

There are no comprehensive planning factors requiring comment on this petition.

Norman E. Gerber
Norman E. Gerber
Director of Planning and Zoning

NEGJGH:lc

cc: Arlene January
Shirley Hess

Mr. Steven R. Shores
3921 New Section Road
Baltimore, Maryland 21220

BALTIMORE COUNTY OFFICE OF PLANNING & ZONING


County Office Building
111 W. Chesapeake Avenue
Towson, Maryland 21204

Your Petition has been received and accepted, for filing this 5th day of April 1983.

William E. Hammond
WILLIAM E. HAMMOND
Zoning Commissioner

Petitioner: Steven R. Shores
Petitioner's Attorney: Reviewed by: Nicholas B. Commodari
Chairman, Zoning Plans
Advisory Committee

Steven R. Shores
3921 New Section Rd.
Baltimore, Md. 21220
Open Pavilion:
Total Height - 13'10 1/2"

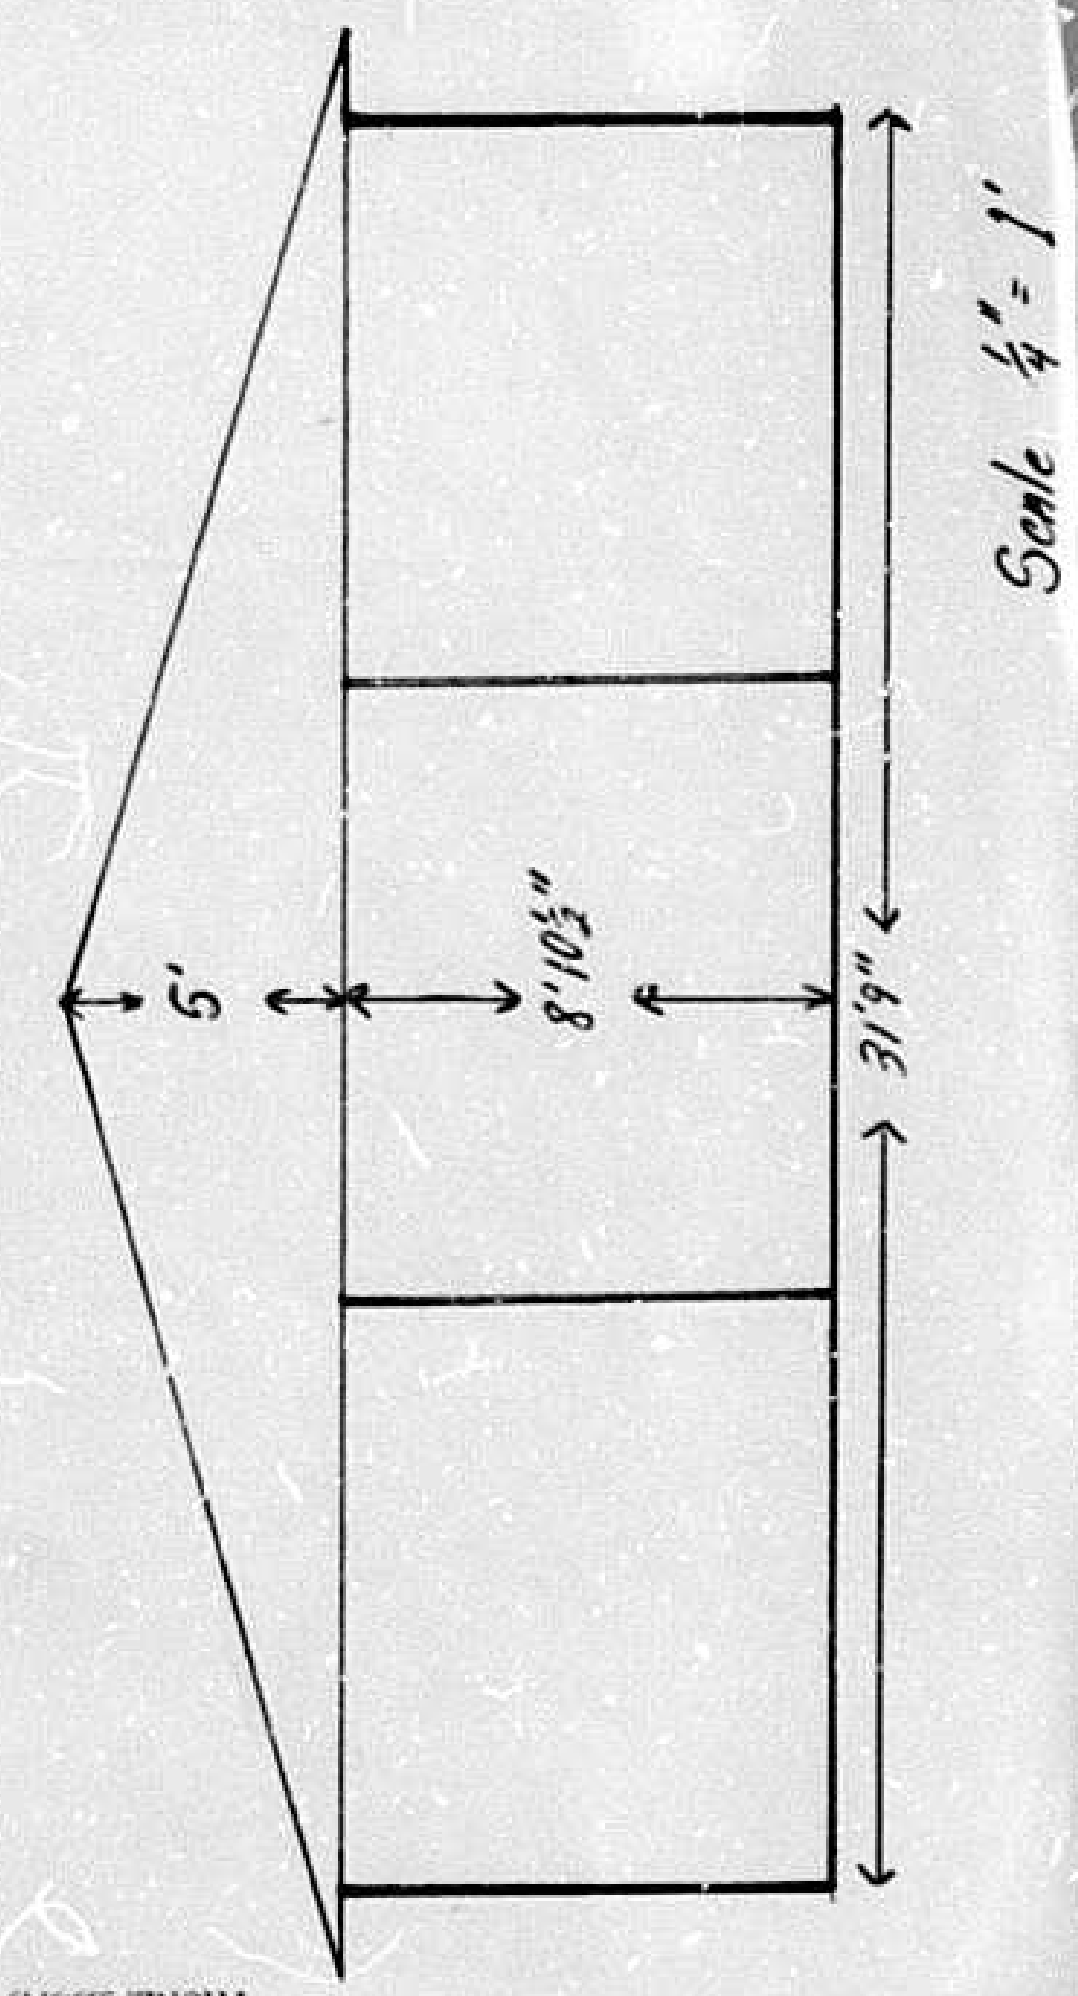

Pursuant to the advertisement, posting of property, and public hearing on the Petition and it appearing that strict compliance with the Baltimore County Zoning Regulations would/would not result in practical difficulty and unreasonable hardship upon the Petitioner(s) and the granting of the variance(s) requested will/will not adversely affect the health, safety, and general welfare of the community, the variance(s) should /should not be granted.

Therefore, IT IS ORDERED by the Deputy Zoning Commissioner of Baltimore County, this 24TH day of June, 1983, that the herein Petition for Variance(s) to permit an existing accessory structure, a 30' x 32' open pavilion, to be located in the front yard in lieu of the required rear yard, in accordance with the site plan filed herein, is hereby GRANTED, from and after the date of this Order, subject, however, to the following restrictions:

1. The open pavilion shall not be enclosed by walls, glass, screening, etc.
2. Approval of the aforementioned site plan by the Department Of Public Works and the Office of Planning and Zoning.

Jean M. H. Jung
Deputy Zoning Commissioner of
Baltimore County

Pursuant to the advertisement, posting of property, and public hearing on the Petition and it appearing that strict compliance with the Baltimore County Zoning Regulations would/would not result in practical difficulty and unreasonable hardship upon the Petitioner(s) and the granting of the variance(s) requested will/will not adversely affect the health, safety, and general welfare of the community, the variance(s) should /should not be granted.

Therefore, IT IS ORDERED by the Deputy Zoning Commissioner of Baltimore County, this 24TH day of June, 1983, that the herein Petition for Variance(s) to permit an existing accessory structure, a 30' x 32' open pavilion, to be located in the front yard in lieu of the required rear yard, in accordance with the site plan filed herein, is hereby GRANTED, from and after the date of this Order, subject, however, to the following restrictions:

1. The open pavilion shall not be enclosed by walls, glass, screening, etc.
2. Approval of the aforementioned site plan by the Department Of Public Works and the Office of Planning and Zoning.


Jean M. H. Jung
Deputy Zoning Commissioner of
Baltimore County

Pursuant to the advertisement, posting of property, and public hearing on the Petition and it appearing that strict compliance with the Baltimore County Zoning Regulations would/would not result in practical difficulty and unreasonable hardship upon the Petitioner(s) and the granting of the variance(s) requested will/will not adversely affect the health, safety, and general welfare of the community, the variance(s) should /should not be granted.

Therefore, IT IS ORDERED by the Deputy Zoning Commissioner of Baltimore County, this 24TH day of June, 1983, that the herein Petition for Variance(s) to permit an existing accessory structure, a 30' x 32' open pavilion, to be located in the front yard in lieu of the required rear yard, in accordance with the site plan filed herein, is hereby GRANTED, from and after the date of this Order, subject, however, to the following restrictions:

1. The open pavilion shall not be enclosed by walls, glass, screening, etc.
2. Approval of the aforementioned site plan by the Department Of Public Works and the Office of Planning and Zoning.

Jean M. H. Jung
Deputy Zoning Commissioner of
Baltimore County

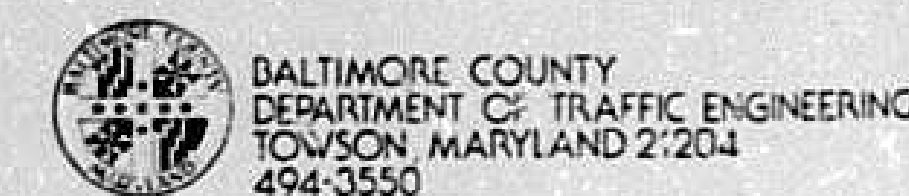

STEPHEN E. COLLINS
DIRECTOR

June 23, 1983

Mr. William Hammond
Zoning Commissioner
County Office Building
Towson, Maryland 21204

Item No. 198, 200, 201, 202, 203, and 205
Property Owner:
Location:
Existing Zoning:
Proposed Zoning:

Acres:
District:


Dear Mr. Hammond:

The Department of Traffic Engineering has no comments for item numbers 198, 200, 201, 202, 203, and 205.

Michael S. Flanigan
Michael S. Flanigan
Traffic Engineer Assoc. II

MSF/ccm

83-203-A
6/21/83
Shaw

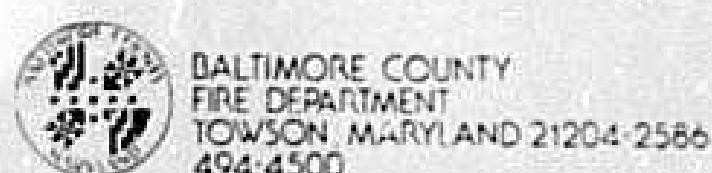

PAUL H. REINCKE
CHIEF

Mr. William Hammond
Zoning Commissioner
Office of Planning and Zoning
Baltimore County Office Building
Towson, Maryland 21204

Attention: Nick Commodari, Chairman
Zoning Plans Advisory Committee

RE: Property Owner: Steven R. Shores

Location: S/S New Section Road 601.7' N/E of Seneca Road

Item No.: 205

Zoning Agenda: Meeting of April 5, 1983

Gentlemen:

Pursuant to your request, the referenced property has been surveyed by this Bureau and the comments below marked with an "X" are applicable and required to be corrected or incorporated into the final plans for the property.

- () 1. Fire hydrants for the referenced property are required and shall be located at intervals or _____ feet along an approved road, in accordance with Baltimore County Standards as published by the Department of Public Works.
- () 2. A second means of vehicle access is required for the site.
- () 3. The vehicle design and condition shown at _____ EXCEEDS the maximum allowed by the Fire Department.
- () 4. The site shall be made to comply with all applicable parts of the Fire Prevention Code prior to occupancy or beginning of operation.
- () 5. The buildings and structures existing or proposed on the site shall comply with all applicable requirements of the National Fire Protection Association Standard No. 101 "Life Safety Code", 1976 Edition prior to occupancy.
- () 6. Site plans are approved, as drawn.
- (y) 7. The Fire Prevention Bureau has no comments, at this time.

REVIEWER: *PAUL H. REINCKE* Approved and
Planning Group
Special Inspection Division

/mb

BALTIMORE COUNTY ZONING PLANS ADVISORY COMMITTEE

June 10, 1983

Mr. Steven R. Shores
3921 New Section Road
Baltimore, Maryland 21220

650
Nicholas B. Commodari
Chairman

MEMBERS
Bureau of Engineering
Department of Traffic Engineering
State Roads Commission
Bureau of Fire Prevention
Health Department
Project Planning
Building Department
Board of Education
Zoning Administration
Industrial Development

RE: Case #83-283-A (Item No. 205)
Petitioner - Steven R. Shores
Variance Petition

Dear Mr. Shores:

The Zoning Plans Advisory Committee has reviewed the plans submitted with the above referenced petition. The following comments are not intended to indicate the appropriateness of the zoning action requested, but to assure that all parties are made aware of plans or problems with regard to the development plans that may have a bearing on this case. The Director of Planning may file a written report with the Zoning Commissioner with recommendations as to the suitability of the requested zoning.

In view of your proposal to legalize the location of the existing pavilion, located in the front yard, this variance is required.

As you are aware this property has been the subject of three previous zoning hearings (Case #72-246-A, #74-24-A and #82-44-A). The first hearing granted variances to convert this structure to a dwelling, while the remaining two hearings denied requests to allow this structure to remain as an accessory building in the front yard.

At the time of field inspection, the walls of this structure were removed, and it was your feeling that this would make a difference in your request.


Enclosed are all comments submitted from the members of the Committee at this time that offer or request information on your petition. If similar comments from the remaining members are received, I will forward them to you. Otherwise, any comment that is not informative will be placed in the hearing file. This petition was accepted for filing on the date of the enclosed filing certificate and a hearing, scheduled accordingly.

Very truly yours,

Nicholas B. Commodari
NICHOLAS B. COMMODARI
Chairman
Zoning Plans Advisory Committee

NBC:cmh

Enclosures

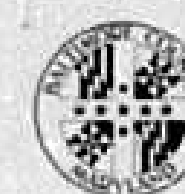

BALTIMORE COUNTY
DEPARTMENT OF PUBLIC WORKS
TOWSON, MARYLAND 21204

HARRY J. PISTEL, P.E.
DIRECTOR

May 6, 1983

Mr. William E. Hammond
Zoning Commissioner
County Office Building
Towson, Maryland 21204

Re: Item #205 (1982-1983)
Property Owner: Steven R. Shores
S/S New Section Rd. 601.7' N/E of Seneca Rd.
Acres: 98.5/125 X 406/316.24
District: 15th

Dear Mr. Hammond:

The following comments are furnished in regard to the plat submitted to this office for review by the Zoning Advisory Committee in connection with the subject item.

General:

The comments supplied in conjunction with the Zoning Advisory Committee review of this property in connection with Items 117 (1971-1972), 245 (1972-1973) and 236 (1980-1981) are referred to for your consideration.

This property is within the Baltimore County Metropolitan District and beyond the Comprehensive Metropolitan Facilities Planning Area. Baltimore County Water Supply and Sewerage Plan W and S-23B, as amended through January 1982, indicate respectively, "Existing Service" and "No Planned Service" in the area.

This office has no further comment in regard to the plan submitted for Zoning Advisory Committee review in connection with this item 205 (1982-1983).

Very truly yours,

Robert A. Morton
ROBERT A. MORTON, P.E., Chief
Bureau of Public Services

RAM:EAM:FWR:iss

2-SW Key Sheet
7 & 8 NE 46 & 47 Pos. Sheets
NE 2 L Topo
91 Tax Map

July 13, 1981

Mr. William E. Hammond
Zoning Commissioner
County Office Building
Towson, Maryland 21204

Re: Item #236 (1980-1981)
Property Owner: James A. & Patricia A. Baker
S/S New Section Road 601.7' N/E of S. Seneca Rd.
Acres: 98.5/124.5 X 406.0/316.24
District: 15th

Dear Mr. Hammond:

The following comments are furnished in regard to the plat submitted to this office for review by the Zoning Advisory Committee in connection with the subject item.

General:

Baltimore County highway and utility improvements are not directly involved.

The comments which were supplied in connection with the Zoning Advisory Committee review for Item 117 (1971-1972) and 245 (1972-1973) are referred to for your consideration.

This office has no further comment in regard to the plan submitted for Zoning Advisory Committee review in connection with this item 236 (1980-1981).

Very truly yours,

(SIGNED) EDWARD A. MCDONOUGH
ROBERT A. MORTON, P.E., Chief
Bureau of Public Services

RAM:EAM:FWR:iss

cc: Jack Wimbley

2-SW Key Sheet
7 & 8 NE 46 & 47 Pos. Sheets
NE 2 L Topo
91 Tax Map

Attachments

Baltimore County, Maryland
Department Of Public Works
COUNTY OFFICE BUILDING
TOWSON, MARYLAND 21204

July 16, 1973

BALTIMORE COUNTY, MARYLAND

INTER-OFFICE CORRESPONDENCE

TO: S. Eric DiMenna
ATTN: Oliver L. Myers
FROM: Ellsworth N. Diver, P.E.

Date: February 3, 1972

SUBJECT: Item #117 (1971-1972)
Property Owner: William T. Tomlinson
S/S New Section Road, 505' E. of Seneca Road
Present Zoning: R.D.P.
Proposed Zoning: Variance from Section 1400.3B (3) - front and side yards
District: 15th
No. Acres: 100' x 400'

The following comments are furnished in regard to the plat submitted to this office for review by the Zoning Advisory Committee in connection with the subject item.

Highways:

New Section Road, an existing public road, is proposed to be improved in the future as a 30-foot closed-type roadway cross-section on a 50-foot right-of-way. Highway improvements are not required at this time. Highway right-of-way and widening of varying width in respect to this property, will be required in connection with any grading or building permit application. The plan should be revised to indicate the proposed highway right-of-way widening as shown in red on the attached plan.

In the event this property is intended to be subjected to other than residential use, the entrance location will be subject to approval by the Department of Traffic Engineering, and shall be constructed in accordance with Baltimore County Standards.

Sediment Control:

Development of this property through stripping, grading and stabilization could result in a sediment pollution problem, damaging private and public holdings downstream of the property. A grading permit is, therefore, necessary for all grading, including the stripping of top soil.

Storm Drains:

The Petitioner must provide necessary drainage facilities (temporary or permanent) to prevent creating any nuisances or damages to adjacent properties, especially by the concentration of surface waters. Correction of any problem which may result, due to improper grading or improper installation of drainage facilities, would be the full responsibility of the Petitioner.

Item #117 (1971-1972)
Property Owner: William T. Tomlinson
Page 2
February 3, 1972

Storm Drains: (Cont'd)

The property to be developed is located adjacent to the water front. The Petitioner is advised that the proper sections of the Baltimore County Building Code must be followed whereby elevation limitations are placed on first floor levels of residential or commercial development and other special construction features are required.

Water:

Public water supply is available to serve this property.

Sanitary Sewer:

Public sanitary sewerage is not available to serve this property which is utilizing private onsite sewerage.

Ellsworth N. Diver

ELLSWORTH N. DIVER, P.E.
Chief, Bureau of Engineering

END:EAM:FWR:es

Attachment

cc: John A. Somers

Z-SW Key Sheet
8 NE 46 & 47 Position Sheet
NE 2 L Topo
91 Tax Map

Bureau of Engineering
ELLSWORTH N. DIVER, P.E. CHIEF

Mr. S. Eric DiMenna
Zoning Commissioner
County Office Building
Towson, Maryland 21204

Re: Item #245 (1972-1973)
Property Owner: William T. Tomlinson
New Section Road, 505' E. of Seneca Road
Present Zoning: R.D.P.
Proposed Zoning: Variance from Section 1400.1 to permit an accessory building in the front yard (waterfront) instead of the required rear yard
District: 15th No. Acres: 0.80 acre

Dear Mr. DiMenna:

The following comments are furnished in regard to the plat submitted to this office for review by the Zoning Advisory Committee in connection with the subject item.

General:

The comments supplied for this property in connection with Item #117 (1971 - 1972) remain valid and applicable to this Item #245 (1972 - 1973). Those comments are referred to for your consideration.

Very truly yours,

Ellsworth N. Diver
ELLSWORTH N. DIVER, P.E.
Chief, Bureau of Engineering

END:EAM:FWR:es

Z-SW Key Sheet
8 NE 46 & 47 Pos. Sheets
NE 2 L Topo
91 Tax Map

Zoning Item # 205
Page 2

- () Any existing underground storage tanks containing gasoline, waste oil, solvents, etc., must have the contents removed by a licensed hauler and either be removed from the property or properly backfilled.
- () Soil percolation tests have been conducted.
 - () The results are valid until _____
 - () Revised plans must be submitted prior to approval of the percolation tests.
- () Prior to occupancy approval, the potability of the water supply must be verified by collection of bacteriological and chemical water samples.
- () In accordance with Section 13-117 of the Baltimore County Code, the water well yield test
 - () shall be valid until _____
 - () is not acceptable and must be retested. This must be accomplished prior to conveyance of property or approval of Building Permit Applications.
- () All roads and parking areas should be surfaced with a dustless, bonding material.
- () No health hazards are anticipated.
- (X) Others The proposed accessory structure will not interfere with the location of the sewage disposal system.

John J. Forrest
John J. Forrest, Director
BUREAU OF ENVIRONMENTAL SERVICES

BALTIMORE COUNTY DEPARTMENT OF HEALTH

Zoning Commissioner
Office of Planning and Zoning
County Office Building
Towson, Maryland 21204

Zoning Item # 205, Zoning Advisory Committee Meeting of April 5, 1983

Property Owner: Steven R. Shores

Location: S/S New Section Road District 15

Water Supply Public Sewage Disposal Private

COMMENTS ARE AS FOLLOWS:

- () Prior to approval of a Building Permit for construction, renovation and/or installation of equipment for any existing or proposed food service facility, complete plans and specifications must be submitted to the Plans Review Section, Environmental Support Services, for final review and approval.
- () Prior to new installation/s of fuel burning equipment, the owner should contact the Division of Air Pollution Control, 494-3775, to obtain requirements for such installation/s before work begins.
- () A permit to construct from the Division of Air Pollution Control is required for such items as spray paint processes, underground gasoline storage tank/s (5,000 gallons or more) and any other equipment or process which exhausts into the atmosphere.
- () A permit to construct from the Division of Air Pollution Control is required for any charbroiler operation which has a total cooking surface area of five (5) square feet or more.
- () Prior to approval of a Building Permit Application for renovations to existing or construction of new health care facilities, complete plans and specifications of the building, food service area and type of equipment to be used for the food service operation must be submitted to the Plans Review and Approval Section, Division of Engineering and Maintenance, State Department of Health and Mental Hygiene for review and approval.
- () Prior to any new construction or substantial alteration of public swimming pool, wading pool, bathhouse, saunas, whirlpools, hot tubs, water and sewerage facilities or other appurtenances pertaining to health and safety; two (2) copies of plans and specifications must be submitted to the Baltimore County Department of Health for review and approval. For more complete information, contact the Recreational Hygiene Section, Division of Environmental Support Services.
- () Prior to approval for a nursery school, owner or applicant must comply with all Baltimore County regulations. For more complete information, contact the Division of Maternal and Child Health.
- () If lubrication work and oil changes are performed at this location, the method providing for the elimination of waste oil must be in accordance with Water Resources Administration requirements.

Zoning Item # 205
Page 2

- () Any existing underground storage tanks containing gasoline, waste oil, solvents, etc., must have the contents removed by a licensed hauler and either be removed from the property or properly backfilled.
- () Soil percolation tests have been conducted.
 - () The results are valid until _____
 - () Revised plans must be submitted prior to approval of the percolation tests.
- () Prior to occupancy approval, the potability of the water supply must be verified by collection of bacteriological and chemical water samples.
- () In accordance with Section 13-117 of the Baltimore County Code, the water well yield test
 - () shall be valid until _____
 - () is not acceptable and must be retested. This must be accomplished prior to conveyance of property or approval of Building Permit Applications.
- () All roads and parking areas should be surfaced with a dustless, bonding material.
- () No health hazards are anticipated.
- (X) Others The proposed accessory structure will not interfere with the location of the sewage disposal system.

John J. Forrest
John J. Forrest, Director
BUREAU OF ENVIRONMENTAL SERVICES

BALTIMORE COUNTY DEPARTMENT OF HEALTH

Zoning Commissioner
Office of Planning and Zoning
County Office Building
Towson, Maryland 21204

Zoning Item # 205, Zoning Advisory Committee Meeting of April 5, 1983

Property Owner: Steven R. Shores

Location: S/S New Section Road District 15

Water Supply Public Sewage Disposal Private

COMMENTS ARE AS FOLLOWS:

- () Prior to approval of a Building Permit for construction, renovation and/or installation of equipment for any existing or proposed food service facility, complete plans and specifications must be submitted to the Plans Review Section, Environmental Support Services, for final review and approval.
- () Prior to new installation/s of fuel burning equipment, the owner should contact the Division of Air Pollution Control, 494-3775, to obtain requirements for such installation/s before work begins.
- () A permit to construct from the Division of Air Pollution Control is required for such items as spray paint processes, underground gasoline storage tank/s (5,000 gallons or more) and any other equipment or process which exhausts into the atmosphere.
- () A permit to construct from the Division of Air Pollution Control is required for any charbroiler operation which has a total cooking surface area of five (5) square feet or more.
- () Prior to approval of a Building Permit Application for renovations to existing or construction of new health care facilities, complete plans and specifications of the building, food service area and type of equipment to be used for the food service operation must be submitted to the Plans Review and Approval Section, Division of Engineering and Maintenance, State Department of Health and Mental Hygiene for review and approval.
- () Prior to any new construction or substantial alteration of public swimming pool, wading pool, bathhouse, saunas, whirlpools, hot tubs, water and sewerage facilities or other appurtenances pertaining to health and safety; two (2) copies of plans and specifications must be submitted to the Baltimore County Department of Health for review and approval. For more complete information, contact the Recreational Hygiene Section, Division of Environmental Support Services.
- () Prior to approval for a nursery school, owner or applicant must comply with all Baltimore County regulations. For more complete information, contact the Division of Maternal and Child Health.
- () If lubrication work and oil changes are performed at this location, the method providing for the elimination of waste oil must be in accordance with Water Resources Administration requirements.

BALTIMORE COUNTY DEPARTMENT OF HEALTH

Zoning Commissioner
Office of Planning and Zoning
County Office Building
Towson, Maryland 21204

Zoning Item # 205, Zoning Advisory Committee Meeting of April 5, 1983

Property Owner: Steven R. Shores

Location: S/S New Section Road District 15

Water Supply Public Sewage Disposal Private

COMMENTS ARE AS FOLLOWS:

- () Prior to approval of a Building Permit for construction, renovation and/or installation of equipment for any existing or proposed food service facility, complete plans and specifications must be submitted to the Plans Review Section, Environmental Support Services, for final review and approval.
- () Prior to new installation/s of fuel burning equipment, the owner should contact the Division of Air Pollution Control, 494-3775, to obtain requirements for such installation/s before work begins.
- () A permit to construct from the Division of Air Pollution Control is required for such items as spray paint processes, underground gasoline storage tank/s (5,000 gallons or more) and any other equipment or process which exhausts into the atmosphere.
- () A permit to construct from the Division of Air Pollution Control is required for any charbroiler operation which has a total cooking surface area of five (5) square feet or more.
- () Prior to approval of a Building Permit Application for renovations to existing or construction of new health care facilities, complete plans and specifications of the building, food service area and type of equipment to be used for the food service operation must be submitted to the Plans Review and Approval Section, Division of Engineering and Maintenance, State Department of Health and Mental Hygiene for review and approval.
- () Prior to any new construction or substantial alteration of public swimming pool, wading pool, bathhouse, saunas, whirlpools, hot tubs, water and sewerage facilities or other appurtenances pertaining to health and safety; two (2) copies of plans and specifications must be submitted to the Baltimore County Department of Health for review and approval. For more complete information, contact the Recreational Hygiene Section, Division of Environmental Support Services.
- () Prior to approval for a nursery school, owner or applicant must comply with all Baltimore County regulations. For more complete information, contact the Division of Maternal and Child Health.
- () If lubrication work and oil changes are performed at this location, the method providing for the elimination of waste oil must be in accordance with Water Resources Administration requirements.

May 12, 1983
Date

May 12, 1983
Date

May 17, 1983
Date

BALTIMORE COUNTY DEPARTMENT OF HEALTH

Zoning Commissioner
Office of Planning and Zoning
County Office Building
Towson, Maryland 21204

Zoning Item # 205, Zoning Advisory Committee Meeting of April 5, 1983

Property Owner: Steven R. Shores

Location: 315 New Section Road District 15

Water Supply Public Sewage Disposal Private

COMMENTS ARE AS FOLLOWS:

- () Prior to approval of a Building Permit for construction, renovation and/or installation of equipment for any existing or proposed food service facility, complete plans and specifications must be submitted to the Plans Review Section, Environmental Support Services, for final review and approval.
- () Prior to new installation/s of fuel burning equipment, the owner should contact the Division of Air Pollution Control, 494-3775, to obtain requirements for such installation/s before work begins.
- () A permit to construct from the Division of Air Pollution Control is required for such items as spray paint processes, underground gasoline storage tank/s (5,000 gallons or more) and any other equipment or process which exhausts into the atmosphere.
- () A permit to construct from the Division of Air Pollution Control is required for any charbroiler operation which has a total cooking surface area of five (5) square feet or more.
- () Prior to approval of a Building Permit Application for renovations to existing or construction of new health care facilities, complete plans and specifications of the building, food service area and type of equipment to be used for the food service operation must be submitted to the Plans Review and Approval Section, Division of Engineering and Maintenance, State Department of Health and Mental Hygiene for review and approval.
- () Prior to any new construction or substantial alteration of public swimming pool, wading pool, bathhouse, saunas, whirlpools, hot tubs, water and sewerage facilities or other appurtenances pertaining to health and safety; two (2) copies of plans and specifications must be submitted to the Baltimore County Department of Health for review and approval. For more complete information, contact the Recreational Hygiene Section, Division of Environmental Support Services.
- () Prior to approval for a nursery school, owner or applicant must comply with all Baltimore County regulations. For more complete information, contact the Division of Maternal and Child Health.
- () If lubrication work and oil changes are performed at this location, the method providing for the elimination of waste oil must be in accordance with Water Resources Administration requirements.

SS 20 1082 (1)

May 17, 1983
Date

BALTIMORE COUNTY DEPARTMENT OF HEALTH

Zoning Commissioner
Office of Planning and Zoning
County Office Building
Towson, Maryland 21204

Zoning Item # 205, Zoning Advisory Committee Meeting of April 5, 1983

Property Owner: Steven R. Shores

Location: 315 New Section Road District 15

Water Supply Public Sewage Disposal Private

COMMENTS ARE AS FOLLOWS:

- () Prior to approval of a Building Permit for construction, renovation and/or installation of equipment for any existing or proposed food service facility, complete plans and specifications must be submitted to the Plans Review Section, Environmental Support Services, for final review and approval.
- () Prior to new installation/s of fuel burning equipment, the owner should contact the Division of Air Pollution Control, 494-3775, to obtain requirements for such installation/s before work begins.
- () A permit to construct from the Division of Air Pollution Control is required for such items as spray paint processes, underground gasoline storage tank/s (5,000 gallons or more) and any other equipment or process which exhausts into the atmosphere.
- () A permit to construct from the Division of Air Pollution Control is required for any charbroiler operation which has a total cooking surface area of five (5) square feet or more.
- () Prior to approval of a Building Permit Application for renovations to existing or construction of new health care facilities, complete plans and specifications of the building, food service area and type of equipment to be used for the food service operation must be submitted to the Plans Review and Approval Section, Division of Engineering and Maintenance, State Department of Health and Mental Hygiene for review and approval.
- () Prior to any new construction or substantial alteration of public swimming pool, wading pool, bathhouse, saunas, whirlpools, hot tubs, water and sewerage facilities or other appurtenances pertaining to health and safety; two (2) copies of plans and specifications must be submitted to the Baltimore County Department of Health for review and approval. For more complete information, contact the Recreational Hygiene Section, Division of Environmental Support Services.
- () Prior to approval for a nursery school, owner or applicant must comply with all Baltimore County regulations. For more complete information, contact the Division of Maternal and Child Health.
- () If lubrication work and oil changes are performed at this location, the method providing for the elimination of waste oil must be in accordance with Water Resources Administration requirements.

SS 20 1082 (1)

Zoning Item # 205
Page 2

- () Any existing underground storage tanks containing gasoline, waste oil, solvents, etc., must have the contents removed by a licensed hauler and either be removed from the property or properly backfilled.
- () Soil percolation tests have been conducted.
 - () The results are valid until
 - () Revised plans must be submitted prior to approval of the percolation tests.
- () Prior to occupancy approval, the potability of the water supply must be verified by collection of bacteriological and chemical water samples.
- () In accordance with Section 13-117 of the Baltimore County Code, the water well yield test
 - () shall be valid until
 - () is not acceptable and must be retested. This must be accomplished prior to conveyance of property or approval of Building Permit Applications.
- () All roads and parking areas should be surfaced with a dustless, bonding material.
- () No health hazards are anticipated.

(X) Others The proposed accessory structure will not interfere with the location of the sewage disposal system.

Ian J. Forrest, Director
BUREAU OF ENVIRONMENTAL SERVICES

SS 20 1080 (2)

BALTIMORE COUNTY PUBLIC SCHOOLS

Robert V. Dabel, Superintendent

Towson, Maryland - 21204

Date: April 5, 1983

Mr. William E. Hammond
Zoning Commissioner
Baltimore County Office Building
1111 West Chesapeake Avenue
Towson, Maryland 21204

Z.A.C. Meeting of: April 5, 1983

RE: Item No: 198, 199, 200, 201, 202, 203, 204, 205
Property Owner:
Location:
Present Zoning:
Proposed Zoning:

District:
No. Acres:

Dear Mr. Hammond:

All of the above have no adverse effect on student population.

Very truly yours,
Wm. Nick Petrovich, Assistant
Department of Planning

WNP/bp

BALTIMORE COUNTY, MARYLAND

INTER-OFFICE CORRESPONDENCE

TO: Mr. Nicholas Commodari
Zoning Department Date: April 12, 1983
FROM: Charles E. Burnham
Zoning Advisory Committee
SUBJECT: Meeting of April 5, 1983

Item #198 See Comments
Item #199 See Comments
Item #200 See Comments
Item #201 Standard Comments
Item #202 See Comments
Item #203 Standard Comments
Item #204 Standard Comments
Item #205 No Comments

Charles E. Burnham
Plans Review Chief

djl

Zoning Item # 205
Page 2

- () Any existing underground storage tanks containing gasoline, waste oil, solvents, etc., must have the contents removed by a licensed hauler and either be removed from the property or properly backfilled.
- () Soil percolation tests have been conducted.
 - () The results are valid until
 - () Revised plans must be submitted prior to approval of the percolation tests.

- () Prior to occupancy approval, the potability of the water supply must be verified by collection of bacteriological and chemical water samples.
- () In accordance with Section 13-117 of the Baltimore County Code, the water well yield test
 - () shall be valid until
 - () is not acceptable and must be retested. This must be accomplished prior to conveyance of property or approval of Building Permit Applications.

- () All roads and parking areas should be surfaced with a dustless, bonding material.
- () No health hazards are anticipated.

(X) Others The proposed accessory structure will not interfere with the location of the sewage disposal system.

Ian J. Forrest, Director
BUREAU OF ENVIRONMENTAL SERVICES

SS 20 1080 (2)

Zoning Item # 205
Page 2

- () Any existing underground storage tanks containing gasoline, waste oil, solvents, etc., must have the contents removed by a licensed hauler and either be removed from the property or properly backfilled.
- () Soil percolation tests have been conducted.
 - () The results are valid until
 - () Revised plans must be submitted prior to approval of the percolation tests.

- () Prior to occupancy approval, the potability of the water supply must be verified by collection of bacteriological and chemical water samples.
- () In accordance with Section 13-117 of the Baltimore County Code, the water well yield test
 - () shall be valid until
 - () is not acceptable and must be retested. This must be accomplished prior to conveyance of property or approval of Building Permit Applications.

- () All roads and parking areas should be surfaced with a dustless, bonding material.
- () No health hazards are anticipated.

(X) Others The proposed accessory structure will not interfere with the location of the sewage disposal system.

Ian J. Forrest, Director
BUREAU OF ENVIRONMENTAL SERVICES

SS 20 1080 (2)

ZONING DESCRIPTION

Located on the south side of New Section Road, approximately 601.7' northeast of Seneca Road and being lots 334 and 335, as shown on second addition to Plat #2, Bowley's Quarters; which is recorded in land records of Baltimore County in Book 10 Page 64. Also known as 3921 New Section Road.

OFFICIAL COPY

7-24-74 (Case No. 74-24-A) **PETITION FOR ZONING VARIANCE FROM AREA AND HEIGHT REGULATIONS**

TO THE ZONING COMMISSIONER OF BALTIMORE COUNTY:

I, or we, William T. Tomlinson, legal owner of the property situate in Baltimore County and which is described in the description and plat attached hereto and made a part hereof, hereby petition for a Variance from Section 400.1 of the Zoning Regulations of Baltimore County, Maryland, to permit the construction of a dwelling in the front yard (waterfront) instead of the required rear yard.

and the Zoning Regulations of Baltimore County, to the Zoning Law of Baltimore County, for the following reasons (state hardship or practical difficulty):

See attached description



Property is to be posted and advertised as provided by Zoning Regulations. I, or we, agree to pay expenses of above Variance advertising, posting, etc., upon filing of this petition and further agree to be bound by the zoning regulations and restrictions of Baltimore County adopted pursuant to the Zoning Law of Baltimore County.

William T. Tomlinson
Contract purchaser
Address: 231 South Ann Street
Baltimore, Maryland 21201

William T. Tomlinson
Legal Owner
Address: 231 South Ann Street
Baltimore, Maryland 21201


Baltimore, Maryland 21201

RE: PETITION FOR VARIANCE
from Section 400.1 of the
Baltimore County
Zoning Regulations
SE 1/4 of New Section Road, 505.55'
NE of South Seneca Road
15th District
William T. Tomlinson,
Petitioner

BEFORE
COUNTY BOARD OF APPEALS
OF
BALTIMORE COUNTY
No. 74-24-A

OPINION

This case comes before the Board as an appeal by the Petitioner from an Order of the Zoning Commissioner, dated November 5, 1973, denying a requested variance to permit an accessory building in the front yard instead of the required rear yard.

The property that is the subject of this appeal is located on the southeast side of New Section Road, 505.55 feet northeast of South Seneca Road, in the Fifteenth Election District of Baltimore County.

Mr. William Tomlinson, owner of the subject property, testified that he began construction of the subject building sometime during the early part of the year 1971, and that he intended to use it as a dwelling. Mr. Tomlinson also testified that he began this construction without applying for and obtaining a building permit. The record indicates that this was called to the County's attention on April 6, 1971, by the Bowley's Quarters Improvement Association.

After investigation by the Buildings Engineer's Office of Baltimore County, Mr. Tomlinson was notified by that office on April 7, 1971, to halt immediately any further construction. Mr. Tomlinson was cited for a violation, and was subsequently fined the sum of \$600 by the District Court of Maryland. The record also indicates that on October 26, 1971, a complaint was filed with the Department of Permits and Licenses relative to electrical work being performed in the subject building, even though a stop order had been issued.

This petition was the subject of an earlier variance petition for a dwelling (Case No. 72-246-A), which resulted in the granting by the Zoning Commissioner on April 25, 1972, of two side yard setbacks for the subject building for use as a dwelling. A later site visit by the Buildings Engineer's representative indicated that Mr. Tomlinson had apparently not intended to follow through with his plan to build a dwelling on these

RE: PETITION FOR VARIANCE
from Section 400.1 of the
Baltimore County
Zoning Regulations
SE 1/4 of New Section Road, 505.55'
NE of South Seneca Road
15th District
William T. Tomlinson
Petitioner-Appellant
Zoning File No. 74-24-A

IN THE
CIRCUIT COURT
FOR
BALTIMORE COUNTY
AT LAW
Misc. Docket No. 4
File No. 438
File No. 5321

PETITION IN SUPPORT OF APPEAL

The Petition of William T. Tomlinson, by his attorney, A. Gordon Boone, Jr., respectfully represents unto Your Honor:

1. That the above named Petitioner and Appellant filed a Petition for a Zoning Variance SE 1/4 of New Section Road, 505.55' NE of South Seneca Road, 15th District.

2. That the County Board of Appeals by Opinion dated May 14, 1974 denied the said Petition for the reasons set forth in the aforesaid opinion.

3. That your Petitioners aver that the action of the County Board of Appeals of Baltimore County is erroneous, arbitrary, capricious, illegal and constituted an abuse of its administrative discretion for the following reason:

- That the decision was improper and against the weight of evidence presented by the petitioners.
- And for other good and sufficient reasons to be assigned at the time of the hearing on this Appeal.

WHEREFORE, your Petitioners pray that this Honorable Court reverse the action and decision of the County Board of Appeals dated May 14, 1974 and enter an Order granting the petition for

William T. Tomlinson - #74-24-A

2.

had been no attempt to provide necessary sewage or water hookups, which was mandatory for a dwelling structure. This matter was brought to Mr. Tomlinson's attention, and he was warned that he could be handed for another violation citation. This apparently triggered Mr. Tomlinson into requesting another variance to permit this building to remain as an accessory building in the rear of his property which, as stated previously, has been denied by the Zoning Commissioner.

In the mind of this Board, the evidence and testimony presented is void of proof of practical difficulty and/or unreasonable hardship. All of the evidence that might tend to prove any such difficulty and/or hardship is the result of overt actions by the Petitioner contrary to existing regulations. While not within the duties or responsibilities of this Board, by way of extraneous comment, the Board feels that a solution to the Petitioner's dilemma might lie in a return to his original thinking that was apparently expressed by him to the Zoning Commissioner in Case No. 72-246-A.

After reviewing the evidence and testimony presented in this case, it is the judgment of this Board that under Section 307 of the Zoning Regulations, the Petitioner has failed to prove practical difficulty and/or unreasonable hardship, and should be made to comply with Section 400.1 of the Regulations covering Accessory Buildings in Residence Zones. In fact, had Mr. Tomlinson adhered to Baltimore County Codes and Regulations after being made aware that they do exist by Judge Wilkins in District Court and by the Zoning Commissioner, he would not be before this Board. The Board further concludes that because there is already a dwelling and two accessory buildings on his property, and that Mr. Tomlinson has, in our opinion, created for him, if any hardship or difficulty that exists, the petition for variance shall be denied and the Order of the Zoning Commissioner, dated November 5, 1973, shall be affirmed.

zoning variance SE 1/4 of New Section Road, 505.55' NE of South Seneca Road 15th District, Baltimore County and grant such other relief as the nature of this case may require.

A. Gordon Boone, Jr.
11 W. Pennsylvania Avenue
Towson, Maryland 21204
825-5696
Attorney for Appellants

William T. Tomlinson - #74-24-A

3.

ORDER

For the reasons set forth in the aforesaid Opinion, it is this 14th day of May, 1974, by the County Board of Appeals, ORDERED that the variance petitioned for, be and the same is hereby DENIED.

Any appeal from this decision must be in accordance with Chapter 1100, subtitle B of Maryland Rules of Procedure.

COUNTY BOARD OF APPEALS
OF BALTIMORE COUNTY

Robert C. Hare, Jr.
Chairman

John A. Miller
Secretary

Robert C. Hare, Jr.
Chairman

I HEREBY CERTIFY, that a copy of the aforesaid Petition was served on the Secretary of the County Board of Appeals for Baltimore County, County Clerk and Auditor, on May 14, 1974, and that a copy of the aforesaid Petition for and on behalf of the County Board of Appeals for Baltimore County.

A. Gordon Boone, Jr.

I, John A. Miller, Secretary of the County Board of Appeals for Baltimore County, do hereby acknowledge receipt of a copy of the aforesaid Petition for and on behalf of the County Board of Appeals for Baltimore County.

6/11/74

John A. Miller
Secretary
County Board of Appeals
for Baltimore County

Rec'd 6/11/74
3:45 PM
(Hand Del'd)

The court in the advertisement, posting of property, and public hearing on the above petition and it appearing that by reason of the following finding of facts:

the above Variance should be granted; and it further appearing that by reason of:

a Variance should be granted.

IT IS ORDERED by the Zoning Commissioner of Baltimore County that:

that the above petition for a Variance should be and the same is granted from and after the date of this order.

Zoning Commissioner of Baltimore County

Pursuant to the advertisement, posting of property, and public hearing on the above petition and it appearing that by reason of a failure to show practical difficulty and unreasonable hardship,

the above Variance should NOT BE GRANTED.

IT IS ORDERED by the Zoning Commissioner of Baltimore County that:

that the above Variance be and the same is hereby DENIED.

Zoning Commissioner of Baltimore County

"that it was arbitrary, unreasonable or capricious: *Baldman v. Montgomery County Council*, supra; *Amesland, Inc. v. Board*, supra; *Spaley v. Hospital for Consumptive*, supra; *Mayor & City Council of Balto. v. Sapern*, 230 Md. 291, 186 A.2d 884 (1962)."

The questions before the Court at this time are: (1) was there ample legally sufficient evidence to make the issue before the Board "fairly debatable," and if not (2) has the Appellant shown that the Board's determination was arbitrary, unreasonable or capricious.

This Court realizes that it has no authority to substitute its judgment for that of the zoning authority but is limited to the above determinations.

A review of the transcript reveals to this Court that the evidence presented before the Board was sufficient to make the issue "fairly debatable." The Petitioner, having filed this appeal has the burden of proving to this Court that the Board's action was arbitrary, capricious or unreasonable. It is this Court's opinion that the Petitioner has failed to establish that the Board abused the discretion vested in it by law.

For the above reasons, the opinion of the County Board of Appeals of Baltimore County is hereby Upheld this day of September, 1974, and the Petitioner's appeal is hereby Denied.

H. LOMY MACDANIEL
JUDGE

Copy to:
Mr. Gordon Boone, Esq.
Mr. Joseph Fashen
County Board of Appeals
Richard D. Byrd, Assistant County Solicitor

PETITION FOR VARIANCE
from Section 400.1 of the
Baltimore County Zoning
Regulations
SE/5 of New Section 505.55
NE of South Seneca Road
15th District
WILLIAM T. TOMLINSON
Petitioner

IN THE CIRCUIT COURT
FOR BALTIMORE COUNTY
WISC. CASE: 5321
DOCKET: 9
FOLIO: 438

MEMORANDUM OPINION

This matter involves an appeal from the County Board of Appeals of Baltimore County, which by its Order dated May 14, 1974, denied to Mr. William T. Tomlinson a requested variance from Section 400.1 of the Baltimore County Zoning Regulations to permit an accessory building in the front yard instead of the required rear yard. The property involved is located on the west side of New Section Road 505.55 feet northeast of South Seneca Road in the 15th Election District of Baltimore County, also known as 450 New Section Road.

The appeal was filed with this Court on June 11, 1974. A hearing was held by the Court on August 21, 1974 at which time counsel for Appellant presented argument. Appellant's counsel has submitted a memorandum of fact and law which has been reviewed by the Court. Having reviewed the transcript, memorandum and the law, the Court is now in a position to make its decision.

The petition was filed pursuant to Section 307 of the Zoning Regulations which states in part:

"Sec. 307 Variance
The Zoning Commissioner of Baltimore County and the County Board of Appeals upon appeal, shall have and they are hereby given the power

"to grant variance from height and area regulations, from off-street parking regulations and from sign regulations, only in cases where strict compliance with the Zoning Regulations for Baltimore County would result in practical difficulty or unreasonable hardship. No increase in residential density beyond that otherwise allowable by the Zoning Regulations shall be permitted as a result of any such grant of variance from height or area regulations. Furthermore, any such variance shall be granted only if in strict harmony with the spirit and intent of said height, area, off-street parking or sign regulations, and only in such manner as to grant relief without substantial injury to public health, safety, and general welfare." (Emphasis added.)

The Board found that the testimony presented by the Petitioner was "void of proof of practical difficulty and/or unreasonable hardship." The Board went on to state, "All of the evidence that might tend to prove any such difficulty and/or hardship is the result of overt actions by the Petitioner contrary to existing regulations." This finding was based principally on the testimony of Mr. William Tomlinson, the Petitioner. The facts are as follows:

Mr. Tomlinson began construction of the subject building sometime during the early part of 1971; he intended to use it as a dwelling. He had begun construction without applying for or obtaining a building permit. Upon a complaint by the Bowleys Quarters Improvement Association on April 6, 1971, and after an investigation by the Building Engineer's Office of Baltimore County, Mr. Tomlinson was notified on April 7, 1971 to halt immediately any further construction. Mr. Tomlinson was cited for a violation and subsequently fined the sum of Six Hundred (\$600.00) Dollars by the District Court of Maryland.

This property was the subject of an earlier variance

Petition for Variance
SE/5 of New Section Road
505.55 NE of South
Seneca Road - 15th
District
William T. Tomlinson
Petitioner
NO. 74-24-A (Item NO. 255)


Baltimore County Office of
PLANNING & ZONING

APPEAL TO THE COUNTY BOARD OF APPEALS

Now comes the Petitioner, William T. Tomlinson, by his Attorney, A. Gordon Boone, Jr. and requests an Appeal from the decision of the Zoning Commissioner of Baltimore County, in the above captioned case, to the County Board of Appeals.

William T. Tomlinson
Petitioner

A. Gordon Boone, Jr.
11 West Pennsylvania Avenue
Towson, Maryland 21204
Tel. 3-5496

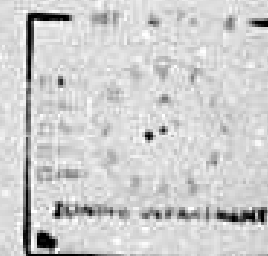

petition for a dwelling (Case No. 72-306-A) which resulted in the granting by the Zoning Commissioner on April 25, 1972, of two side yard setbacks for the subject building for use as a dwelling. A later site visit by the Building Engineer representative indicated that Mr. Tomlinson had apparently not intended to complete his plan to erect a dwelling as there had been no attempt to provide necessary sewage or water hook-ups, which are mandatory for such a structure. This matter was brought to Mr. Tomlinson's attention, whereupon he subsequently requested another variance to permit this building to remain as an accessory building in the front of his property. The second requested variance, having been denied by the Zoning Commissioner and the County Board of Appeals, is now the subject of this appeal.

The Court must look at all of the facts and circumstances of a zoning appeal in light of the principles set forth in *Baldman v. Board of County Commissioners of Howard County*, 253 Md. 290 (1969), where the Court, concerning the scope of review, said:

"We have often repeated the principle here applicable: courts have no power to review and may not substitute their judgment for that of the expertise of the zoning authority. *Baldman v. Montgomery County Council*, 251 Md. 273, 247 A.2d 255 (1968); *Spaley v. Hospital for Consumptives*, 244 Md. 197, 227 A.2d 746 (1967); *Board of County Commissioners for Prince George's County v. Farr*, 242 Md. 315, 218 A.2d 923 (1966). It has long been settled that the zoning authority's determination is correct if there were such legally sufficient evidence as would make the question fairly debatable. *Ark Right-Way Concrete Corp. v. Smith*, 245 Md. 1, 248 A.2d 230 (1968); *Realty and City Council of Greenbelt v. Bd. of County Commrs for Prince George's County*, 247 Md. 470, 237 A.2d 140 (1967); *Amesland, Inc. v. Board of Commrs*, 247 Md. 412, 233 A.2d 757 (1967). Further, the one who attacks the determination made by the authority must show

September 5, 1974

A. Gordon Boone, Jr., Esquire
11 West Pennsylvania Avenue
Towson, Maryland 21204

RE: Petition for Variance
SE/5 of New Section Road, 505.55'
NE of South Seneca Road - 15th
District
William T. Tomlinson - Petitioner
NO. 74-24-A Item No. 105

Dear Mr. Boone:

I have this date received my Order in the above captioned matter. Copy of said Order is attached.

Very truly yours,

S. KACI DI NENNA
Zoning Commissioner

SE/DH

Attachment

cc: Mr. Joseph Fashen
150 New Section Road
Baltimore, Maryland 21270

MEMORANDUM FOR THE DIRECTOR

The appeal was filed with this Court on June 13, 1974. A hearing was held by the Court on August 21, 1974 at which time counsel for Appellant presented argument. Appellant's counsel has submitted a memorandum of fact and law which has been reviewed by the Court. Having reviewed the transcript, memoranda and the law, the Court is now in a position to make its decision.

The petition was filed pursuant to Section 307 of the Zoning Regulations which states in part:

"Sec. 307 Variances
The Zoning Commissioner of Baltimore County
and the County Board of Appeals upon appeal
shall hear and they are hereby given the power

to grant variances from height and area regulations, from off-street parking regulations and from sign regulations, only in cases where strict compliance with the zoning regulations for Baltimore County would result in a substantial hardship or an unreasonable hardship. No increase in the number of signs beyond that otherwise allowable by the zoning regulations shall be permitted as a result of any grant of a variance from height or area regulations. Furthermore, no such variances shall be granted only if it is shown that with the spirit and intent of said height, off-street parking or sign regulations, and only if it is shown that such grant will not be a substantial injury to the public health, safety and general welfare. (Emphasis added.)

The Board found that the testimony presented by the Petitioner was "void of proof of practical difficulty and/or unreasonable hardship." The Board went on to state, "All of the evidence that might tend to prove any such difficulty and/or hardship is the result of overt actions by the Petitioner contrary to existing regulations." This finding was based principally on the testimony of Mr. William Tomlinson, the Petitioner. The facts are as follows:

Mr. Tomlinson began construction of the subject building sometime during the early part of 1971; he intended to use it as a dwelling. He had begun construction without applying for or obtaining a building permit. Upon a complaint by the Bowleys Greeners Improvement Association on April 6, 1971, and after an investigation by the Building Engineer's Office of Baltimore County, Mr. Tomlinson was notified on April 7, 1971 to halt immediately any further construction. Mr. Tomlinson was cited for a violation and subsequently fined the sum of Six Hundred (\$600.00) Dollars by the District Court of Maryland.

This property was the subject of an earlier version.

- 2 -

petition for a dwelling (Case No. 72-245-K) which resulted in the granting by the zoning Commissioner on April 25, 1972, of two side yard setbacks for the subject building for use as a dwelling. A later site visit by the Building Engineer representative indicated that Mr. Tomlinson had apparently not intended to complete his plan to erect a dwelling as there had been no attempt to provide necessary sewage or water hook-ups, which are mandatory for such a structure. This matter was brought to Mr. Tomlinson's attention, whereupon he subsequently requested another variance to permit his building to remain as an accessory building in the front of his property. The second requested variance, having been denied by the zoning Commissioner and the County Board of Appeals, is now the subject of this appeal.

The Court must look at all of the facts and circumstances of a zoning appeal in light of the principles set forth in Halderan v. Board of County Commissioners of Howard County, 253 Md. 298 (1969), where the Court, concerning the scope of review, said:

[illegible]

- 3 -

"that it was arbitrary, unreasonable or capricious. Richman v. Montgomery County Council, supra; Ammalasee, Inc. v. Jones, supra; Booley v. Hospital for Consumptives, supra; Hayes v. City Council of Balto. v. Supers, 230 Md. 291, 186 A.2d 886 (1962)."

(1) was there ample legally sufficient evidence to make the issue before the Board "fairly debatable," and if so: (2) has the Appellant shown that the Board's determination was arbitrary, unreasonable or capricious.

This Court realizes that it has no authority to substitute its judgment for that of the zoning authority but is limited to the above determinations.

A review of the transcript reveals to this Court that the evidence presented before the Board was sufficient to make the same "fairly debatable." The Petitioner having filed this appeal has the burden of proving to this Court that the Board's action was arbitrary, capricious or unreasonable. It is this Court's opinion that the Petitioner has failed to establish that the Board abused the discretion vested in it by law.

For the above reasons, the opinion of the County Board of Appeals of Baltimore County is hereby APPROVED this 1 day of September, 1974, and the Petitioner's appeal is hereby DEFERRED.

H. KEMP MA
JUNIOR

Copy to:
A. Gordon Boone, Esq.
Mr. Joseph Hishan
County Board of Appeals ✓
Richard D. Byrd, Assistant County Solicitor

4

DALMORE COUNTY, MARYLAND

INTER-OFFICE CORRESPONDENCE

TO: S. Eric Silronna, Acting Commissioner Date: July 18, 1973

FROM: William S. Fromm, Director
OFFICE OF PLANNING AND ZONING

SUBJECT: Petition #74-24-A, Southwest side of Bear Section Road 195.55 feet
Northwest of Seneca Road,
Petition for Variance for a Rear Yard.
Petitioner - William T. Tomlinson

15th District


HEARING: Monday, July 30, 1973 (10:00 A.M.)

The staff of the Office of Planning and Zoning will offer no comment on this petition at this time.




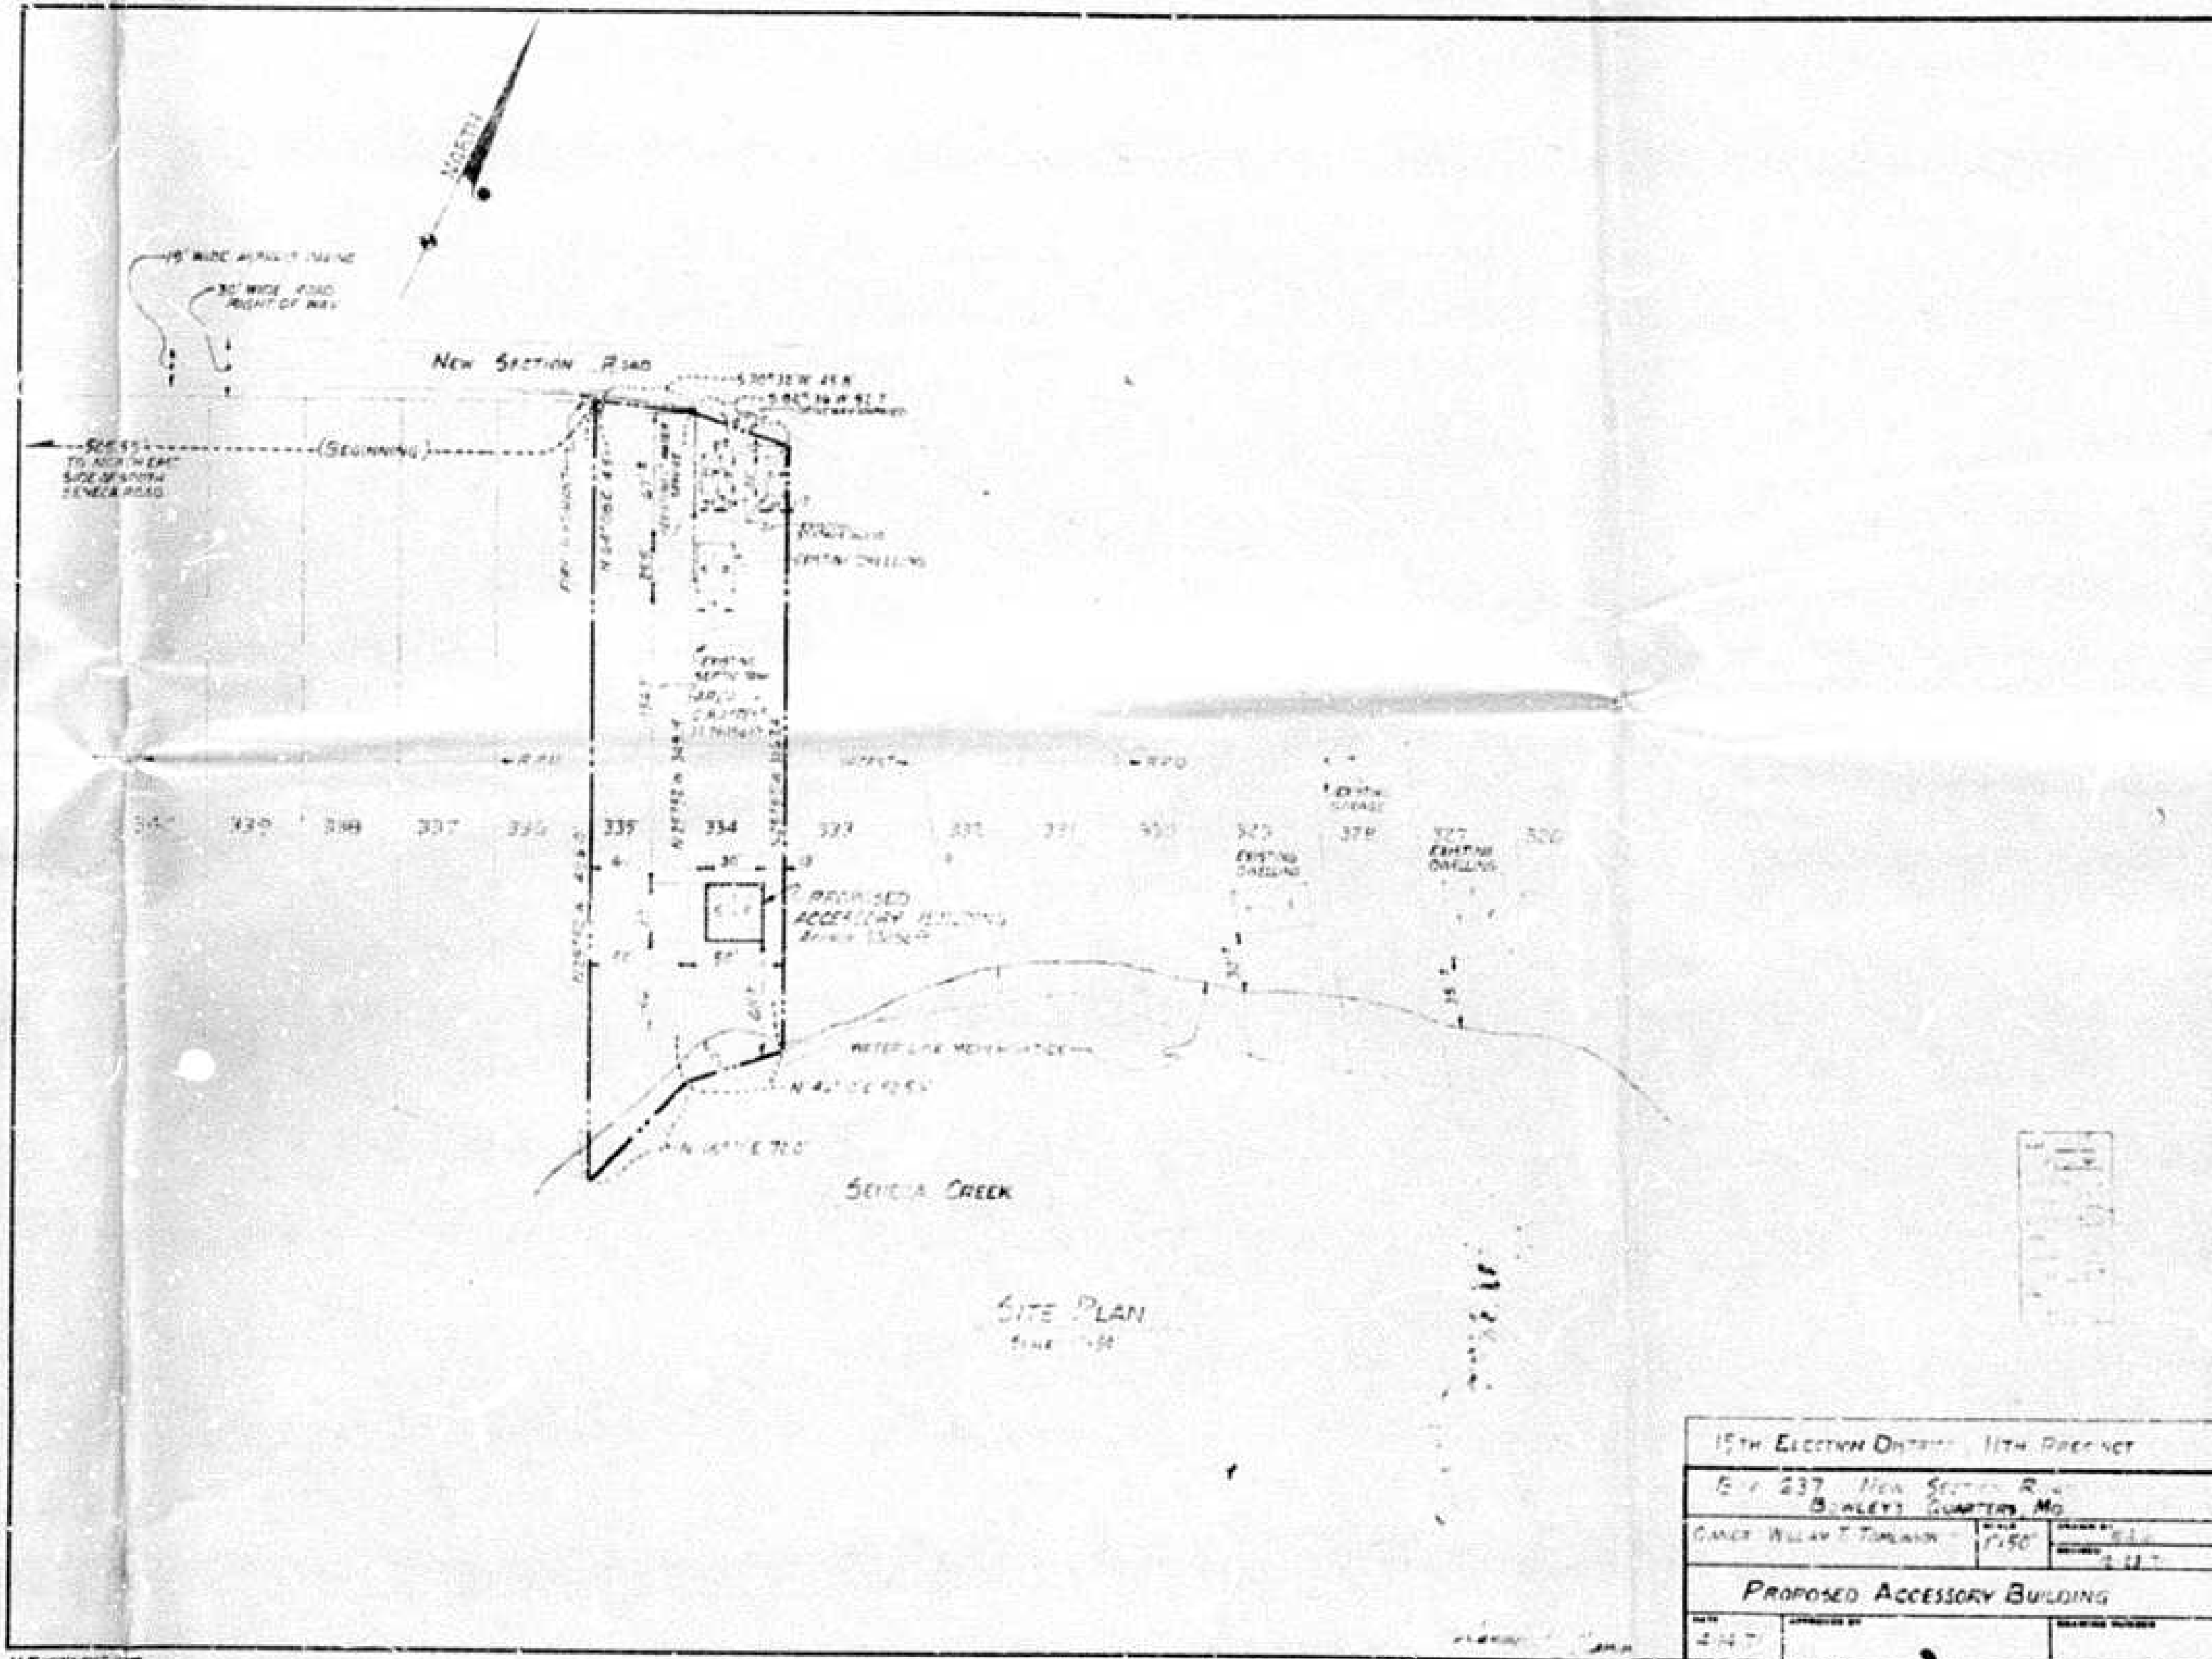

MAR 26 1978

Storm Drainage (Cont'd)

The property to be developed is located adjacent to the water front. The Petitioner is advised that the proper sections of the Baltimore County Building Code must be followed whereby elevation limitations are placed on first floor levels of residential or commercial development and other special construction features are required.

Water:

Public water supply is available to serve this property.

Sanitary Sewer:

Public sanitary sewerage is not available to serve this property which is utilizing private onsite sewerage.

Edward M. Diver

EDWARD M. DIVER, P.E.
Chief, Bureau of Engineering

END:RAN:RFR:SS

Attachment

cc: John A. Somers

Z-SW Key Sheet
3 NE L6 & L7 Position Sheet
NE 2 L Topo
91 Tax Map

Zoning Item # 205
Page 2

- () Any existing underground storage tanks containing gasoline, waste oil, solvents, etc., must have the contents removed by a licensed hauler and either be removed from the property or properly backfilled.
- () Soil percolation tests have been conducted.
{ } The results are valid until _____
{ } Revised plans must be submitted prior to approval of the percolation tests.

- () Prior to occupancy approval, the potability of the water supply must be verified by collection of bacteriological and chemical water samples.
- () In accordance with Section 13-117 of the Baltimore County Code, the water well yield test
{ } shall be valid until _____
{ } is not acceptable and must be retested. This must be accomplished prior to conveyance of property or approval of Building Permit Applications.

- () All roads and parking areas should be surfaced with a dustless, bonding material.

- () No health hazards are anticipated.

- (X) Others The proposed accessory structure will not interfere with the location of the sewage disposal system.

Ian J. Forrest
Ian J. Forrest, Director
BUREAU OF ENVIRONMENTAL SERVICES

BALTIMORE COUNTY DEPARTMENT OF HEALTH

Zoning Commissioner
Office of Planning and Zoning
County Office Building
Towson, Maryland 21204

Zoning Item # 205, Zoning Advisory Committee Meeting of April 5, 1983

Property Owner: Steven R. Shores

Location: S/S New Section Road District 15

Water Supply Public Sewage Disposal Private

COMMENTS ARE AS FOLLOWS:

- () Prior to approval of a Building Permit for construction, renovation and/or installation of equipment for any existing or proposed food service facility, complete plans and specifications must be submitted to the Plans Review Section, Environmental Support Services, for final review and approval.
- () Prior to new installation/s of fuel burning equipment, the owner should contact the Division of Air Pollution Control, 494-3775, to obtain requirements for such installation/s before work begins.
- () A permit to construct from the Division of Air Pollution Control is required for such items as spray paint processes, underground gasoline storage tank/s (5,000 gallons or more) and any other equipment or process which exhausts into the atmosphere.
- () A permit to construct from the Division of Air Pollution Control is required for any charbroiler operation which has a total cooking surface area of five (5) square feet or more.
- () Prior to approval of a Building Permit Application for renovations to existing or construction of new health care facilities, complete plans and specifications of the building, food service area and type of equipment to be used for the food service operation must be submitted to the Plans Review and Approval Section, Division of Engineering and Maintenance, State Department of Health and Mental Hygiene for review and approval.
- () Prior to any new construction or substantial alteration of public swimming pool, wading pool, bathhouse, saunas, whirlpools, hot tubs, water and sewerage facilities or other appurtenances pertaining to health and safety; two (2) copies of plans and specifications must be submitted to the Baltimore County Department of Health for review and approval. For more complete information, contact the Recreational Hygiene Section, Division of Environmental Support Services.
- () Prior to approval for a nursery school, owner or applicant must comply with all Baltimore County regulations. For more complete information, contact the Division of Maternal and Child Health.
- () If lubrication work and oil changes are performed at this location, the method providing for the elimination of waste oil must be in accordance with Water Resources Administration requirements.

SS 20 1082 (1)

May 12 1983
Date

BALTIMORE COUNTY DEPARTMENT OF HEALTH

Zoning Commissioner
Office of Planning and Zoning
County Office Building
Towson, Maryland 21204

Zoning Item # 205, Zoning Advisory Committee Meeting of April 5, 1983

Property Owner: Steven R. Shores

Location: S/S New Section Road District 15

Water Supply Public Sewage Disposal Private

COMMENTS ARE AS FOLLOWS:

- () Prior to approval of a Building Permit for construction, renovation and/or installation of equipment for any existing or proposed food service facility, complete plans and specifications must be submitted to the Plans Review Section, Environmental Support Services, for final review and approval.
- () Prior to new installation/s of fuel burning equipment, the owner should contact the Division of Air Pollution Control, 494-3775, to obtain requirements for such installation/s before work begins.
- () A permit to construct from the Division of Air Pollution Control is required for such items as spray paint processes, underground gasoline storage tank/s (5,000 gallons or more) and any other equipment or process which exhausts into the atmosphere.
- () A permit to construct from the Division of Air Pollution Control is required for any charbroiler operation which has a total cooking surface area of five (5) square feet or more.
- () Prior to approval of a Building Permit Application for renovations to existing or construction of new health care facilities, complete plans and specifications of the building, food service area and type of equipment to be used for the food service operation must be submitted to the Plans Review and Approval Section, Division of Engineering and Maintenance, State Department of Health and Mental Hygiene for review and approval.
- () Prior to any new construction or substantial alteration of public swimming pool, wading pool, bathhouse, saunas, whirlpools, hot tubs, water and sewerage facilities or other appurtenances pertaining to health and safety; two (2) copies of plans and specifications must be submitted to the Baltimore County Department of Health for review and approval. For more complete information, contact the Recreational Hygiene Section, Division of Environmental Support Services.
- () Prior to approval for a nursery school, owner or applicant must comply with all Baltimore County regulations. For more complete information, contact the Division of Maternal and Child Health.
- () If lubrication work and oil changes are performed at this location, the method providing for the elimination of waste oil must be in accordance with Water Resources Administration requirements.

SS 20 1082 (1)

Zoning Item # 205
Page 2

- () Any existing underground storage tanks containing gasoline, waste oil, solvents, etc., must have the contents removed by a licensed hauler and either be removed from the property or properly backfilled.
- () Soil percolation tests have been conducted.
{ } The results are valid until _____
{ } Revised plans must be submitted prior to approval of the percolation tests.

- () Prior to occupancy approval, the potability of the water supply must be verified by collection of bacteriological and chemical water samples.
- () In accordance with Section 13-117 of the Baltimore County Code, the water well yield test
{ } shall be valid until _____
{ } is not acceptable and must be retested. This must be accomplished prior to conveyance of property or approval of Building Permit Applications.

- () All roads and parking areas should be surfaced with a dustless, bonding material.

- () No health hazards are anticipated.

- (X) Others The proposed accessory structure will not interfere with the location of the sewage disposal system.

Ian J. Forrest
Ian J. Forrest, Director
BUREAU OF ENVIRONMENTAL SERVICES

SS 20 1080 (2)

Zoning Item # 205
Page 2

- () Any existing underground storage tanks containing gasoline, waste oil, solvents, etc., must have the contents removed by a licensed hauler and either be removed from the property or properly backfilled.

- () Soil percolation tests have been conducted.
{ } The results are valid until _____
{ } Revised plans must be submitted prior to approval of the percolation tests.

- () Prior to occupancy approval, the potability of the water supply must be verified by collection of bacteriological and chemical water samples.
- () In accordance with Section 13-117 of the Baltimore County Code, the water well yield test
{ } shall be valid until _____
{ } is not acceptable and must be retested. This must be accomplished prior to conveyance of property or approval of Building Permit Applications.

- () All roads and parking areas should be surfaced with a dustless, bonding material.

- () No health hazards are anticipated.

- (X) Others The proposed accessory structure will not interfere with the location of the sewage disposal system.

Ian J. Forrest
Ian J. Forrest, Director
BUREAU OF ENVIRONMENTAL SERVICES

SS 20 1080 (2)

BALTIMORE COUNTY DEPARTMENT OF HEALTH

Zoning Commissioner
Office of Planning and Zoning
County Office Building
Towson, Maryland 21204

Zoning Item # 205, Zoning Advisory Committee Meeting of April 5, 1983

Property Owner: Steven R. Shores

Location: S/S New Section Road District 15

Water Supply Public Sewage Disposal Private

COMMENTS ARE AS FOLLOWS:

- () Prior to approval of a Building Permit for construction, renovation and/or installation of equipment for any existing or proposed food service facility, complete plans and specifications must be submitted to the Plans Review Section, Environmental Support Services, for final review and approval.

- () Prior to new installation/s of fuel burning equipment, the owner should contact the Division of Air Pollution Control, 494-3775, to obtain requirements for such installation/s before work begins.

- () A permit to construct from the Division of Air Pollution Control is required for such items as spray paint processes, underground gasoline storage tank/s (5,000 gallons or more) and any other equipment or process which exhausts into the atmosphere.

- () A permit to construct from the Division of Air Pollution Control is required for any charbroiler operation which has a total cooking surface area of five (5) square feet or more.

- () Prior to approval of a Building Permit Application for renovations to existing or construction of new health care facilities, complete plans and specifications of the building, food service area and type of equipment to be used for the food service operation must be submitted to the Plans Review and Approval Section, Division of Engineering and Maintenance, State Department of Health and Mental Hygiene for review and approval.

- () Prior to any new construction or substantial alteration of public swimming pool, wading pool, bathhouse, saunas, whirlpools, hot tubs, water and sewerage facilities or other appurtenances pertaining to health and safety; two (2) copies of plans and specifications must be submitted to the Baltimore County Department of Health for review and approval. For more complete information, contact the Recreational Hygiene Section, Division of Environmental Support Services.

- () Prior to approval for a nursery school, owner or applicant must comply with all Baltimore County regulations. For more complete information, contact the Division of Maternal and Child Health.

- () If lubrication work and oil changes are performed at this location, the method providing for the elimination of waste oil must be in accordance with Water Resources Administration requirements.

SS 20 1082 (1)

May 12 1983
Date

BALTIMORE COUNTY DEPARTMENT OF HEALTH

Zoning Commissioner
Office of Planning and Zoning
County Office Building
Towson, Maryland 21204

Zoning Item # 205, Zoning Advisory Committee Meeting of April 5, 1983

Property Owner: Steven R. Shores

Location: S/S New Section Road District 15

Water Supply Public Sewage Disposal Private

COMMENTS ARE AS FOLLOWS:

- () Prior to approval of a Building Permit for construction, renovation and/or installation of equipment for any existing or proposed food service facility, complete plans and specifications must be submitted to the Plans Review Section, Environmental Support Services, for final review and approval.

- () Prior to new installation/s of fuel burning equipment, the owner should contact the Division of Air Pollution Control, 494-3775, to obtain requirements for such installation/s before work begins.

- () A permit to construct from the Division of Air Pollution Control is required for such items as spray paint processes, underground gasoline storage tank/s (5,000 gallons or more) and any other equipment or process which exhausts into the atmosphere.

- () A permit to construct from the Division of Air Pollution Control is required for any charbroiler operation which has a total cooking surface area of five (5) square feet or more.

- () Prior to approval of a Building Permit Application for renovations to existing or construction of new health care facilities, complete plans and specifications of the building, food service area and type of equipment to be used for the food service operation must be submitted to the Plans Review and Approval Section, Division of Engineering and Maintenance, State Department of Health and Mental Hygiene for review and approval.

- () Prior to any new construction or substantial alteration of public swimming pool, wading pool, bathhouse, saunas, whirlpools, hot tubs, water and sewerage facilities or other appurtenances pertaining to health and safety; two (2) copies of plans and specifications must be submitted to the Baltimore County Department of Health for review and approval. For more complete information, contact the Recreational Hygiene Section, Division of Environmental Support Services.

- () Prior to approval for a nursery school, owner or applicant must comply with all Baltimore County regulations. For more complete information, contact the Division of Maternal and Child Health.

- () If lubrication work and oil changes are performed at this location, the method providing for the elimination of waste oil must be in accordance with Water Resources Administration requirements.

SS 20 1082 (1)

- () Any existing underground storage tanks containing gasoline, waste oil, solvents, etc., must have the contents removed by a licensed hauler and either be removed from the property or properly backfilled.
- () Soil percolation tests have been conducted.
() The results are valid until _____.
() Revised plans must be submitted prior to approval of the percolation tests.
- () Prior to occupancy approval, the potability of the water supply must be verified by collection of bacteriological and chemical water samples.
- () In accordance with Section 13-117 of the Baltimore County Code, the water well yield test
() shall be valid until _____.
() is not acceptable and must be retested. This must be accomplished prior to conveyance of property or approval of Building Permit Applications.
- () All roads and parking areas should be surfaced with a dustless, bonding material.
- () No health hazards are anticipated.

(X) Others The proposed accessory structure will not interfere with the location of the sewage disposal system.

Ian J. Forrest, Director
BUREAU OF ENVIRONMENTAL SERVICES

SS 20 1080 (2)

May 17 1983
Date

BALTIMORE COUNTY DEPARTMENT OF HEALTH

Zoning Commissioner
Office of Planning and Zoning
County Office Building
Towson, Maryland 21204

Zoning Item # 205, Zoning Advisory Committee Meeting of April 5, 1983

Property Owner: Steven R. Shores

Location: 3921 New Section Road District 15

Water Supply Public Sewage Disposal Private

COMMENTS ARE AS FOLLOWS:

- () Prior to approval of a Building Permit for construction, renovation and/or installation of equipment for any existing or proposed food service facility, complete plans and specifications must be submitted to the Plans Review Section, Environmental Support Services, for final review and approval.
- () Prior to new installation/s of fuel burning equipment, the owner should contact the Division of Air Pollution Control, 494-3775, to obtain requirements for such installation/s before work begins.
- () A permit to construct from the Division of Air Pollution Control is required for such items as spray paint processes, underground gasoline storage tank/s (5,000 gallons or more) and any other equipment or process which exhausts into the atmosphere.
- () A permit to construct from the Division of Air Pollution Control is required for any charbroiler operation which has a total cooking surface area of five (5) square feet or more.
- () Prior to approval of a Building Permit Application for renovations to existing or construction of new health care facilities, complete plans and specifications of the building, food service area and type of equipment to be used for the food service operation must be submitted to the Plans Review and Approval Section, Division of Engineering and Maintenance, State Department of Health and Mental Hygiene for review and approval.
- () Prior to any new construction or substantial alteration of public swimming pool, wading pool, bathhouse, saunas, whirlpools, hot tubs, water and sewerage facilities or other appurtenances pertaining to health and safety; two (2) copies of plans and specifications must be submitted to the Baltimore County Department of Health for review and approval. For more complete information, contact the Recreational Hygiene Section, Division of Environmental Support Services.
- () Prior to approval for a nursery school, owner or applicant must comply with all Baltimore County regulations. For more complete information, contact the Division of Maternal and Child Health.
- () If lubrication work and oil changes are performed at this location, the method providing for the elimination of waste oil must be in accordance with Water Resources Administration requirements.


SS 20 1082 (1)

- () Any existing underground storage tanks containing gasoline, waste oil, solvents, etc., must have the contents removed by a licensed hauler and either be removed from the property or properly backfilled.
- () Soil percolation tests have been conducted.
() The results are valid until _____.
() Revised plans must be submitted prior to approval of the percolation tests.
- () Prior to occupancy approval, the potability of the water supply must be verified by collection of bacteriological and chemical water samples.
- () In accordance with Section 13-117 of the Baltimore County Code, the water well yield test
() shall be valid until _____.
() is not acceptable and must be retested. This must be accomplished prior to conveyance of property or approval of Building Permit Applications.
- () All roads and parking areas should be surfaced with a dustless, bonding material.
- () No health hazards are anticipated.

(X) Others The proposed accessory structure will not interfere with the location of the sewage disposal system.

Ian J. Forrest, Director
BUREAU OF ENVIRONMENTAL SERVICES

SS 20 1080 (2)

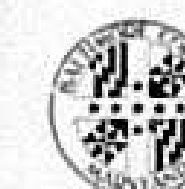

BALTIMORE COUNTY
OFFICE OF PLANNING & ZONING
TOWSON, MARYLAND 21204
494-3353

WILLIAM E. HAMMOND
ZONING COMMISSIONER

June 24, 1983

Mr. Steven R. Shores
3921 New Section Road
Baltimore, Maryland 21220

RE: Petition for Variance
S/S of New Section Rd., 601.7'
NE of Seneca Rd. - 15th Election
District
Steven R. Shores - Petitioner
NO. 83-283-A (Item No. 205)

Dear Mr. Shores:

I have this date passed my Order in the above captioned matter in accordance with the attached.

Very truly yours,

Jean M. H. Jung
JEAN M.H. JUNG
Deputy Zoning Commissioner

JMHJ/mc

Attachments

cc: Mr. Joseph Kashen
3920 New Section Road
Baltimore, Maryland 21220

John W. Hessian, III, Esquire
People's Counsel

BALTIMORE COUNTY, MARYLAND

INTER-OFFICE CORRESPONDENCE

William E. Hammond
TO: Zoning Commissioner
Norman E. Gerber, Director
FROM: Office of Planning and Zoning
Zoning Petition No. 83-283-A
SUBJECT: Steven R. Shores

Date: May 31, 1983

There are no comprehensive planning factors requiring comment on this petition.

Norman E. Gerber
Norman E. Gerber
Director of Planning and Zoning

NEGJGH:lc

cc: Arlene January
Shirley Hess

PETITION FOR VARIANCE

15th Election District

ZONING: Petition for Variance

LOCATION: South side of New Section Road, 601.7 ft. Northeast of Seneca Road

DATE & TIME: Tuesday, June 21, 1983 at 9:30 A.M.

PUBLIC HEARING: Room 106, County Office Building, 111 W. Chesapeake Avenue, Towson, Maryland

The Zoning Commissioner of Baltimore County, by authority of the Zoning Act and Regulations of Baltimore County, will hold a public hearing:

Petition for Variance to permit an existing accessory structure to be located in the front yard in lieu of required rear yard

The Zoning Regulation to be excepted as follows:
Section 400.1 - location of accessory structure

All that parcel of land in the Fifteenth District of Baltimore County

Being the property of Steven R. Shores, as shown on plat plan filed with the Zoning Department.

Hearing Date: Tuesday, June 21, 1983 at 9:30 A.M.
Public Hearing: Room 106, County Office Building, 111 W. Chesapeake Avenue, Towson, Maryland

BY ORDER OF
WILLIAM E. HAMMOND
ZONING COMMISSIONER
OF BALTIMORE COUNTY

PETITION FOR VARIANCE

15th Election District

ZONING: Petition for Variance

LOCATION: South side of New Section Road, 601.7 ft. Northeast of Seneca Road

DATE & TIME: Tuesday, June 21, 1983 at 9:30 A.M.

PUBLIC HEARING: Room 106, County Office Building, 111 W. Chesapeake Avenue, Towson, Maryland

The Zoning Commissioner of Baltimore County, by authority of the Zoning Act and Regulations of Baltimore County, will hold a public hearing:

Petition for Variance to permit an existing accessory structure to be located in the front yard in lieu of required rear yard

The Zoning Regulation to be excepted as follows:
Section 400.1 - location of accessory structure

All that parcel of land in the Fifteenth District of Baltimore County

Being the property of Steven R. Shores, as shown on plat plan filed with the Zoning Department.

Hearing Date: Tuesday, June 21, 1983 at 9:30 A.M.
Public Hearing: Room 106, County Office Building, 111 W. Chesapeake Avenue, Towson, Maryland

BY ORDER OF
WILLIAM E. HAMMOND
ZONING COMMISSIONER
OF BALTIMORE COUNTY

ZONING DESCRIPTION

Located on the south side of New Section Road, approximately 601.7' northeast of Seneca Road and being lots 334 and 335, as shown on second addition to Plat #2, Bowley's Quarters; which is recorded in land records of Baltimore County in Book 10 Page 64. Also known as 3921 New Section Road.

May 25, 1983

Mr. Steven R. Shores
3921 New Section Road
Baltimore, Maryland 21220

NOTICE OF HEARING

Re: Petition for Variance
S/S of New Section Rd., 601.7' NE of
Seneca Road
Steven R. Shores - Petitioner
Case No. 83-283-A

TIME: 9:30 A.M.

DATE: Tuesday, June 21, 1983

PLACE: ROOM 106 COUNTY OFFICE BUILDING, 111 W. CHESAPEAKE AVENUE,

TOWSON, MARYLAND

cc: Ms. Deborah Brill
3925 New Section Road
Baltimore, Md. 21220

Mr. Joseph Kashen
3920 New Section Road
Baltimore, Md. 21220



BAITIMORE COUNTY
OFFICE OF PLANNING & ZONING
TOWSON, MARYLAND 21204
494-3353

WILLIAM E. HAMMOND
ZONING COMMISSIONER

June 9, 1983

Mr. Steven R. Shores
3921 New Section Road
Baltimore, Maryland 21220

Re: Petition for Variance
S/S of New Section Rd., 601.7' NE
of Seneca Road
Case No. 83-283-A

Dear Mr. Shores:

This is to advise you that \$46.30 is due for advertising and posting of the above property.

Please make the check payable to Baltimore County, Maryland, and remit to Arlene January, Zoning Office, Room 113, County Office Building, Towson, Maryland 21204, before the hearing.

Very truly yours,

WILLIAM E. HAMMOND
Commissioner

BAITIMORE COUNTY, MARYLAND
OFFICE OF FINANCE-REVENUE DIVISION
MISCELLANEOUS CASH RECEIPT

No. 117653

DATE: 6/21/83 ACCOUNT: R-01-615-000

AMOUNT: \$46.30 (cash)

RECEIVED FROM: Steven R. Shores

FOR: Advertising & Posting Case #83-283-A

013*****463018 8215A

Petition For Variance

15th Election District

ZONING: Petition for

Variance

LOCATION: South side of New Section Road, 601.7' NE of Seneca Road

DATE & TIME: Tuesday, June 21, 1983 at 9:30 A.M.

PUBLIC HEARING: Room 106, County Office Building, 111 W. Chesapeake Avenue, Towson, Maryland

The Zoning Commissioner of Baltimore County, by authority of the Board of Zoning Appeals and the Board of Estimates of Baltimore County, will hold a public hearing on the following:

Petition for Variance to permit an existing accessory structure to be located in the front yard in lieu of required rear yard.

The Zoning Commissioner will hold a public hearing on the following:

Section 400.1 - Location of accessory structure.

All that parcel of land in the 15th Election District of Baltimore County:

Located on the south side of New Section Road, approximately 601.7' northeast of Seneca Road and being into 2nd and 3rd sections on second addition to Plat #1, Bowley's Quarters, which is recorded in land records of Baltimore County in Book 10 Page 64. Also known as 3921 New Section Road.

Being the property of Steven R. Shores, as shown on plat plan filed with the Zoning Department.

Hearing Date: Tuesday, June 21, 1983 at 9:30 A.M.

Public Hearing: Room 106, County Office Building, 111 W. Chesapeake Avenue, Towson, Maryland

BY ORDER OF WILLIAM E. HAMMOND, Zoning Commissioner of Baltimore County

The Times

Middle River, Md., June 2, 1983

This is to Certify, That the annexed

was inserted in The Times, a newspaper printed and published in Baltimore County, once in each of one successive weeks before the 2nd day of June, 1983.

Publisher.

DUPLICATE CERTIFICATE OF PUBLICATION


TOWSON, MD., June 2, 1983

THIS IS TO CERTIFY, that the annexed advertisement was published in THE JEFFERSONIAN, a weekly newspaper printed and published in Towson, Baltimore County, Md., once in each of one successive weeks before the 21st day of June, 1983, the first publication appearing on the 2nd day of June 1983.

THE JEFFERSONIAN

L. L. Smith, Manager

Cost of Advertisement, \$ 19.25

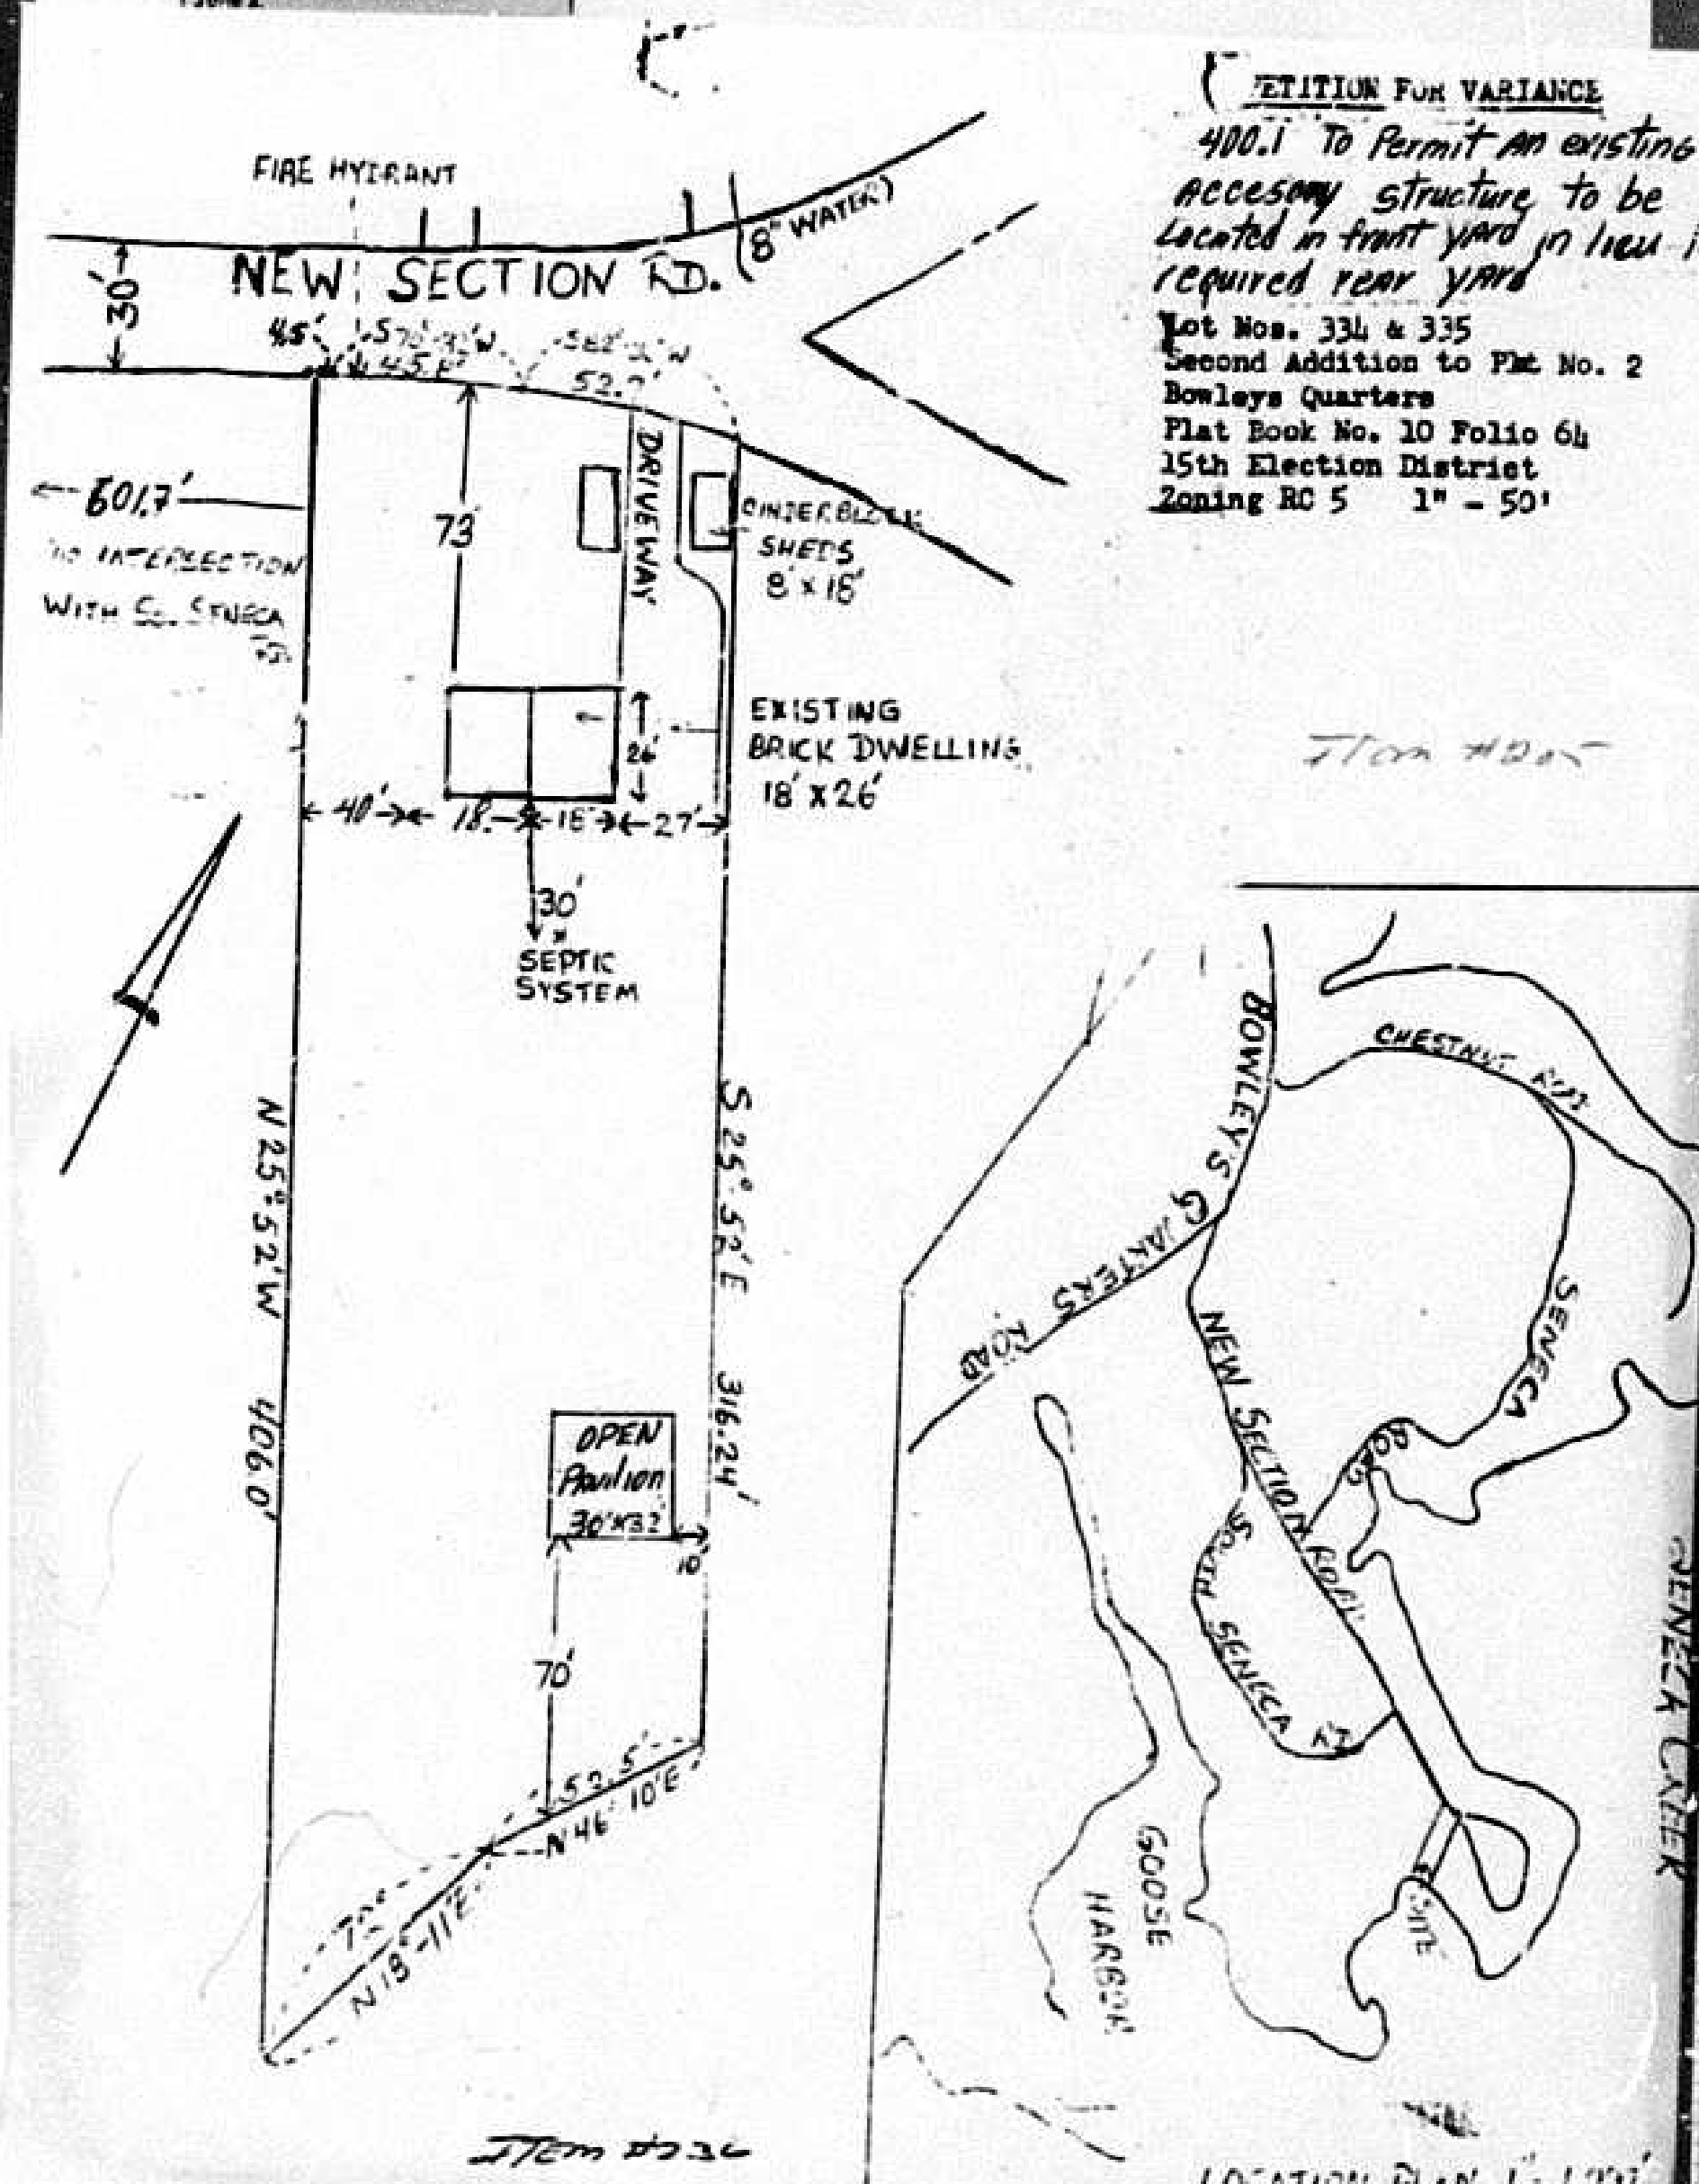

CERTIFICATE OF PUBLICATION

TOWSON, MD., June 2, 1983

THIS IS TO CERTIFY, that the annexed advertisement was published in THE JEFFERSONIAN, a weekly newspaper printed and published in Towson, Baltimore County, Md., once in each of one successive weeks before the 21st day of June, 1983, the first publication appearing on the 2nd day of June 1983.

THE JEFFERSONIAN

L. L. Smith, Manager

Cost of Advertisement, \$ 19.25

PETITION FOR VARIANCE
15th Election District
BOWLEY'S QUARTERS: Petition for Variance
LOCATION: South side of New Section Road, 601.7' NE of Seneca Road
DATE & TIME: Tuesday, June 21, 1983 at 9:30 A.M.
PUBLIC HEARING: Room 106, County Office Building, 111 W. Chesapeake Avenue, Towson, Maryland
The Zoning Commissioner of Baltimore County, by authority of the Board of Zoning Appeals and the Board of Estimates of Baltimore County, will hold a public hearing on the following:
Petition for Variance to permit an existing accessory structure to be located in the front yard in lieu of required rear yard.
The Zoning Commissioner will hold a public hearing on the following:
Section 400.1 - Location of accessory structure.
All that parcel of land in the 15th Election District of Baltimore County:
Located on the south side of New Section Road, approximately 601.7' northeast of Seneca Road and being into 2nd and 3rd sections on second addition to Plat #1, Bowley's Quarters, which is recorded in land records of Baltimore County in Book 10 Page 64. Also known as 3921 New Section Road.
Being the property of Steven R. Shores, as shown on plat plan filed with the Zoning Department.
Hearing Date: Tuesday, June 21, 1983 at 9:30 A.M.
Public Hearing: Room 106, County Office Building, 111 W. Chesapeake Avenue, Towson, Maryland
BY ORDER OF WILLIAM E. HAMMOND, Zoning Commissioner of Baltimore County



BAITIMORE COUNTY, MARYLAND
OFFICE OF FINANCE-REVENUE DIVISION
MISCELLANEOUS CASH RECEIPT
No. 115069
DATE: 6/21/83 ACCOUNT: R-01-615-000
AMOUNT: \$35.00
RECEIVED FROM: Steven R. Shores
FOR: Advertising & Posting Case #83-283-A
013*****35018 8266A

CERTIFICATE OF POSTING

ZONING DEPARTMENT OF BALTIMORE COUNTY

Towson, Maryland

District: 15 Date of Posting: 6/16/83
Posted for: Petition for Variance
Petitioner: Steven R. Shores
Location of property: 601.7' NE of Seneca Rd., 3921 New Section Rd.
Location of Signs: corners of property at 3921 New Section Rd.
Remarks: Right of way easement with driveway
Posted by: William E. Hammond
Number of Signs: 4

PETITION MAPPING PROGRESS SHEET

FUNCTION	Wall Map	Original	Duplicate	Tracing	200 Sheet
	date by	date by	date by	date by	date by
Descriptions checked and outline plotted on map					
Petition number added to outline					
Denied					
Granted by ZC, BA, CC, CA					
Reviewed by: [Signature]					
Previous case: 82-44A, 82-44A					

Revised Plans:
Change in outline or description Yes ___ No ___
Map #