
	PETITIC. FOR ZONING VAL.ANCE				
	TO THE ZONING COMMISSIONER OF BALTIMORE COUNTY:				
	The undersigned, legal owner(s) of the property situate in Baltimore County and which is described in the description and plat attached he eto and made a part hereof, hereby petition for a				
	Variance from Section 1 Bol. 2-C.1. to permit 14' between buildings in lieu of the required 16' and to amend the Final Developement Plan of Perry Hall Gardens			전에 가면 가면 보면 보다. (1) 1 1 1 1 1 1 1 1 1 1 1 1 1 1 1 1 1 1	
	Addition to allow the home addition outside of the building envelope.		보다 보고 있는 것이 되었다. 그는 사람들은 사람들이 되었다. 그는 사람들이 되었다. 그는 사람들이 되었다. 그는 사람들이 되었다. 그는 사람들이 되었다. - 사람들이 보고 있는 사람들이 가지를 보고 있다. 그는 사람들이 되었다. 사람들이 되었다. 사람들이 되었다. 사람들이 되었다. 사람들이 되었다.		
	of the Zoning Regulations of Baltimore County, to the Loning Law of Baltimore County; for the following reasons: (indic. hardship or practical difficulty)				
	1. Safety precaution- Two women living alone, both leaving for the				CNOS SINCE
	work in the dark and usually arriving at home at night after dark.				Share and the state of the stat
	2. Protection against vandalism to automobiles.  3. Extra storage space.			BALTIMORE COUNTY DEPARTMENT OF PUBLIC WORKS TOWSON, MARYLAND 21204	
	Tree  DTASTIS. A		BALTIMORE CONSTRUCT	TOWSON, MARYLAND 21204	
	Property is to be posted and advertised as prescribed by Zoning Regulations.		BALTIMORE COUNTY ZONING PLANS ADVISORY COMMITTEE August 5, 1985	HARRY J. PISTEL, P. E. DIRECTOR July 5, 1985	
	I, or we, agree to pay expenses of above Variance advertising, posting, etc., upon filing of this petition, and further agree to and are to be bound by the zoning regulations and restrictions of Baltimore County adopted pursuant to the Zoning Law For Baltimore County.	# 6 W	COUNTY OFFICE BLDG. Ms. Peggy A. Smith		
		$\mathcal{P}_{\mathcal{G}}$	111 W. Chesapeake Ave. Towson, Maryland 21204  Baltimore, Maryland 21236	Mr. Arnold Jablon Zoning Commissioner	
***  ***  ***  ***  ***  ***  ***  ***  ***  ***  ***  ***  **  ***  ***  **	I/We do solemnly declare and affirm, under the penalties of perjury, that I/we are the legal owner(s) of the property which is the subject of this Petition.	$\mathcal{A}$	oDo Nicholas B. Commodari	County Office Building Towson, Maryland 21204	·
	Contract Purchaser: Legal Owner(s):		Chairman RE: Item No. 382 - Case No. 86-63-A Petitioners - Peggy A Smith at all	Re: Item #382 (1984-1985)	
	(Type or Print Name)  (Type or Print Name)	Cuse No. 86-53-A	MEMBERS VARIANCE PETITION	Property Owner: Peggy A. Smith SE/S Gunview Road, 672' S/W from c/l Klausmer Road	victoria de la compania de la compa
	Signature Signature Signature	BALTIMORE COUNTY OFFICE OF PLANNING & ZONING	Dear Ms. Smith:  Department of Traffic Engineering mitted with the above referenced positions. The Internal Committee has reviewed the plans sub-	District 11th	
	Address (Type of Print Name)	County Office Building	are not intended to indicate the postation. The following comments	Dear Mr. Jablon:	
	City and State  City and State  Signature  Signature	111 W. Chesapeake Avenue Towson, Maryland 21204	problems with regard to the development are made aware of plans or	The following comments are furnished in regard to the plat submitted to this office for review by the Zoning Advisory Committee in connection with the subject item.	
	Attorney for Petitioner:	Your petition has been received and accepted for filing this	Health Department on this case. The Director of Planning may file a written report with the Zoning Commissioner with recommendations as to the suitability of	General Comments:	
	(Type or Print Name)  9413 GUUVIEW Rd. 256-098		Building Department Enclosed are all commonts sub-	The Petitioner must provide necessary drainage facilities (temporary or permanent) to prevent creating any nuisances or damages	
	Signature BALTO. Md. 21236	25.0	Zoning Administration petition. If similar comments from the	to adjacent properties, especially by the concentration of surface waters. Correction of any problem which may result, due to improper	
	City and State  Name, address and phone number of legal ourses are	ARNOLD JABLON	informative will be placed in the hearing file. This petition was	grading or improper installation of drainage facilities, would be the full responsibility of the Petitioner.	
	tract purchaser or representative to be contacted	Petitioner Peggy A. Smith, et al Received by	deco. driigiy.	Development of this property through stripping, grading and stabilization could result in a sediment pollution problem, damaging	
	City and State Name	Petitioner's Nicholas B. Commodari Attorney Chairman, Zoning Plans	Very truly yours,  Technical B. Commodan	private and public holdings downstream of the property. A grading permit is, therefore, necessary for all grading, including the	
	Attorney's Telephone No.:  Address Phone No.	Advisory Committee cc: Don Lynch Assoc., Inc., 4907Harford Road, Baltimore, Maryland 21214	NICHOLAS B. COMMODARI	stripping of top soil.  There is an existing 10 foot drainage and utility easement	
	ORDERED By The Zoning Commissioner of Baltimore County, this9th day		Chairman Zoning Plans Advisory Committee	centered along the northernmost property line, 5 feet of this easement falls along the entire property line. The applicant is	
	of a July 19.85., that the subject matter of this petition be advertised, as required by the Zoning Law of Baltimore County, in two newspapers of general circulation throughout Fatimore County, that property be posted, and that the public hearing be had before the Zoning Commissioner of Baltimore County in Room 106, County Office Building in Towson, Baltimore		NBC:nr	cautioned that no permanent construction can be placed over the drainage and utility easement.	
	County on the day of August, 19.85, at 10:15 o'clock		cc: Don Lynch Assoc., Inc.	Very truly yours,	
	G AAM.		4907 Harford Road Baltimore, Maryland 21214	James A. Markle, P.E., Chief	
	Zoning Commissioner of Baltimore County.			Bureau of Public Services  JAM:PMO:blp	
	Zoning Commissioner of Baltimore County.			cc: file	
		13  PAITMOSE COUNTY		BALTIMORE COUNTY	
	ALVINORE COUNTY	DEPARTMENT OF TRAFFIC ENGINEERING TOWSON, MARYLAND 21204 494-3550	BALTIMORE COUNTY FIRE DEPARTMENT TOWSON, MARYLAND 21204-2586 494-4500	BALTIMORE COUNTY DEPARTMENT OF PERMITS & LICENSES July 8, 1985 TOWSON, MARYLAND 21204 494-3610	
	BALTIMORE COUNTY OFFICE OF PLANNING AND ZONING TOWSON, MARYLAND 21204 494-3211	STEPHEN E. COLLINS DIRECTOR	July 2, 1985	<del>-</del>	
	NORMAN E. GERBER DIRECTOR	DIRECTOR  June 26, 1985	PAUL H. REINCKE CHIEF	TED ZALESKI, JR. DIRECTOR	
			Mr. Arnold Jablon Zoning Commissioner	Mr. Armeld Teltan Garden Company	
	Mr. Arnold Jablon  JULY 22, 1985	Mr. Arnold Jablen Zoning Commissioner County Office Building	Office of Planning and Zoning Baltimore County Office Building	Mr. Arnold Jablon, Zoning Commissioner Office of Planning and Zoning Towson, Maryland 21204	
	Zoning Commissioner County Office Building Towson, Maryland 21204	Towson, Maryland 21204 ZAC-Meeting of June 18, 1985	Towson, Maryland 21204  Attention: Nick Commodari, Chairman	Dear Mr. Jablons  Comments on Item # 382 Zoning Advisory Committee Meeting are as follows:	
	Re: Zoning Advisory Meeting of JUNE 18, 1985  Item # 382  Property Owner: PEGGY A. SMITH, et al  Location: SE/SIDE GOVERNOR	Item No. 370,372,373,374,375,376,377,378,379,380,381,382,383, and 384.	Zoning Plans Advisory Committee	Property Owner: Peggy A. Smith, et al  Location: SE/S Gunview Road 672' S/W from c/1 Klausmer Road  District: 11th.	
	a sclaint doublem kp. 64%.	Property Owner:  Location: Existing Zoning:	FL: Froperty Owner: Peggy A. Smith, et al	APPLICABLE EXES ARE CIRCLED:	junite.
	Dear Mr. Jablon:  The Division of Current Planning and Development has reviewed the subject  netition and offers the following corrects. The items should be be be subject	Proposed Zoning:	Item No.: 382  Zoning Agenda: Meeting of June 18 1085	All structures shall conform to the Baltimore County Building Code as adopted by Council Bill #17-85.  
	petition and offers the following comments. The items checked below are applicable.  (X)There are no site planning factors requiring comment.		Item No.: 382 Zoning Agenda: Meeting of June 18, 1985  Gentlemen:	P A building and other miscellaneous permits shall be required before the start of any construction.	
	(* )A County Review Group Meeting is required.  i )A County Review Group meeting was held and the minutes will be forward by the Bureau of Public Services.	Acres:	Pursuant to your request, the referenced property has been surveyed by this	C. Residential: Two sets of construction drawings are required to file a permit application. The seal of a registered in Maryland Architect or Engineer is/is not required on plane and technical data.	
	( )This site is part of a larger tract; therfore it is defined as a subdivision. The plan must show the entire tract. ( )A record plat will be required and must be recorded prior	District:	Bureau and the comments below marked with an "X" are applicable and required to be corrected or incorporated into the final plans for the property.	D. Commercial: Three sets of construction drawings sealed and signed by a registered in Maryland Architect or Engineer shall be required to file with a permit application. Reproduced seals are not acceptable.	
	to issuance of a building permit.  ( )The access is not satisfactory. ( )The circulation on this site is not satisfactory.	Dear Mr. Jablon:	( ) I. Fire hydrants for the referenced property are required and shall be located at intervals or feet along an approved road in accordance with Baltimore County Standards as published by the	E. All Use Groups except R-L Single Family Detached Duellings require a minimum of 1 hour fire rating for	
	( )The parking arrangement is not satisfactory. ( )Parking calculations must be shown on the plan. ( )This property contains soils which are defined as wetlands, and	The Department of Traffic Engineering has no comments for item numbers, 370,372,373,374,375,376,377,378,379,380,381, 382,383, and 384.	accordance with Baltimore County Standards as published by the Lepartment of Public Works.	then 3'-0 to am interior lot line. Any wall built on an interior lot line and interior a case hour wall if closer wall. See Table 801, Section 1807, Section 806.2 and Table 1802. Be openings are permitted in an exterior wall within 3'-0 of am interior lot line.	
	development on these soils is prohibited.  ( )Construction in or alteration of the floodplain is prohibited under the provisions of Section 22-98 of the Development Regulations		( ) 2. A second means of vehicle access is required for the site.	P. The structure does not appear to comply with Table 505 for permissable height/area. Reply to the requested variance by this office cannot be round sered until the necessary data pertaining to height/area and construction type is provided. See Table 501 and 505 and have your Architect/Engineer contact this department.	
	( )Development of this site may constitute a potential conflict with the Baltimore County Master Plan. ( )The amended Development Plan was approved by the Planning Board		( ) 3. The vehicle dead end condition shown at	G. The requested variance appears to conflict with Section(s), of the Baltimore	
	on ( )Landscaping: Must comply with Baltimore County Landscape Manual. ( )The property is located in a deficient service area as defined by	Therefore File	EXCEEDS the maximum allowed by the Fire Department.	Es. When filing for a required change of the to	
	Bill 178-79. No building permit may be issued until a Reserve Capacity Use Certificate has been issued. The deficient service is	Michael S. Flanigan () Traffic Engineering Assoc. II	( ) 4. The site shall be made to comply with all applicable parts of the Fire Prevention Code prior to occupancy or beginning of operation.	be filed along with three sets of acceptable construction plans indicating how the existing structure is to be altered in order to comply with the Code requirements for the new use. Maryland Architectural or Engineer seals are usually required. The change of Use Groups are from Use to Use or or to Mixed Uses Section 312 of the Paulding Code.	
	( )The property is located in a traffic area controlled by a "D" level intersection as defined by Bill 178-79, and as conditions change traffic capacity way become more limited. The Basic Services Areas are re-evaluated annually by the County Council.	M3F/ccm	(X) 5. The buildings and structures existing or proposed on the site shall	I. The proposed project appears to be located in a Flood Plain, Tidel/Riverine. Flease see the attached	
	are re-evaluated annually by the County Council.  ( )Additional comments:		comply with all applicable requirements of the National Fire Protection Association Standard No. 101 "Life Safety Code", 1976 edition prior to occupancy.	and the state there is a state the state of	
			' ) 6. Site plans are approved, as drawn.	It is assumed from the plan submitted the structure proposed is not in the flood plain.	
	Eugene A. Bober		. ) 7. The Fire Prevention Bureau has no comments, at this time.	K. These abbreviated comments reflect only on the formation provided by the drawings submitted to the Office of Planning and Zoning and are not intended to be construed as the full new drawings submitted to the Office	
	Chief, Current Planning and Development cc: James Hoswell		REVIEWER: Cart Joseph Willy 7-3 to Approved: W. W. Kamana	of Planning and Zoning and are not intended to be construed as the full extent of any permit. If desired the applicant may obtain additional information by visiting Room 122 of the County Office Building at 111 b. Chesq take Avenue, Towson, Haryland 21204.	
			Planning Group  Fire Prevention Bareau  Special Inspection Division	BYS C. E. Burnhen, Chief Building Flans Review	
			/mt		

5 27 1988

Pursuant to the advertisement, posting of property, and public hearing on the Petition and it appearing that strict compliance with the Eallimore County Zoning Regulations would/would not result in practical difficulty and unreasonable hard in upon the Petitioner(s) and the granting of the variance(s) requested will/will not adversely affect the health, safety, and general welfare of the community, the variance(s) should /should not be granted. Therefore, IT IS OKDERED by the Zoning Commissioner of Baltimore County, this day of \_\_\_\_\_, 19\_\_\_\_, that the herein Petition for Variance(s) to permit BALTIMORE COUNTY, MARYLAND INTER-OFFICE CORRESPONDENCE 1. whether strict compliance with requirement would unrea-IN RE: PETITION ZONING VARIANCE BEFORE THE sonably prevent the use of the property for a permitted Arnold Jablon SE/S of Gunview Road, 672' purpose or render conformance unnecessarily burdensome; TO Zoning Commissioner July 26, 1985 SW of the centerline of ZONING COMMISSIONER Klausmier Road (9413 Gunview 2. whether the grant would do substantial injustice to ap-Norman E. Gerber, Director Road) - 11th Election OF BALTIMORE COUNTY plicant as well as other property owners in the dis-FROM Office of Planning and Zoning District trict or whether a lesser relaxation than that applied Case No. 86-63-A for would give substantial relief; and Peggy A. Smith, et al SUBJECT Zoning Petitions No. 86-62-A, 86-63-A, 86-64-A, 86-65-A, 86-66-A, 785-67-A, 86-68-A, 86-69-A, 86-70-A, 86-73-A, whether relief can be granted in such fashion that the Petitioners spirit of the ordinance will be observed and public and 86-74-A safety and welfare secured. Anderson v. Bd. of Appeals, Town of Chesapeake Beach, 22 Md. App. 28 (1974). FINDINGS OF FACT AND CONCLUSIONS OF LAW It is clear from the testimony that if the variance were granted, such use The Petitioners herein request a variance to permit 14 feet between build-There are no comprehensive planning factors requiring as proposed would not be contrary to the spirit of the BCZR and would not result comment on this petition. ings instead of the required 16 feet and, additionally, to amend the Final Dein substantial detriment to the public good. velopment Plan of Perry Hall Gardens Addition to allow an addition outside of After due consideration of the testimony and evidence presented, it is the building envelope, as more particularly described on Petitioners' Exhibit 1. clear that a practical difficulty or unreasonable hardship would result if the The Petitioner, Patricia Lee Meola, appeared and testified. There were no instant variance were not granted. It has been established that the require-Office of Planning and Joning ment from which the Petitioners seek relief would unduly restrict the use of the Testimony indicated that the subject property, zoned D.R.3.5, is improved NEG:JGH:slm land due to the special conditions unique to this particular parcel. In addiwith the Petitioners' home, which faces Gunview Road. The Petitioners, two tion, the variance requested will not be detrimental to the public health, safewomen, propose to add a 20' x 22' two-car garage on the northern side of their ty, and general welfare. home to provide protection against vandalism to their cars and to protect them-Pursuant to the advertisement, posting of the property, and public hearing selves. Each leaves for work early in the morning and returns usually after on this Petition held, and for the reasons given above, the requested variance dark in the evening. The garage would be outside the envelope and be 14 feet and amendment should be granted. from their neighbor's home instead of the required 16 feet. A driveway already Therefore, IT IS ORDERED by the Zoning Commissioner of Baltimore County, exists on this side of the home. \_\_ day of August, 1985, that the Petition for Zoning Variance to The Petitioners seek relief from Section 1801.2.C.1, pursuant to Section permi 34 feet between buildings instead of the required 16 feet and, addition-307 Baltimore County Zoning Regulations (BCZR). Xally, The amendment to the Final Development Plan of Perry Hall Gardens Addition In area variance may be granted where strict application of the zoning a pw the addition outside of the building envelope be and are hereby regulation would cause practical difficulty to the petitioner and his property. GRANTED, from and after the date of this Order, subject to the following: McLe Ev. Soley, 270 Md. 208 (1973). To prove practical difficulty for an area variance, the petitioner must meet the following: ORDER - 2 en en vertigen en verstret genige – Proposition som som verstrette i de strekte strekte en en strekte i en strekte i PETITION FOR VARIANCE 1. The Petitioners may apply for their building permit and ZONING DESCRIPTION 11th Election District be granted same upon receipt of this Order; however, BEFORE THE ZONING COMMISSIONER RE: PETITION FOR VARIANCE Petitioners are hereby made aware that proceeding at this time is at their own risk until such time as the Begining on the SE. side of Gunview Road 70 feet wide, at the SE/S of Gunview Rd., LOCATION: applicable appellate process from this Order has ex-Southeast side of Gunview Road, 672 ft. Southwest of 672' SW of the Centerline OF BALITIMORE COUNTY distance of 672 feet 5, w. of the centerline of Klausmer Road. Being Lot 29, the centerline of Klausmer Road (9413 Gunview Road) pired. If, for whatever reason, this Order is reof Klausmer Rd. (9413 Block B as shown on Plat 2, Section 1 Perry Hall Gardens Addition and recorded versed, the Petitioners would be required to return, Gunview Rd.), 11th Dist. and be responsible for returning, said property to its among the Land Records of Baltimore County in Plat Book E.H.K., Jr. #42, Folio DATE AND TIME: Monday, August 12, 1985 at 10:15 a.m. PEGGY A. SMITH, et al., : Case No. 86-63-A 65. Also known as 9413 Gunview Road in the 11 th Election District. Peti(ioners PUBLIC HEARING: Room 106, County Office Building, 111 West Chesapeake ::::::: Avenue, Towson, Maryland ENTRY OF APPEARANCE The Zoning Commissioner of Baltimore County, by authority of the Zoning Act and Regulations of Baltimore County, will hold a public hearing: Please enter the appearance of the People's Counsel in the AJ/srl Petition for Variance from Section 1801.2.C.1 to permit 14' between above-captioned matter. Notices should be sent of any hearing dates or buildings in lieu of the required 16' and to amend the Final Development cc: Ms. Patricia Lee Meola Plan of Perry Hall Gardens Addition to allow the home addition outside other proceedings in this matter and of the passage of any preliminary of the building envelope. People's Counsel or final Order. Phyllis Cole Friedman People's Counsel for Baltimore County Being the property of Peggy A. Smith, et al the plat filed with the Zoning Office. In the event that this Petition is granted, a building permit may be issued within the thirty (30) day appeal period. The Zoning Commissioner will, however, entertain any request for a stay of the issuance of said permit during this period for Peter Max Zimmerman good cause shown. Such request must be received in writing by the date of the Deputy People's Counsel hearing set above or made at the hearing. Rm. 223, Court House Towson, MD 21204 BY ORDER OF ARNOLD JABLON ZONING COMMISSIONER I HEREBY CERTIFY that on this 18th day of July, 1985, a copy OF BALTIMORE COUNTY of the foregoing Entry of Appearance was mailed to Peggy A. Smith and Patricia Lee Meola, 9413 Gunview Rd., Baltimore, MD 21236, Petitioners. - 3 <del>-</del>

144

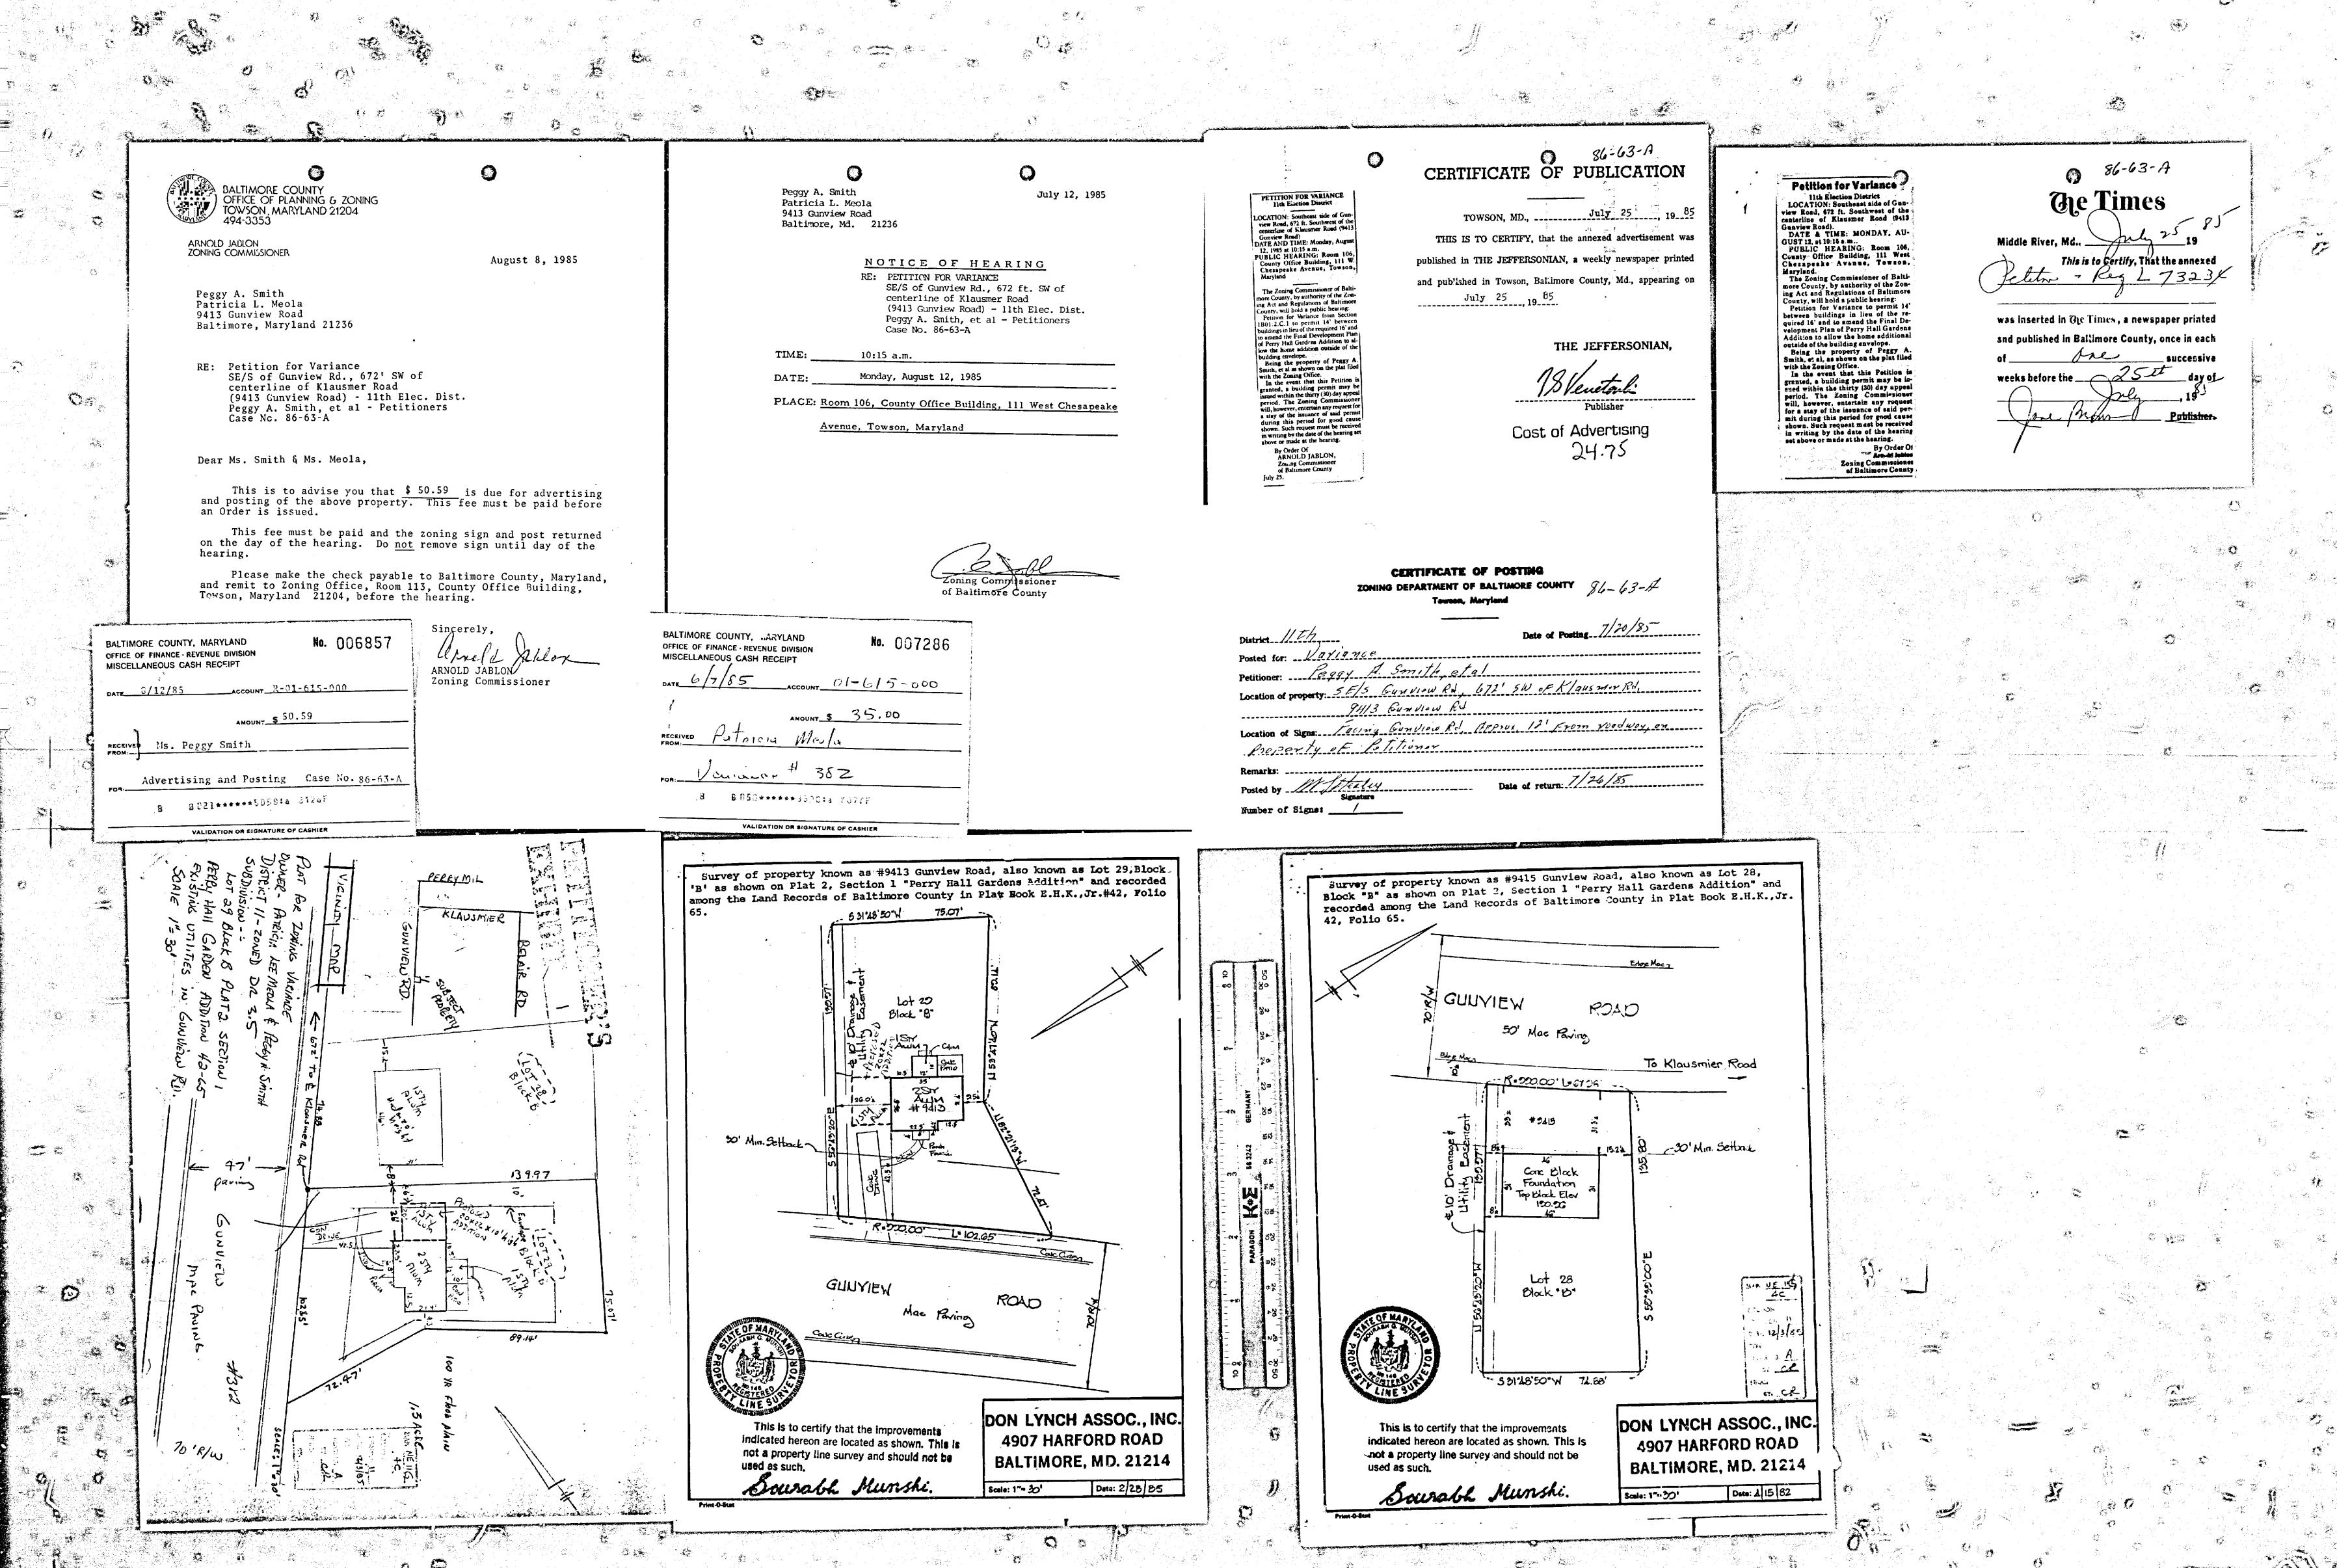

	PETITIC. FOR ZONING VAL.ANCE				
	TO THE ZONING COMMISSIONER OF BALTIMORE COUNTY:				
	The undersigned, legal owner(s) of the property situate in Baltimore County and which is described in the description and plat attached he eto and made a part hereof, hereby petition for a				
	Variance from Section 1 Bol. 2-C.1. to permit 14' between buildings in lieu of the required 16' and to amend the Final Developement Plan of Perry Hall Gardens			전에 가면 가면 보면 보다. (1) 1 1 1 1 1 1 1 1 1 1 1 1 1 1 1 1 1 1	
	Addition to allow the home addition outside of the building envelope.		보다 보고 있는 것이 되었다. 그는 사람들은 사람들이 되었다. 그는 사람들이 되었다. 그는 사람들이 되었다. 그는 사람들이 되었다. 그는 사람들이 되었다. - 사람들이 보고 있는 사람들이 가지를 보고 있다. 그는 사람들이 되었다. 사람들이 되었다. 사람들이 되었다. 사람들이 되었다. 사람들이 되었다.		
	of the Zoning Regulations of Baltimore County, to the Loning Law of Baltimore County; for the following reasons: (indic. hardship or practical difficulty)				
	1. Safety precaution- Two women living alone, both leaving for the				CNOS SINCE
	work in the dark and usually arriving at home at night after dark.				Share and the state of the stat
	2. Protection against vandalism to automobiles.  3. Extra storage space.			BALTIMORE COUNTY DEPARTMENT OF PUBLIC WORKS TOWSON, MARYLAND 21204	
	Tree  DTASTIS. A		BALTIMORE CONSTRUCT	TOWSON, MARYLAND 21204	
	Property is to be posted and advertised as prescribed by Zoning Regulations.		BALTIMORE COUNTY ZONING PLANS ADVISORY COMMITTEE August 5, 1985	HARRY J. PISTEL, P. E. DIRECTOR July 5, 1985	
	I, or we, agree to pay expenses of above Variance advertising, posting, etc., upon filing of this petition, and further agree to and are to be bound by the zoning regulations and restrictions of Baltimore County adopted pursuant to the Zoning Law For Baltimore County.	# 6 W	COUNTY OFFICE BLDG. Ms. Peggy A. Smith		
		$\mathcal{P}_{\mathcal{G}}$	111 W. Chesapeake Ave. Towson, Maryland 21204  Baltimore, Maryland 21236	Mr. Arnold Jablon Zoning Commissioner	
***  ***  ***  ***  ***  ***  ***  ***  ***  ***  ***  ***  **  ***  ***  **	I/We do solemnly declare and affirm, under the penalties of perjury, that I/we are the legal owner(s) of the property which is the subject of this Petition.	$\mathcal{A}$	oDo Nicholas B. Commodari	County Office Building Towson, Maryland 21204	·
	Contract Purchaser: Legal Owner(s):		Chairman RE: Item No. 382 - Case No. 86-63-A Petitioners - Peggy A Smith at all	Re: Item #382 (1984-1985)	
	(Type or Print Name)  (Type or Print Name)	Cuse No. 86-53-A	MEMBERS VARIANCE PETITION	Property Owner: Peggy A. Smith SE/S Gunview Road, 672' S/W from c/l Klausmer Road	victoria de la compania de la compa
	Signature Signature Signature	BALTIMORE COUNTY OFFICE OF PLANNING & ZONING	Dear Ms. Smith:  Department of Traffic Engineering mitted with the above referenced positions. The Internal Committee has reviewed the plans sub-	District 11th	
	Address (Type of Print Name)	County Office Building	are not intended to indicate the postation. The following comments	Dear Mr. Jablon:	
	City and State  City and State  Signature  Signature	111 W. Chesapeake Avenue Towson, Maryland 21204	problems with regard to the development are made aware of plans or	The following comments are furnished in regard to the plat submitted to this office for review by the Zoning Advisory Committee in connection with the subject item.	
	Attorney for Petitioner:	Your petition has been received and accepted for filing this	Health Department on this case. The Director of Planning may file a written report with the Zoning Commissioner with recommendations as to the suitability of	General Comments:	
	(Type or Print Name)  9413 GUUVIEW Rd. 256-098		Building Department Enclosed are all commonts sub-	The Petitioner must provide necessary drainage facilities (temporary or permanent) to prevent creating any nuisances or damages	
	Signature BALTO. Md. 21236	25.0	Zoning Administration petition. If similar comments from the	to adjacent properties, especially by the concentration of surface waters. Correction of any problem which may result, due to improper	
	City and State  Name, address and phone number of legal ourses are	ARNOLD JABLON	informative will be placed in the hearing file. This petition was	grading or improper installation of drainage facilities, would be the full responsibility of the Petitioner.	
	tract purchaser or representative to be contacted	Petitioner Peggy A. Smith, et al Received by	deco. driigiy.	Development of this property through stripping, grading and stabilization could result in a sediment pollution problem, damaging	
	City and State Name	Petitioner's Nicholas B. Commodari Attorney Chairman, Zoning Plans	Very truly yours,  Technical B. Commodan	private and public holdings downstream of the property. A grading permit is, therefore, necessary for all grading, including the	
	Attorney's Telephone No.:  Address Phone No.	Advisory Committee cc: Don Lynch Assoc., Inc., 4907Harford Road, Baltimore, Maryland 21214	NICHOLAS B. COMMODARI	stripping of top soil.  There is an existing 10 foot drainage and utility easement	
	ORDERED By The Zoning Commissioner of Baltimore County, this9th day		Chairman Zoning Plans Advisory Committee	centered along the northernmost property line, 5 feet of this easement falls along the entire property line. The applicant is	
	of a July 19.85., that the subject matter of this petition be advertised, as required by the Zoning Law of Baltimore County, in two newspapers of general circulation throughout Fatimore County, that property be posted, and that the public hearing be had before the Zoning Commissioner of Baltimore County in Room 106, County Office Building in Towson, Baltimore		NBC:nr	cautioned that no permanent construction can be placed over the drainage and utility easement.	
	County on the day of August, 19.85, at 10:15 o'clock		cc: Don Lynch Assoc., Inc.	Very truly yours,	
	G AAM.		4907 Harford Road Baltimore, Maryland 21214	James A. Markle, P.E., Chief	
	Zoning Commissioner of Baltimore County.			Bureau of Public Services  JAM:PMO:blp	
	Zoning Commissioner of Baltimore County.			cc: file	
		13  PAITMOSE COUNTY		BALTIMORE COUNTY	
	ALVINORE COUNTY	DEPARTMENT OF TRAFFIC ENGINEERING TOWSON, MARYLAND 21204 494-3550	BALTIMORE COUNTY FIRE DEPARTMENT TOWSON, MARYLAND 21204-2586 494-4500	BALTIMORE COUNTY DEPARTMENT OF PERMITS & LICENSES July 8, 1985 TOWSON, MARYLAND 21204 494-3610	
	BALTIMORE COUNTY OFFICE OF PLANNING AND ZONING TOWSON, MARYLAND 21204 494-3211	STEPHEN E. COLLINS DIRECTOR	July 2, 1985	<del>-</del>	
	NORMAN E. GERBER DIRECTOR	DIRECTOR  June 26, 1985	PAUL H. REINCKE CHIEF	TED ZALESKI, JR. DIRECTOR	
			Mr. Arnold Jablon Zoning Commissioner	Mr. Armeld Teltan Garden Company	
	Mr. Arnold Jablon  JULY 22, 1985	Mr. Arnold Jablen Zoning Commissioner County Office Building	Office of Planning and Zoning Baltimore County Office Building	Mr. Arnold Jablon, Zoning Commissioner Office of Planning and Zoning Towson, Maryland 21204	
	Zoning Commissioner County Office Building Towson, Maryland 21204	Towson, Maryland 21204 ZAC-Meeting of June 18, 1985	Towson, Maryland 21204  Attention: Nick Commodari, Chairman	Dear Mr. Jablons  Comments on Item # 382 Zoning Advisory Committee Meeting are as follows:	
	Re: Zoning Advisory Meeting of JUNE 18, 1985  Item # 382  Property Owner: PEGGY A. SMITH, et al  Location: SE/SIDE GOVERNOR	Item No. 370,372,373,374,375,376,377,378,379,380,381,382,383, and 384.	Zoning Plans Advisory Committee	Property Owner: Peggy A. Smith, et al  Location: SE/S Gunview Road 672' S/W from c/1 Klausmer Road  District: 11th.	
	a sclaint doublem kp. 64%.	Property Owner:  Location: Existing Zoning:	FL: Froperty Owner: Peggy A. Smith, et al	APPLICABLE EXES ARE CIRCLED:	junite.
	Dear Mr. Jablon:  The Division of Current Planning and Development has reviewed the subject  netition and offers the following corrects. The items should be be be subject	Proposed Zoning:	Item No.: 382  Zoning Agenda: Meeting of June 18 1085	All structures shall conform to the Baltimore County Building Code as adopted by Council Bill #17-85.  
	petition and offers the following comments. The items checked below are applicable.  (X)There are no site planning factors requiring comment.		Item No.: 382 Zoning Agenda: Meeting of June 18, 1985  Gentlemen:	P A building and other miscellaneous permits shall be required before the start of any construction.	
	(* )A County Review Group Meeting is required.  i )A County Review Group meeting was held and the minutes will be forward by the Bureau of Public Services.	Acres:	Pursuant to your request, the referenced property has been surveyed by this	C. Residential: Two sets of construction drawings are required to file a permit application. The seal of a registered in Maryland Architect or Engineer is/is not required on plane and technical data.	
	( )This site is part of a larger tract; therfore it is defined as a subdivision. The plan must show the entire tract. ( )A record plat will be required and must be recorded prior	District:	Bureau and the comments below marked with an "X" are applicable and required to be corrected or incorporated into the final plans for the property.	D. Commercial: Three sets of construction drawings sealed and signed by a registered in Maryland Architect or Engineer shall be required to file with a permit application. Reproduced seals are not acceptable.	
	to issuance of a building permit.  ( )The access is not satisfactory. ( )The circulation on this site is not satisfactory.	Dear Mr. Jablon:	( ) I. Fire hydrants for the referenced property are required and shall be located at intervals or feet along an approved road in accordance with Baltimore County Standards as published by the	E. All Use Groups except R-L Single Family Detached Duellings require a minimum of 1 hour fire rating for	
	( )The parking arrangement is not satisfactory. ( )Parking calculations must be shown on the plan. ( )This property contains soils which are defined as wetlands, and	The Department of Traffic Engineering has no comments for item numbers, 370,372,373,374,375,376,377,378,379,380,381, 382,383, and 384.	accordance with Baltimore County Standards as published by the Lepartment of Public Works.	then 3'-0 to am interior lot line. Any wall built on an interior lot line and interior a case hour wall if closer wall. See Table 801, Section 1807, Section 806.2 and Table 1802. Be openings are permitted in an exterior wall within 3'-0 of am interior lot line.	
	development on these soils is prohibited.  ( )Construction in or alteration of the floodplain is prohibited under the provisions of Section 22-98 of the Development Regulations		( ) 2. A second means of vehicle access is required for the site.	P. The structure does not appear to comply with Table 505 for permissable height/area. Reply to the requested variance by this office cannot be round sered until the necessary data pertaining to height/area and construction type is provided. See Table 501 and 505 and have your Architect/Engineer contact this department.	
	( )Development of this site may constitute a potential conflict with the Baltimore County Master Plan. ( )The amended Development Plan was approved by the Planning Board		( ) 3. The vehicle dead end condition shown at	G. The requested variance appears to conflict with Section(s), of the Baltimore	
	on ( )Landscaping: Must comply with Baltimore County Landscape Manual. ( )The property is located in a deficient service area as defined by	Therefore File	EXCEEDS the maximum allowed by the Fire Department.	Es. When filing for a required change of the to	
	Bill 178-79. No building permit may be issued until a Reserve Capacity Use Certificate has been issued. The deficient service is	Michael S. Flanigan () Traffic Engineering Assoc. II	( ) 4. The site shall be made to comply with all applicable parts of the Fire Prevention Code prior to occupancy or beginning of operation.	be filed along with three sets of acceptable construction plans indicating how the existing structure is to be altered in order to comply with the Code requirements for the new use. Maryland Architectural or Engineer seals are usually required. The change of Use Groups are from Use to Use or or to Mixed Uses Section 312 of the Paulding Code.	
	( )The property is located in a traffic area controlled by a "D" level intersection as defined by Bill 178-79, and as conditions change traffic capacity way become more limited. The Basic Services Areas are re-evaluated annually by the County Council.	M3F/ccm	(X) 5. The buildings and structures existing or proposed on the site shall	I. The proposed project appears to be located in a Flood Plain, Tidel/Riverine. Flease see the attached	
	are re-evaluated annually by the County Council.  ( )Additional comments:		comply with all applicable requirements of the National Fire Protection Association Standard No. 101 "Life Safety Code", 1976 edition prior to occupancy.	and the state there is a state the state of	
			' ) 6. Site plans are approved, as drawn.	It is assumed from the plan submitted the structure proposed is not in the flood plain.	
	Eugene A. Bober		. ) 7. The Fire Prevention Bureau has no comments, at this time.	K. These abbreviated comments reflect only on the formation provided by the drawings submitted to the Office of Planning and Zoning and are not intended to be construed as the full new drawings submitted to the Office	
	Chief, Current Planning and Development cc: James Hoswell		REVIEWER: Cart Joseph Willy 7-3 to Approved: W. W. Kamana	of Planning and Zoning and are not intended to be construed as the full extent of any permit. If desired the applicant may obtain additional information by visiting Room 122 of the County Office Building at 111 b. Chesq take Avenue, Towson, Haryland 21204.	
			Planning Group  Fire Prevention Bareau  Special Inspection Division	BYS C. E. Burnhen, Chief Building Flans Review	
			/mt		

5 27 1988

Pursuant to the advertisement, posting of property, and public hearing on the Petition and it appearing that strict compliance with the Eallimore County Zoning Regulations would/would not result in practical difficulty and unreasonable hard in upon the Petitioner(s) and the granting of the variance(s) requested will/will not adversely affect the health, safety, and general welfare of the community, the variance(s) should /should not be granted. Therefore, IT IS OKDERED by the Zoning Commissioner of Baltimore County, this day of \_\_\_\_\_, 19\_\_\_\_, that the herein Petition for Variance(s) to permit BALTIMORE COUNTY, MARYLAND INTER-OFFICE CORRESPONDENCE 1. whether strict compliance with requirement would unrea-IN RE: PETITION ZONING VARIANCE BEFORE THE sonably prevent the use of the property for a permitted Arnold Jablon SE/S of Gunview Road, 672' purpose or render conformance unnecessarily burdensome; TO Zoning Commissioner July 26, 1985 SW of the centerline of ZONING COMMISSIONER Klausmier Road (9413 Gunview 2. whether the grant would do substantial injustice to ap-Norman E. Gerber, Director Road) - 11th Election OF BALTIMORE COUNTY plicant as well as other property owners in the dis-FROM Office of Planning and Zoning District trict or whether a lesser relaxation than that applied Case No. 86-63-A for would give substantial relief; and Peggy A. Smith, et al SUBJECT Zoning Petitions No. 86-62-A, 86-63-A, 86-64-A, 86-65-A, 86-66-A, 785-67-A, 86-68-A, 86-69-A, 86-70-A, 86-73-A, whether relief can be granted in such fashion that the Petitioners spirit of the ordinance will be observed and public and 86-74-A safety and welfare secured. Anderson v. Bd. of Appeals, Town of Chesapeake Beach, 22 Md. App. 28 (1974). FINDINGS OF FACT AND CONCLUSIONS OF LAW It is clear from the testimony that if the variance were granted, such use The Petitioners herein request a variance to permit 14 feet between build-There are no comprehensive planning factors requiring as proposed would not be contrary to the spirit of the BCZR and would not result comment on this petition. ings instead of the required 16 feet and, additionally, to amend the Final Dein substantial detriment to the public good. velopment Plan of Perry Hall Gardens Addition to allow an addition outside of After due consideration of the testimony and evidence presented, it is the building envelope, as more particularly described on Petitioners' Exhibit 1. clear that a practical difficulty or unreasonable hardship would result if the The Petitioner, Patricia Lee Meola, appeared and testified. There were no instant variance were not granted. It has been established that the require-Office of Planning and Joning ment from which the Petitioners seek relief would unduly restrict the use of the Testimony indicated that the subject property, zoned D.R.3.5, is improved NEG:JGH:slm land due to the special conditions unique to this particular parcel. In addiwith the Petitioners' home, which faces Gunview Road. The Petitioners, two tion, the variance requested will not be detrimental to the public health, safewomen, propose to add a 20' x 22' two-car garage on the northern side of their ty, and general welfare. home to provide protection against vandalism to their cars and to protect them-Pursuant to the advertisement, posting of the property, and public hearing selves. Each leaves for work early in the morning and returns usually after on this Petition held, and for the reasons given above, the requested variance dark in the evening. The garage would be outside the envelope and be 14 feet and amendment should be granted. from their neighbor's home instead of the required 16 feet. A driveway already Therefore, IT IS ORDERED by the Zoning Commissioner of Baltimore County, exists on this side of the home. \_\_ day of August, 1985, that the Petition for Zoning Variance to The Petitioners seek relief from Section 1801.2.C.1, pursuant to Section permi 34 feet between buildings instead of the required 16 feet and, addition-307 Baltimore County Zoning Regulations (BCZR). Xally, The amendment to the Final Development Plan of Perry Hall Gardens Addition In area variance may be granted where strict application of the zoning a pw the addition outside of the building envelope be and are hereby regulation would cause practical difficulty to the petitioner and his property. GRANTED, from and after the date of this Order, subject to the following: McLe Ev. Soley, 270 Md. 208 (1973). To prove practical difficulty for an area variance, the petitioner must meet the following: ORDER - 2 en en vertigen en verstret genige – Proposition som som verstrette i de strekte strekte en en strekte i en strekte i PETITION FOR VARIANCE 1. The Petitioners may apply for their building permit and ZONING DESCRIPTION 11th Election District be granted same upon receipt of this Order; however, BEFORE THE ZONING COMMISSIONER RE: PETITION FOR VARIANCE Petitioners are hereby made aware that proceeding at this time is at their own risk until such time as the Begining on the SE. side of Gunview Road 70 feet wide, at the SE/S of Gunview Rd., LOCATION: applicable appellate process from this Order has ex-Southeast side of Gunview Road, 672 ft. Southwest of 672' SW of the Centerline OF BALITIMORE COUNTY distance of 672 feet 5, w. of the centerline of Klausmer Road. Being Lot 29, the centerline of Klausmer Road (9413 Gunview Road) pired. If, for whatever reason, this Order is reof Klausmer Rd. (9413 Block B as shown on Plat 2, Section 1 Perry Hall Gardens Addition and recorded versed, the Petitioners would be required to return, Gunview Rd.), 11th Dist. and be responsible for returning, said property to its among the Land Records of Baltimore County in Plat Book E.H.K., Jr. #42, Folio DATE AND TIME: Monday, August 12, 1985 at 10:15 a.m. PEGGY A. SMITH, et al., : Case No. 86-63-A 65. Also known as 9413 Gunview Road in the 11 th Election District. Peti(ioners PUBLIC HEARING: Room 106, County Office Building, 111 West Chesapeake ::::::: Avenue, Towson, Maryland ENTRY OF APPEARANCE The Zoning Commissioner of Baltimore County, by authority of the Zoning Act and Regulations of Baltimore County, will hold a public hearing: Please enter the appearance of the People's Counsel in the AJ/srl Petition for Variance from Section 1801.2.C.1 to permit 14' between above-captioned matter. Notices should be sent of any hearing dates or buildings in lieu of the required 16' and to amend the Final Development cc: Ms. Patricia Lee Meola Plan of Perry Hall Gardens Addition to allow the home addition outside other proceedings in this matter and of the passage of any preliminary of the building envelope. People's Counsel or final Order. Phyllis Cole Friedman People's Counsel for Baltimore County Being the property of Peggy A. Smith, et al the plat filed with the Zoning Office. In the event that this Petition is granted, a building permit may be issued within the thirty (30) day appeal period. The Zoning Commissioner will, however, entertain any request for a stay of the issuance of said permit during this period for Peter Max Zimmerman good cause shown. Such request must be received in writing by the date of the Deputy People's Counsel hearing set above or made at the hearing. Rm. 223, Court House Towson, MD 21204 BY ORDER OF ARNOLD JABLON ZONING COMMISSIONER I HEREBY CERTIFY that on this 18th day of July, 1985, a copy OF BALTIMORE COUNTY of the foregoing Entry of Appearance was mailed to Peggy A. Smith and Patricia Lee Meola, 9413 Gunview Rd., Baltimore, MD 21236, Petitioners. - 3 <del>-</del>

144

